

**SOUTH OF WILSHIRE BOULEVARD**

**STREET ADDRESSES**

STREET NAME (DIRECTION)	PAGE	STREET NAME (DIRECTION)	PAGE	STREET NAME	PAGE
<u>ALMONT DRIVE (SOUTH)</u>		<u>CANON DRIVE (SOUTH)</u>		<u>EL CAMINO</u>	
120 - 156	4	120 - 156	13	120 - 152	68
121 - 157	5	121 - 157	14	121 - 153	68
200 - 272	19	200 - 272	28	152 - 264	69
201 - 273	20	201 - 273	29	153 - 265	71
300 - 360	34	300 - 360	43	264 - 344	70
301 - 361	35	301 - 361	44	265 - 345	74
418 - 474	49	401 - 413	59	418 - 474	108
419 - 475	50	418 - 462	58	419 - 463	107
<u>ARNAZ DRIVE (SOUTH)</u>		<u>CARSON ROAD (SOUTH)</u>		<u>ELM DRIVE (SOUTH)</u>	
113 - 201	88+90	125 - 203	94	120 - 156	11
116 - 200	88+90	125 - 227	96	121 - 157	12
129 - 227	89+91	128 - 202	94	200 - 272	26
130 - 228	89+91	128 - 226	96	201 - 273	27
<u>BEDFORD DRIVE (SOUTH)</u>		129 - 227	95	300 - 360	41
120 - 152	78	130 - 226	95	301 - 361	42
121 - 153	78	<u>CHARLEVILLE BOULEVARD</u>		418 - 462	56
152 - 300	79	8736-8742	90	419 - 463	57
201 - 265	84	<u>CLARK DRIVE (SOUTH)</u>		<u>GALE DRIVE (SOUTH)</u>	
264 - 344	80	120 - 156	1	211 - 237	100+101
265 - 345	81	121 - 157	2	212 - 238	100+101
418 - 478	104	200 - 272	16	<u>GREGORY WAY</u>	
419 - 479	103	201 - 273	17	9754-9762	66
<u>BEVERLY DRIVE (SOUTH)</u>		300 - 360	31	<u>HAMEL DRIVE (SOUTH)</u>	
101 - 191	68	301 - 361	32	117 - 201	90+92
106 - 158	15	418 - 474	46	120 - 200	90+92
185 - 273	69	419 - 475	47	129 - 227	91+93
200 - 272	30	<u>CRESCENT DRIVE (SOUTH)</u>		130 - 226	91+93
273 - 353	70	120 - 156	12	<u>HAMILTON DRIVE (SOUTH)</u>	
300 - 352	45	121 - 157	13	203 - 233	99+100
400 - 436	59	200 - 272	27	208 - 234	99+100
401 - 505	109	201 - 273	28	<u>HILLGREEN DRIVE</u>	
<u>BEVERLY GREEN DRIVE</u>		300 - 360	42	468 - 522	109A
1211-1271	109A	301 - 361	43	477 - 521	109A
1256-1270	109A	418 - 462	57	<u>HILLGREEN PLACE</u>	
<u>BEVERWIL DRIVE</u>		419 - 463	58	9795-9809	109A
419 - 479	108	<u>DANIELS DRIVE</u>		9800-9816	109A
420 - 478	109	400 block	105	<u>LACIENEGA BOULEVARD (SOUTH)</u>	
<u>CAMDEN DRIVE (SOUTH)</u>		<u>DOHENY DRIVE (SOUTH)</u>		200 - 294	98+99
120 - 152	72	120 - 156	6	201 - 291	98+99
121 - 153	72	121 - 157	7	300	102
152 - 264	73	200 - 272	21	311 (Wtr.Tmt.Plnt.)	102
153 - 265	76	201 - 273	22		
264 - 344	75	300 - 372	36		
265 - 345	77	301 - 373	37		
345	75	400 - 456	51		
418 - 474	106	401 - 457	52		
419 - 473	105	<u>DURANT DRIVE</u>			
		9865-9901	60		
		9900-9970	61		
		9901-9973	63		

**SOUTH OF WILSHIRE BOULEVARD**

**STREET ADDRESSES**

	<u>PAGE</u>
<u>LAPER DRIVE (SOUTH)</u>	
120 - 156	3
121 - 157	4
200 - 272	18
201 - 273	19
300 - 360	33
301 - 361	34
418 - 474	48
419 - 475	49
<u>LASKY DRIVE</u>	
115 - 133	60
116 - 152	67
153	67
153 - 203	61
200 - 276	64
203 - 277	62
<u>LEDOUX ROAD (SOUTH)</u>	
201 - 227	97+98
202 - 228	97+98
<u>LINDEN DRIVE (SOUTH)</u>	
120 - 152	82
121 - 153	67
152 - 264	86
153 - 265	65
265 - 345	66
264 - 344	87
<u>MAPLE DRIVE (SOUTH)</u>	
120 - 156	9
121 - 157	10
200 - 272	24
201 - 273	25
300 - 360	39
301 - 361	40
418 - 462	54
419 - 463	55
<u>MCCARTY DRIVE</u>	
120 - 152	82
121 - 153	82
152 - 262	83
153 - 265	86
262 - 344	85
265 - 345	87
<u>MORENO DRIVE</u>	
252 - 277	62
<u>OAKHURST DRIVE (SOUTH)</u>	
120 - 156	7
121 - 157	8
200 - 272	22
201 - 273	23
300 - 360	37
301 - 361	38
418 - 462	52
419 - 463	53

	<u>PAGE</u>
<u>OLYMPIC BOULEVARD</u>	
8816-8824	46
8817-8825	31
8832-8856	47
8833-8857	32
8900-8924	48
8901-8925	33
8930-8954	49
8931-8955	34
9000-9024	50
9001-9025	35
9030-9038	51
9031-9039	36
9101-9127	37
9120-9126	52
9134-9158	53
9135-9159	38
9200-9224	54
9201-9225	39
9230-9254	55
9231-9255	40
9300-9324	56
9301-9325	41
9330-9354	57
9331-9355	42
9360-9384	58
9361-9385	43
9400-9414	59
9401-9425	44
9431-9443	45
9460-9500	108
9461-9501	70
9500-9528	107
9501-9537	74
9536-9562	106
9537-9571	75
9570-9594	105
9571-9601	77
9600-9626	104
9601-9625	80
9634-9660	103
9633-9667	81
9667-9691	85
9701-9733	87
9733-9801	66
9750-9880	109A+B
9760-9860	66

	<u>PAGE</u>
<u>PALM DRIVE (SOUTH)</u>	
120 - 156	8
121 - 157	9
200 - 272	23
201 - 273	24
300 - 360	38
301 - 361	39
418 - 462	53
419 - 463	54
<u>PECK DRIVE</u>	
120 - 152	72
121 - 153	78
152 - 264	76
153 - 301	79
264 - 344	77
265 - 345	80
345	77
418 - 458	105
419 - 479	104
<u>REEVES DRIVE</u>	
120 - 156	14
121 - 159	15
200 - 272	29
201 - 273	30
300 - 360	44
301 - 357	45
<u>REXFORD DRIVE (SOUTH)</u>	
120 - 156	10
121 - 157	11
200 - 272	25
201 - 273	26
300 - 360	40
301 - 361	41
418 - 462	55
419 - 463	56
<u>ROBBINS DRIVE</u>	
9900-9956	62
9901-9965	61
<u>ROBERTSON BOULEVARD (SOUTH)</u>	
120 - 200	88
121 - 193	1
192 - 268	89
201 - 293	16
301 - 391	31
401 - 493	46
<u>RODEO DRIVE (SOUTH)</u>	
120 - 152	68
121 - 153	72
152 - 264	71
153 - 265	73
264 - 344	74
265 - 345	75
345	74
417 - 475	106
418 - 446	107

**SOUTH OF WILSHIRE BOULEVARD**

**STREET ADDRESSES**

	PAGE
<u>ROXBURY DRIVE (SOUTH)</u>	
120 - 152	78
121 - 153	82
153 - 265	83
200 - 264	84
264 - 344	81
265 - 345	85
345	81
418 - 478	103
Off BEVERLY GREEN	109A

SANTA MONICA BLVD. (SOUTH) (\*)

(*)	9841-9901	60
(SEE	9844-9900	60
ALSO	9900-9978	63
BOOK	9901-9961	63
#2)		

SHIRLEY PLACE

400 - 426	109A+B
401 - 437	109A+B

SMITHWOOD DRIVE

424 - 460	109
451 - 500	109

SPALDING DRIVE

116 - 152	67
117 - 153	67
152 - 264	65
201 - 285	64
264 - 344	66
400 - 498	109A+B
401 - 499	109A+B

STANLEY DRIVE (SOUTH)

129 - 227	96+97
200 - 226	96+97

SWALL DRIVE (SOUTH)

120 - 156	2
121 - 157	3
200 - 272	17
201 - 273	18
300 - 360	32
301 - 361	33
418 - 474	47
419 - 475	48

TOWER DRIVE

215 - 241	101
216 - 240	101

VIRGINIA PLACE

Bet. Peck/Camden	105
Bet. Rodeo/Camden	106

WETHERLY DRIVE (SOUTH)

	PAGE
120 - 156	5
121 - 157	6
200 - 272	20
201 - 273	21
300 - 360	35
301 - 361	36
413 - 469	51
418 - 474	50

WILLAMAN DRIVE (SOUTH)

121 - 201	92
124 - 200	92
121 - 203	94
124 - 202	94
129 - 227	93+95
130 - 226	93+95

WILSHIRE BOULEVARD (SEE ALSO BOOKS #2&3)

(Actual/overlap)	In sequence	
	8300-8382	101
(8380-)	8382-8446	100
(8440-)	8446-8500	99
(8482-)	8500-8536	98
(8530-)	8536-8600	97
(8566-)	8600-8636	96
(8630-)	8636-8670	94
(8664-)	8670-8700	92
(8692-)	8700-8736	90
(8730-)	8736-8770	88
	8800-8824	1
	8832-8856	2
	8900-8924	3
	8930-8960	4
	9000-9024	5
	9030-9050	6
	9100-9124	7
	9134-9158	8
	9200-9224	9
	9230-9254	10
	9300-9324	11
	9330-9354	12
	9360-9388	13
	9400-9424	14
	9430-9454	15
	9460-9514	68
	9536-9594	72
	9600-9672	78
	9700-9736	82

YOUNG DRIVE

9925-9949 (?9951)	62
9928-9956	62

**SOUTH OF WILSHIRE BOULEVARD**

TRACT NO.	LOT NO.	PAGE NO.	TRACT NO.	LOT NO.	PAGE NO.	TRACT NO.	LOT NO.	PAGE NO.	
3535	15 - 31	109	4988 (continued)	795 - 809	91	6380 (continued)	646 - 664	20	
	32 - 36	108		808 - 830	90		665 - 674	5	
	37 - 41	107		829 - 843	91		675 - 689	6	
	42 - 46	106		844 - 858	89		690 - 708	21	
	47 - 51	105		857 - 883	88		709 - 726	36	
	52 - 56	104		882 - 896	89		727 - 758	51	
	57 - 76	103					759 - 777	36	
	77 - 94	103		6380	1 - 14		1	778 - 796	21
	95 - 110	104			15 - 33		16	797 - 806	6
	116 - 131	104			34 - 52		31	807 - 821	7
	163 - 180	105			53 - 87		46	822 - 840	22
	217	105			88 - 105		31	841 - 859	37
	219 - 251	105			106 - 124		16	860 - 874	52
	232 - 245	106			125 - 134		1	897 - 910	52
	247	106		135 - 149	2	911 - 928	37		
	273	106		150 - 168	17	929 - 947	22		
	275 - 287	106		169 - 187	32	948 - 957	7		
	288 - 307	107		188 - 222	47	958 - 972	8		
	308 - 322	108		223 - 240	32	973 - 991	23		
	328 - 342	108		241 - 259	17	992 - 1010	38		
	343 - 349	109		260 - 269	2	1011 - 1025	53		
	392 - 403	109		270 - 284	3	1049 - 1062	53		
	418 - 423	109		285 - 303	18	1063 - 1080	38		
	424	108		304 - 322	33	1081 - 1099	23		
	427 - 431	106		323 - 357	48	1100 - 1109	8		
	433 - 438	105		358 - 375	33	1110 - 1124	9		
	442	103		376 - 394	18	1125 - 1143	24		
				395 - 404	3	1144 - 1162	39		
4988	477 - 546	101		405 - 419	4	1163 - 1177	54		
	519 - 583	100		420 - 438	19	1201 - 1214	54		
	544 - 618	99		439 - 457	34	1215 - 1232	39		
	604 - 637	98		458 - 492	49	1233 - 1251	24		
	638 - 671	97		493 - 510	34	1252 - 1261	9		
	672 - 708	96		511 - 529	19	1262 - 1276	10		
	709 - 723	95		530 - 539	4	1277 - 1295	25		
	724 - 737	94		540 - 554	5	1296 - 1314	40		
	735 - 749	95		555 - 573	20	1315 - 1329	55		
	750 - 764	93		574 - 592	35	1353 - 1366	55		
	763 - 781	92		593 - 627	50	1367 - 1384	40		
	780 - 794	93		629 - 645	33	1385 - 1403	25		

TRACT LOT PAGE

7710	555 - 571	86
	527 - 554	87
	572 - 574	82
	575 - 577	67
	578 - 594	65
Par. Map 14137	595 - 622	66
	623 - 639	65
	640 - 663	67
(Lots 690, 689, 688) TRACT 41317	664 - 705	64
	706 - 717	67
	718 - 721	60
	722 - 727	63
	728 - 745	63
	746 - 761	60
	762 - 780	63

64

29500	1; 781 - 817	61
17882	1; 818 - 842	62
8982	1 - 16	76
	17 - 48	79
	49 - 80	84
	81 - 96	83
	97 - 112	83
	113 - 128	86

Water Treatment Plant on La Cienega - Page 102

10220		109
10792		91
11143 & 3616	1 - 8	66
"	9 - 67	111 109B
11179	9 - 61	110 109A
11938	1 - 3	7
13546	27 - 29	109A

26043	/	12
32783	/	101
36427	/	82
37280		64
P.M. 12712	/	99

street level

TRACT	LOT	PAGE
3535	15 - 31	109
	32 - 36	108
	37 - 41	107
	42 - 46	106
	47 - 51	105
	52 - 56	104
	57 - 76	103
	77 - 94	103
	95 - 110	104
	116 - 131	104
	163 180	
	<del>165 - 178</del>	105
	217	105
	219 - 231	105
	232 - 245	106
	247	106
	275 - 287	106
	288 - 307	107
	308 - <del>321</del>	108
	328 - 342	108
	343 - <del>348</del>	109
	392 - 403	109
	418 - 423	109
	424	108
	427 - 431	106
	433 - 438	105
4988	<del>442 - 447</del>	103
	477 - 546	101
	519 - 583	100
	544 - 618	99
	604 - 637	98
	638 - 671	97
	672 - 708	96
	709 - 723	95
	724 - 737	94
	735 - 749	95
	750 - 764	93
	763 - 781	92
	780 - 794	93
	795 - 809	91
	808 - 830	90
	829 - 843n	91
	844 - 858	89
	857 - 883	88
	882 - 896	89
6380	1 - 14	1
	15 - 33	16
	34 - 52	31
	53 - 87	46

DO NOT COPY

TRACT	LOT	PAGE
6380	88 - 105	31
	106 - 124	16
	125 - 134	1
	135 - 149	2
	150 - 168	17
	169 - 187	32
	188 - 222	47
	223 - 240	32
	241 - 259	17
	260 - 269	2
	270 - 284	3
	285 - 303	18
	304 - 322	33
	323 - 357	48
	358 - 375	33
	376 - 394	18
	395 - 404	3
	405 - 419	4
	420 - 438	19
	439 - 457	34
	458 - 492	49
	493 - 510	34
	511 - 529	19
	530 - 539	-
	540 - 554	5
	555 - 573	20
	574 - 592	35
	593 - 627	50
	628 - 645	33
	646 - 664	20
	665 - 674	5
	675 - 689	6
	690 - 708	21
	709 - 726	36
	727 - 758	51
	759 - 777	36
	778 - 796	21
	797 - 906	6
	807 - 821	7
	822 - 840	22
	841 - 859	37
	860 - 874	52
	897 - 910	52
	911 - 928	37
	939 - 947	22

TRACT	LOT	PAGE
6380	948 - 957	7
	958 - 972	8
	973 - 991	23
	992 - 1010	38
	1011 - 1025	53
	1049 - 1062	53
	1063 - 1080	38
	1081 - 1099	23
	1100 - 1109	8
	1110 - 1124	9
	1125 - 1143	24
	1144 - 1162	39
	1163 - 1177	54
	1201 - 1214	54
	1215 - 1232	39
	1233 - 1251	24
	1252 - 1261	9
	1262 - 1276	10
	1277 - 1295	25
	1296 - 1314	40
	1315 - 1329	55
	1353 - 1366	55
	1367 - 1384	40
	1385 - 1403	25
	1404 - 1413	10
	1414 - 1428	11
	1429 - 1444	26
	1449 - 1466	41
	1467 - 1481	56
	1505 - 1518	56
	1519 - 1536	41
	1537 - 1555	26
	1556 - 1565	11
	1566 - 1580	12
	1581 - 1599	27
	1600 - 1618	42
	1619 - 1633	57
	1653 - 1666	57
	1667 - 1684	42
	1685 - 1703	27
	1704 - 1713	12
	1714 - 1728	13
	1729 - 1747	28
	1748 - 1766	43
	1767 - 1781	58
	1783 - 1795	58

TRACT	LOT	PAGE
6380	1796 - 1813	43
	1814 - 1832	28
	1833 - 1842	13
	1843 - 1857	14
<del>39363</del>	<del>1</del>	<del>14</del>
	1858 - 1876	29
	1877 - 1895	44
	1896 - 1910	59
	1911 - 1928	44
	1929 - 1947	29
	1948 - 1957	14
	1958 - 1972	15
	1973 - 1991	30
	1992 - 2023	45
	2024 - 2042	30
	2043 - 2052	15
6648	----- 1 - 34	-- 82
	4	--- 41
	35 - 43	-- 67
<del>16802</del>	6649	-----
	1 - 34	-- 68
	45 - 68	-- 72
	69 - 77	-- 78
6935	----- 1 - 3	-- 26
	<del>4 - 34</del>	<del>41</del>
7710	1 - 3	68
	4 - 22	69
	23 - 52	70
	54 - 70	69
	71 - 76	63
	77 - 93	71
	<b>TR. 25321</b>	<b>74</b>
	94 - 121	74
	122 - 138	71
	139 - 141	68
	142 - 144	72
	145 - 161	73
	162 - 189	75
	190 - 206	73
	207 - 212	72
	213 - 229	76
	230 - 257	77
	258 - 274	76
	275 - 277	72
	278 - 290	78
	298 - 325	80
	343 - 365	78
	383 - 410	81
	428 - 433	78
	439 - 441	82
	459 - 486	85
	504 - 509	82

SANITARY SEWERS - HOUSE CONNECTIONS: BOOK #1 - INDEX PAGE 2

**SOUTH OF WILSHIRE BOULEVARD**

TRACT NO.	LOT NO.	PAGE NO.	TRACT NO.	LOT NO.	PAGE NO.	TRACT NO.	LOT NO.	PAGE NO.
6380 (continued)	1404 - 1413	10	6648	1 - 34	82	7710 (continued)	575 - 577	67
	1414 - 1428	11		4	41		578 - 594	65
	1429 - 1444	26		35 - 43	67		595 - 622	66
	1449 - 1466	41	6649	1 - 34	68		623 - 639	65
	1467 - 1481	56		45 - 68	72		640 - 663	67
	1505 - 1518	56		69 - 77	78		664 - 705	64
	1519 - 1536	41	6935	1 - 3	26		706 - 717	67
	1537 - 1555	26		4	41		718 - 721	60
	1556 - 1565	11		7710	1 - 3		68	722 - 727
	1566 - 1580	12	4 - 22		69		728 - 745	63
	1581 - 1599	27	23 - 52		70	746 - 761	60	
	1600 - 1618	42	54 - 70		69	762 - 780	63	
	1619 - 1633	57	71 - 76		68	781 - 817	61	
	1653 - 1666	57	77 - 93		71	818 - 842	62	
	1667 - 1684	42	94 - 121		74	8982	1 - 16	76
	1685 - 1703	27	122 - 138		71		17 - 48	79
	1704 - 1713	12	139 - 141		68		49 - 80	84
	1714 - 1728	13	142 - 144		72		81 - 96	83
	1729 - 1747	28	145 - 161	73	97 - 112		83	
	1748 - 1766	43	162 - 189	75	113 - 128		86	
1767 - 1781	58	190 - 206	73	10220	109			
1783 - 1795	58	207 - 212	72	10792	91			
1796 - 1813	43	213 - 229	76	11143	1 - 8		66	
1814 - 1832	28	230 - 257	77	3616	9 - 67		109B	
1833 - 1842	13	258 - 274	76	11179	9 - 61	109A		
1843 - 1857	14	275 - 277	72	11938	1 - 3	7		
1858 - 1876	29	278 - 280	78	12747		109A		
1877 - 1895	44	298 - 325	80	12844		109A		
1896 - 1910	59	343 - 365	78	13546	27 - 29	109A		
1911 - 1928	44	383 - 410	81	14790	1	59		
1929 - 1947	29	428 - 438	78	16802		68		
1948 - 1957	14	439 - 441	82	17617	1	72		
1958 - 1972	15	459 - 486	85	17882	1	62		
1973 - 1991	30	504 - 509	82	23791	1	7		
1992 - 2023	45	555 - 571	86	25321		74		
2024 - 2042	30	527 - 554	87	26043	1	12		
2043 - 2052	15	572 - 574	82	28207	1	58		
				28718	1	9		
				29500	1	61		
				29685	1	56		
				29698	1	54		





**SOUTH OF WILSHIRE BOULEVARD**

<u>TRACT NO.</u>	<u>LOT NO.</u>	<u>PAGE NO.</u>	<u>TRACT NO.</u>	<u>LOT NO.</u>	<u>PAGE NO.</u>	<u>TRACT NO.</u>	<u>LOT NO.</u>	<u>PAGE NO.</u>
30927	1	101						
31324	1	67						
31364	1	9						
31578	1	64						
31579	1	55						
31602	1	100) 101)						
31636	1	30						
31639	1	64						
31731		11						
31776	1	42						
31813	1	66						
31840		109A						
31883	1	8						
32783	1	101						
36427	1	82						
37280		64						
39342		103						
39363	1	14						
41317	688 - 690	64						

PARCEL MAP

12587	1	7
12712	1	99
14137		66

LOT SPLIT 12 109A

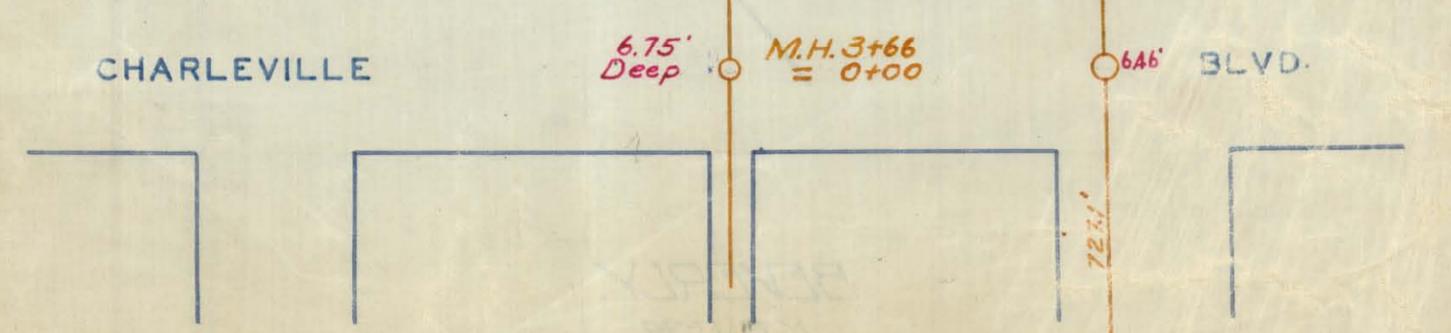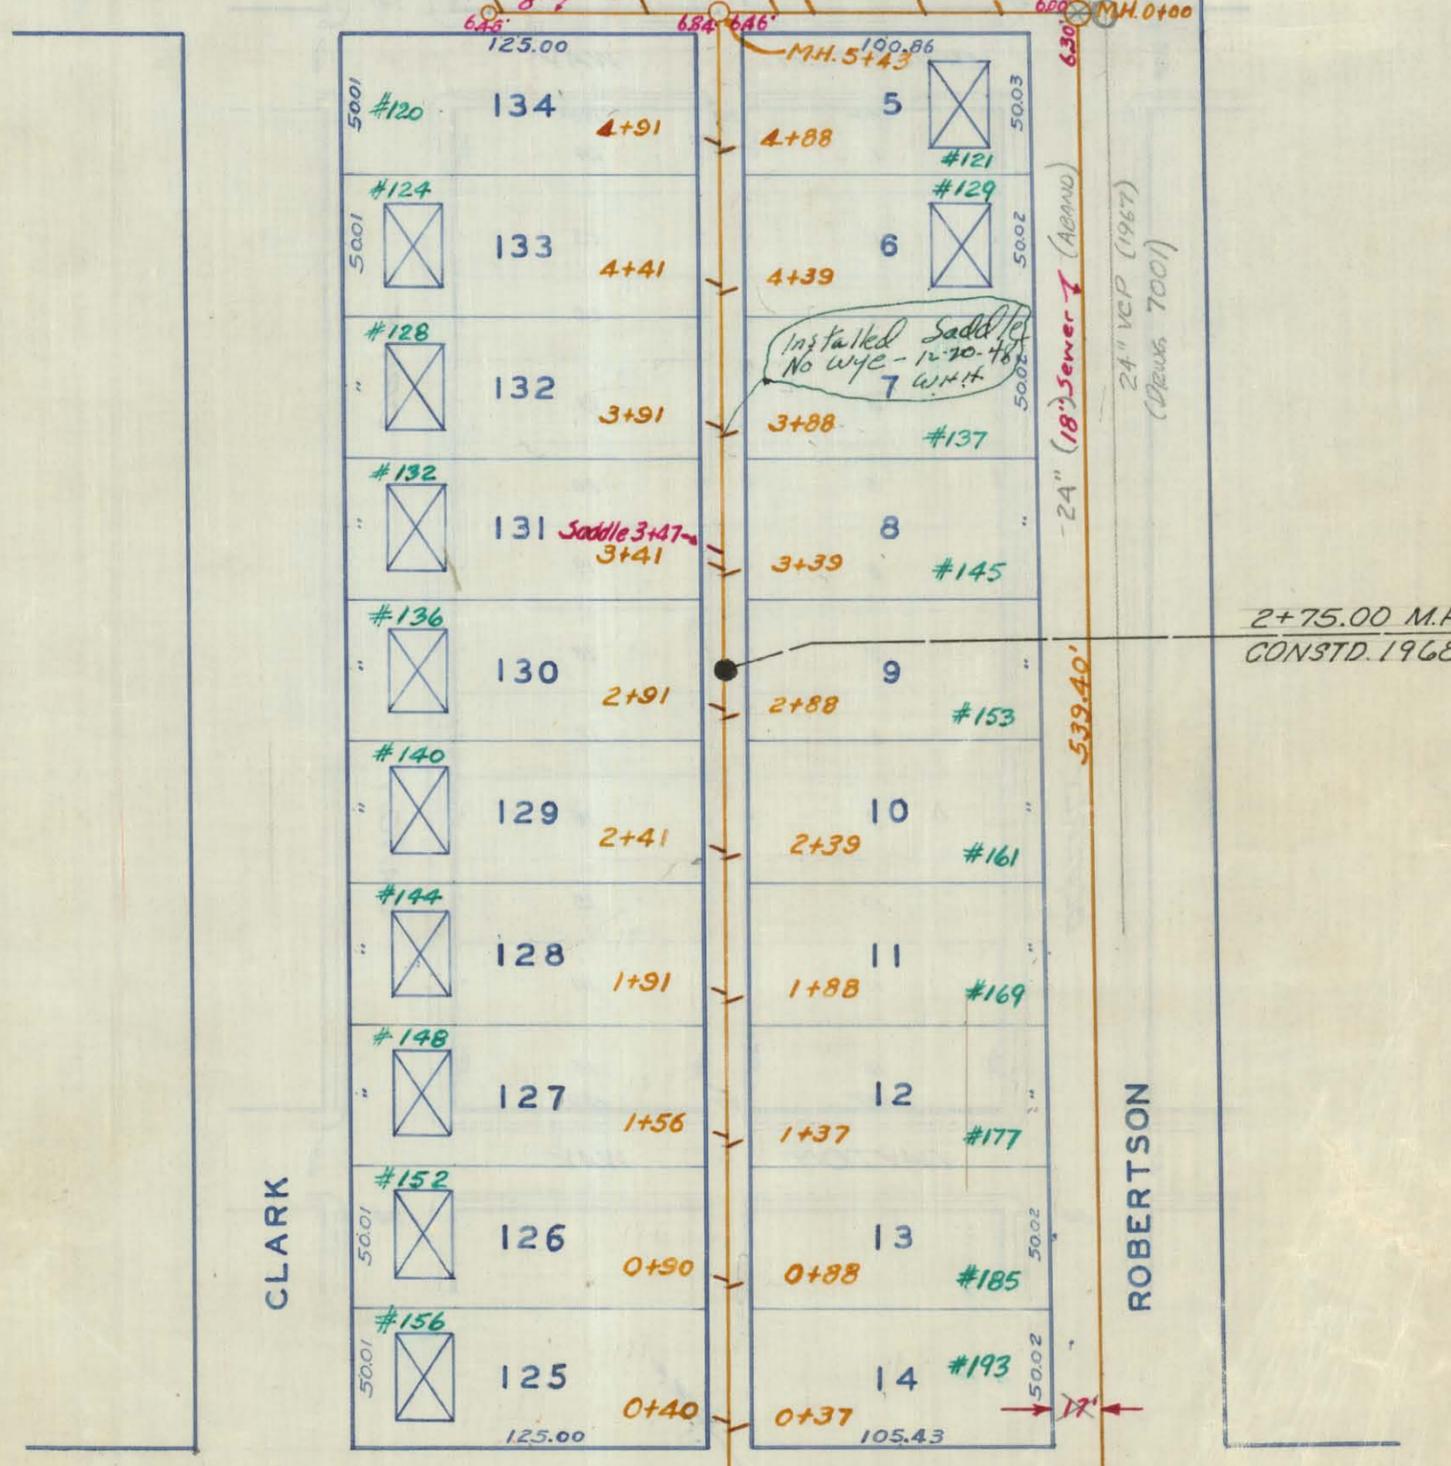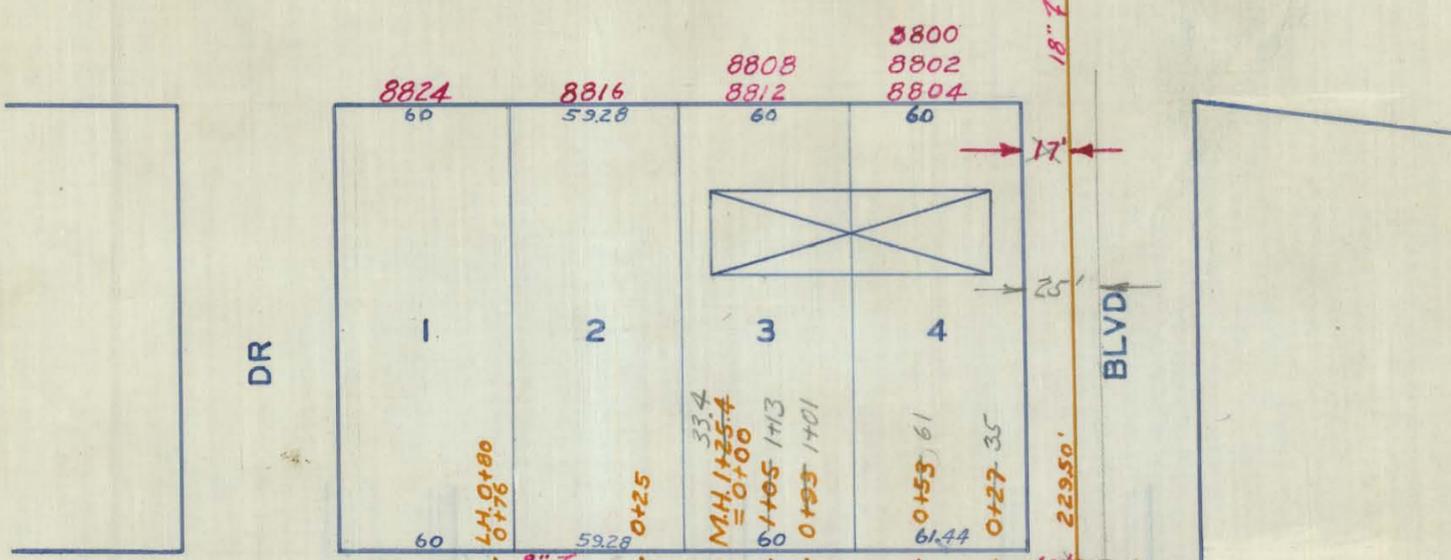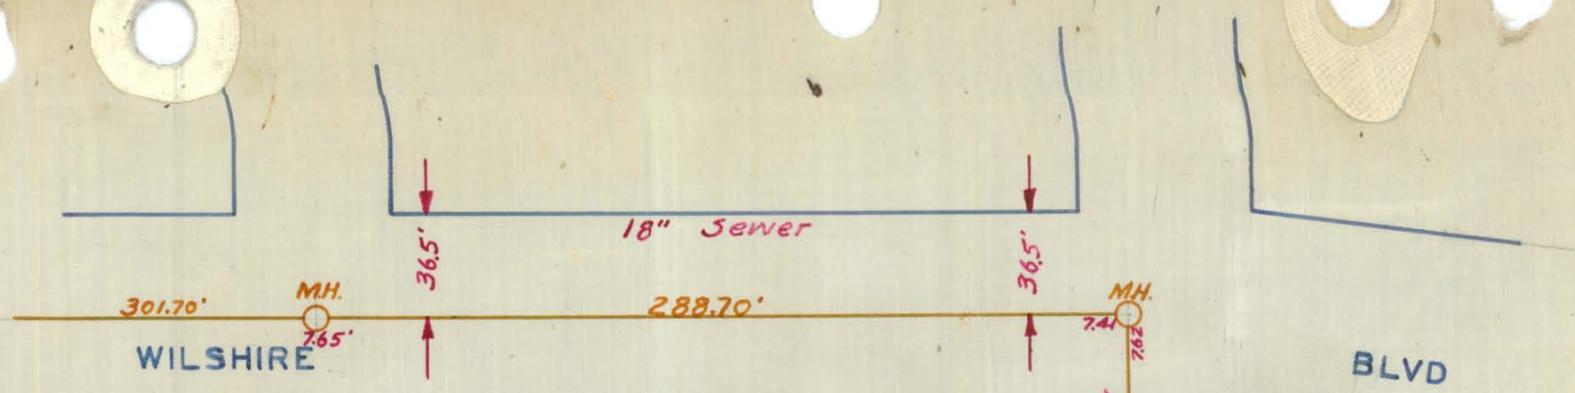


① TRACT 6380

2+75.00 M.H.  
CONSTD. 1968

Installed Saddle  
No Wye - 12-20-78  
7 W.H.

Installed grade  
51' west of M.H. 10-9-A

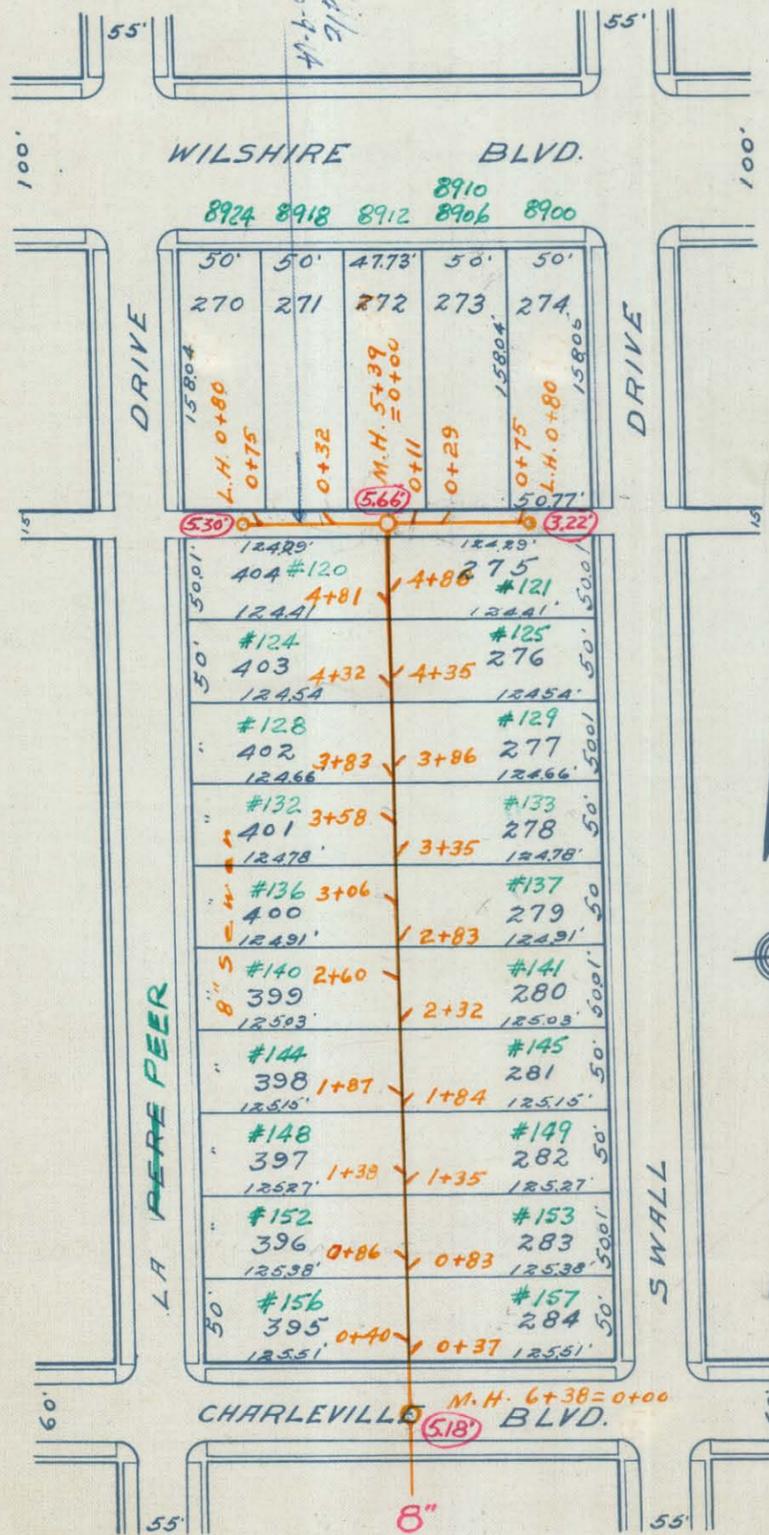


CITY OF BEVERLY HILLS  
TRACT 6380

M.B. 69-11-20  
SCALE 1 inch = 100 ft.  
1926

3

3

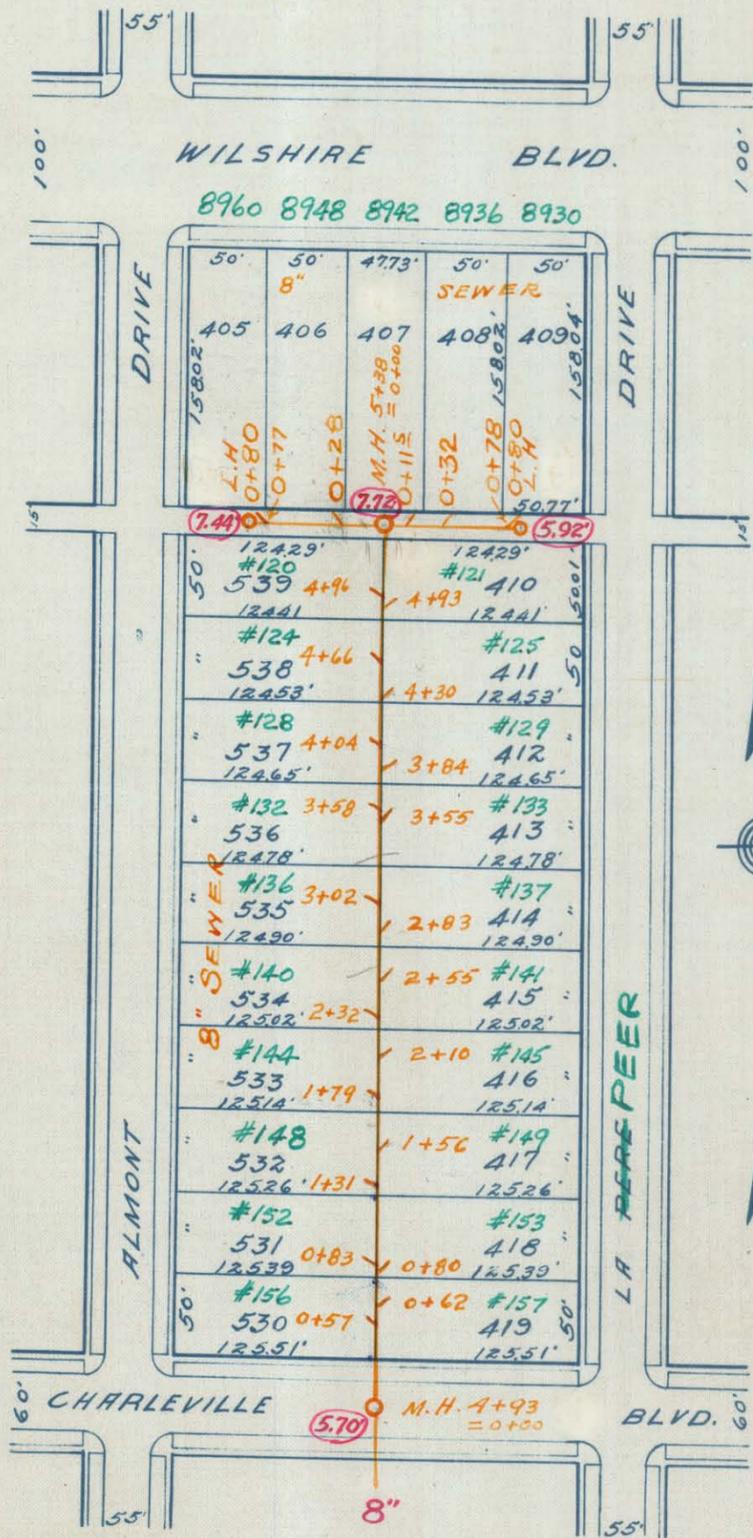


CITY OF BEVERLY HILLS  
 TRACT 6380  
 M.B. 69-11-20  
 SCALE 1 inch = 100 ft.

1926

4

14  
 25  
 70  
 21  
 119

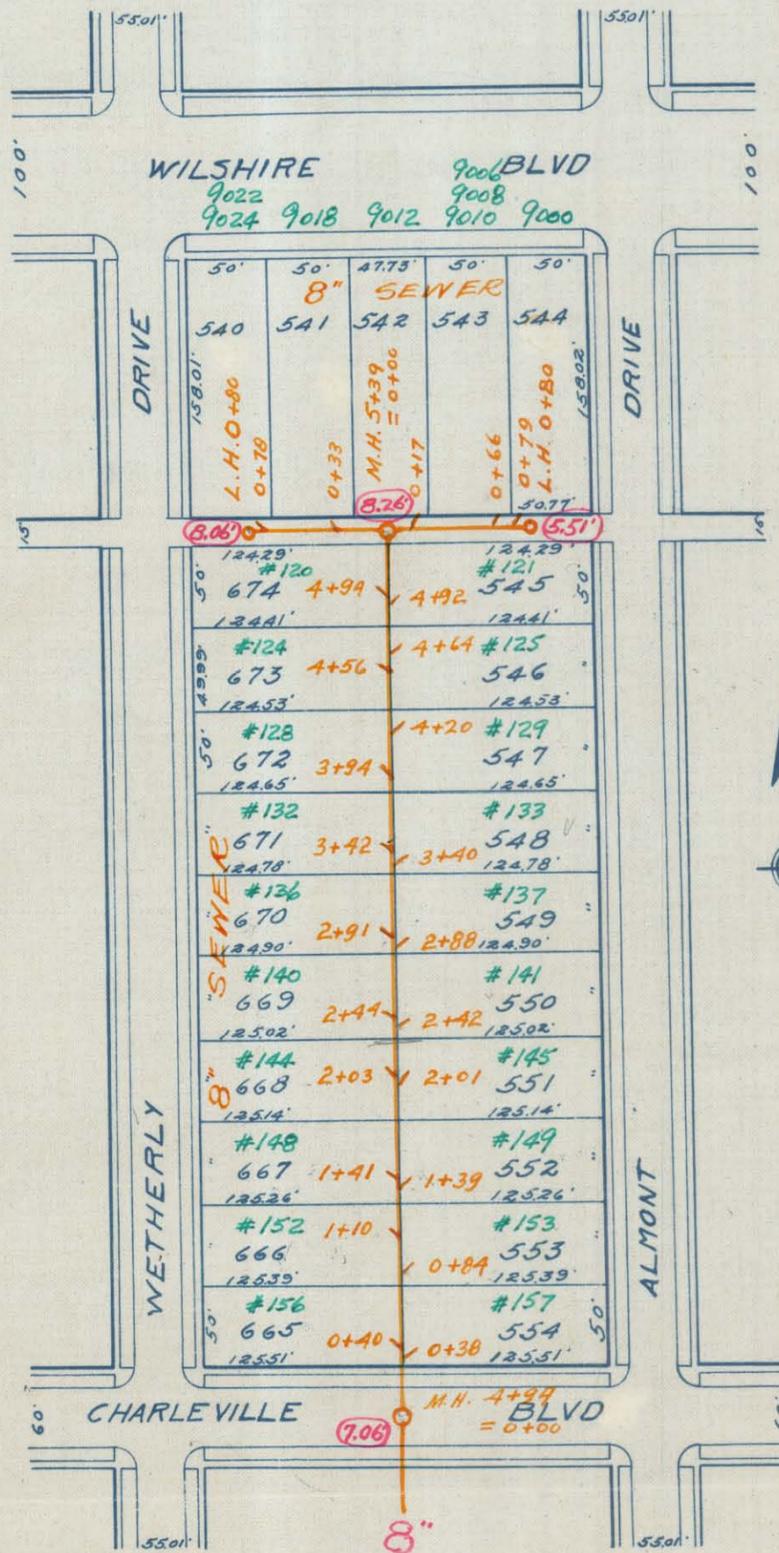

CITY OF BEVERLY HILLS

TRACT 6380


M.B. 69-11-20

SCALE 1"=100'

1926

5


*sewer has been disconnected... 13' by  
 moved away... 1 length of pipe taken  
 off from P.L. in... and pipe plugged  
 up in place as not connected with  
 sewer main. - Dec 20/22 C.M.R.*

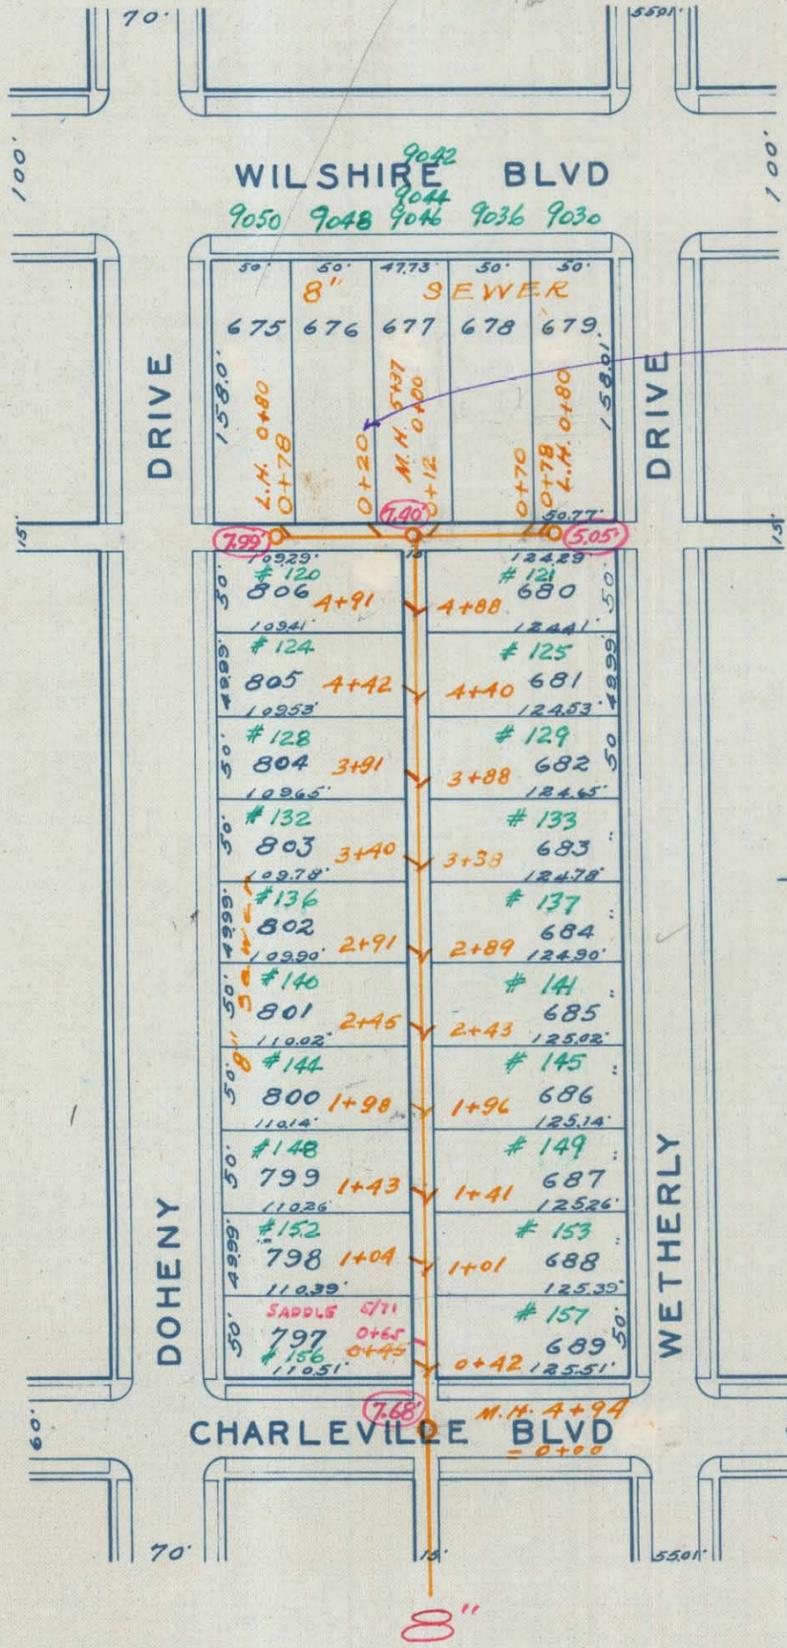

*#9090 WILSHIRE (HOLLOW)  
 RE-CONNECT. 11/86  
 NEW M.D.G.  
 (THIS ONLY HC FOR  
 P. RESURFACE)*

CITY OF BEVERLY HILLS  
 TRACT 6380  
 M. B. 69-11-20  
 SCALE 1"=100'  
 1926

6

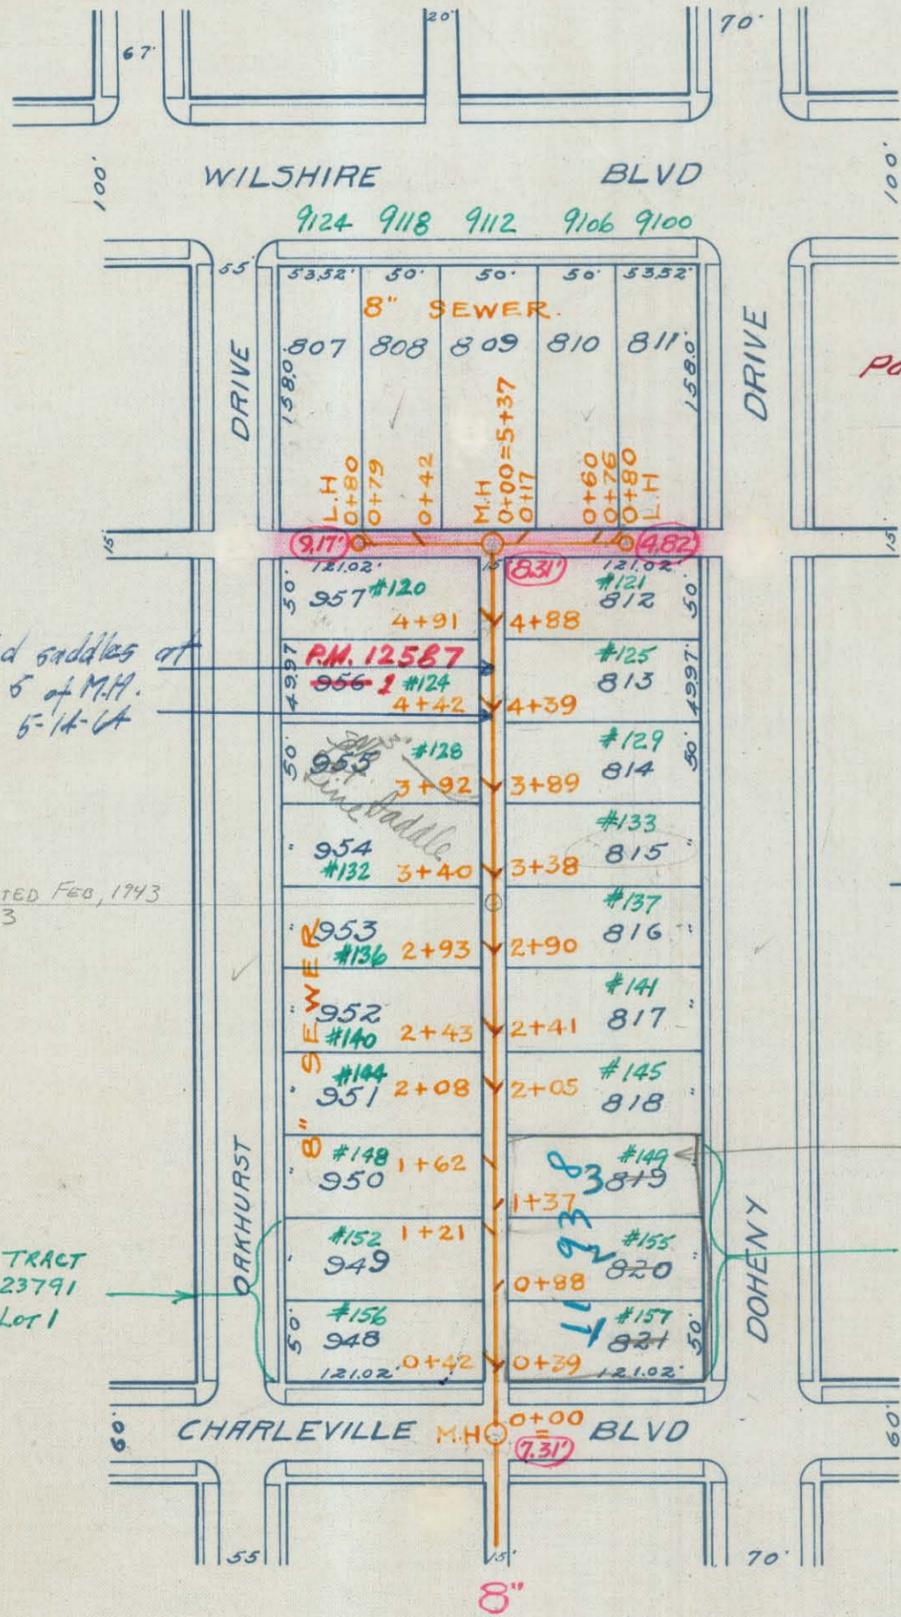

Pave: Cross Alley only - 5" A.C.  
Services to R

Installed saddles at  
73' + 102' 5" of M.H.  
5-14-64


M.H. CONSTRUCTED FEB, 1943  
STN 3+23

TRACT # 23791  
Lot 1

537  
538  
199


CITY OF BEVERLY HILLS  
TRACT 6380  
M.B 89-11-20  
SCALE 1"=100'  
1926

7

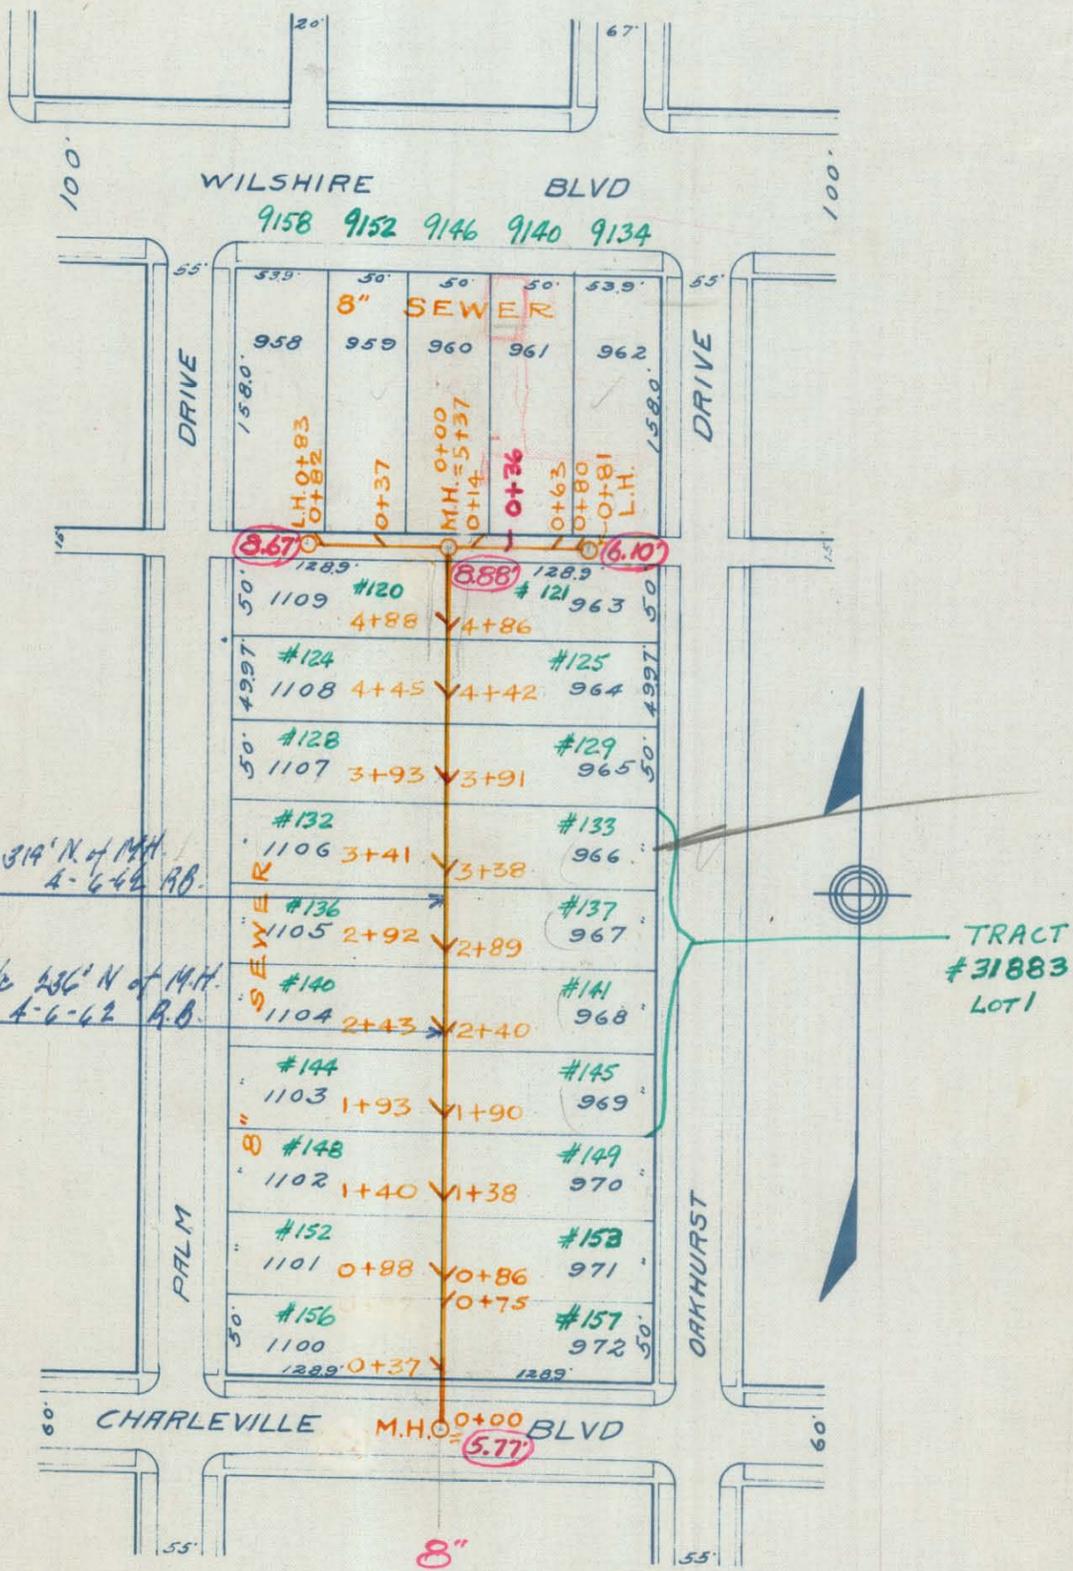


CITY OF BEVERLY HILLS  
TRACT 6380  
M.B. 69-11-20  
SCALE 1"=100'

8

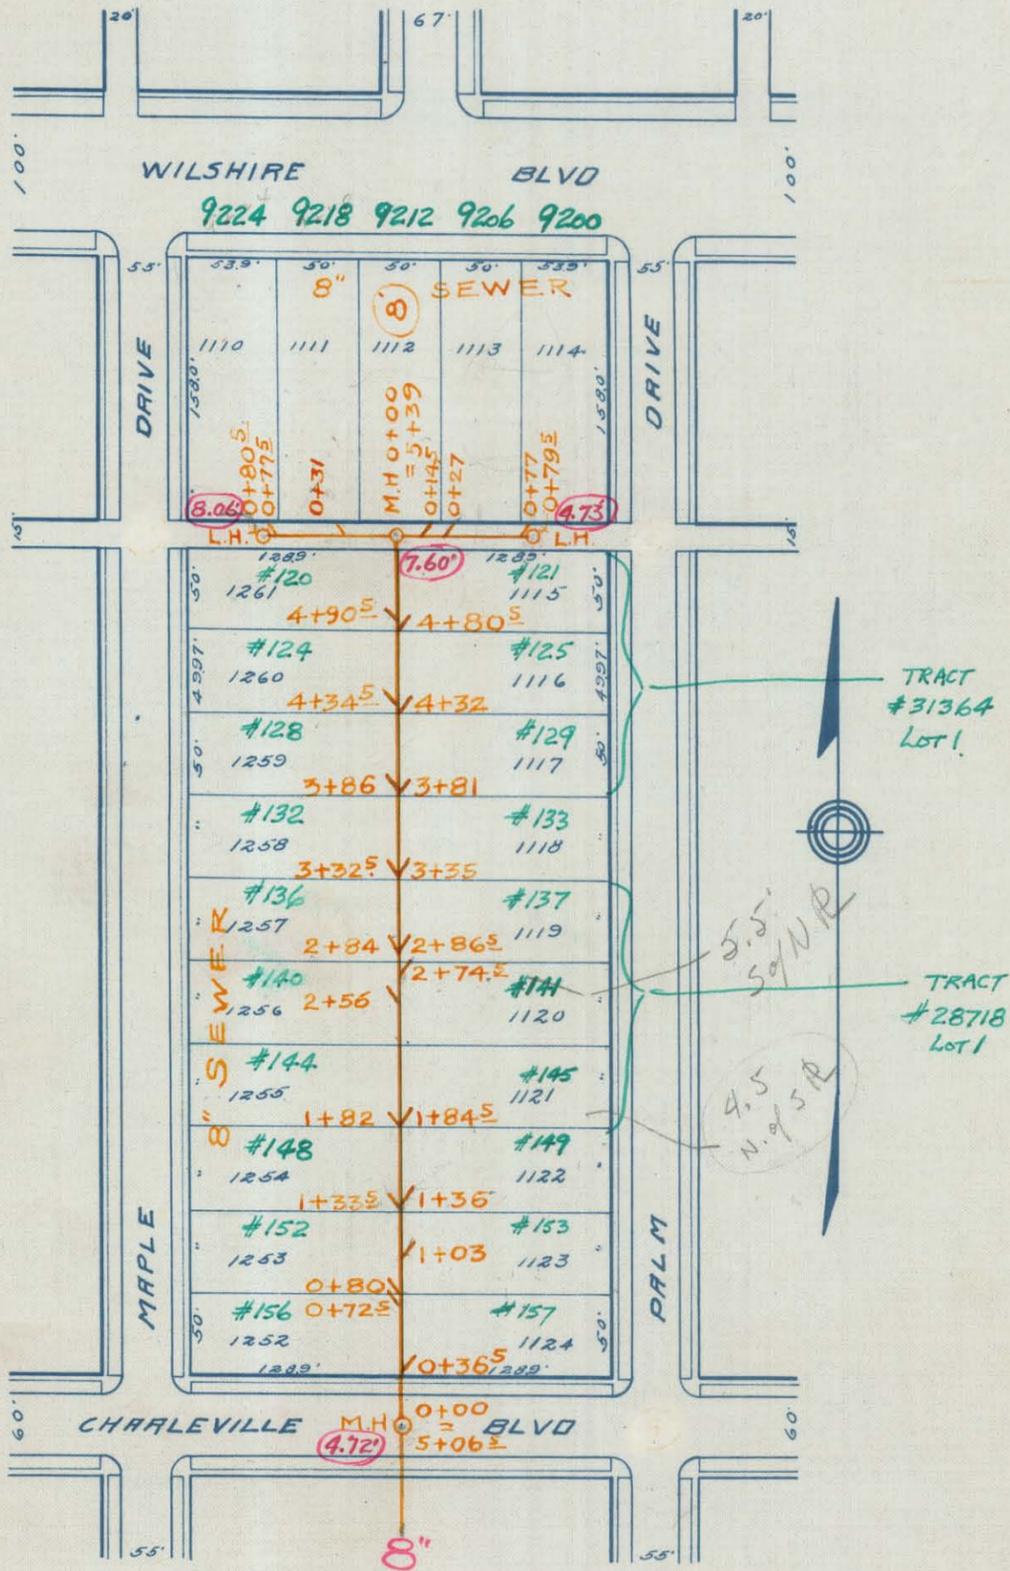

CITY OF BEVERLY HILLS  
 TRACT 6380  
 M. B. 69-11-20  
 SCALE 1"=100'  
 1926

9

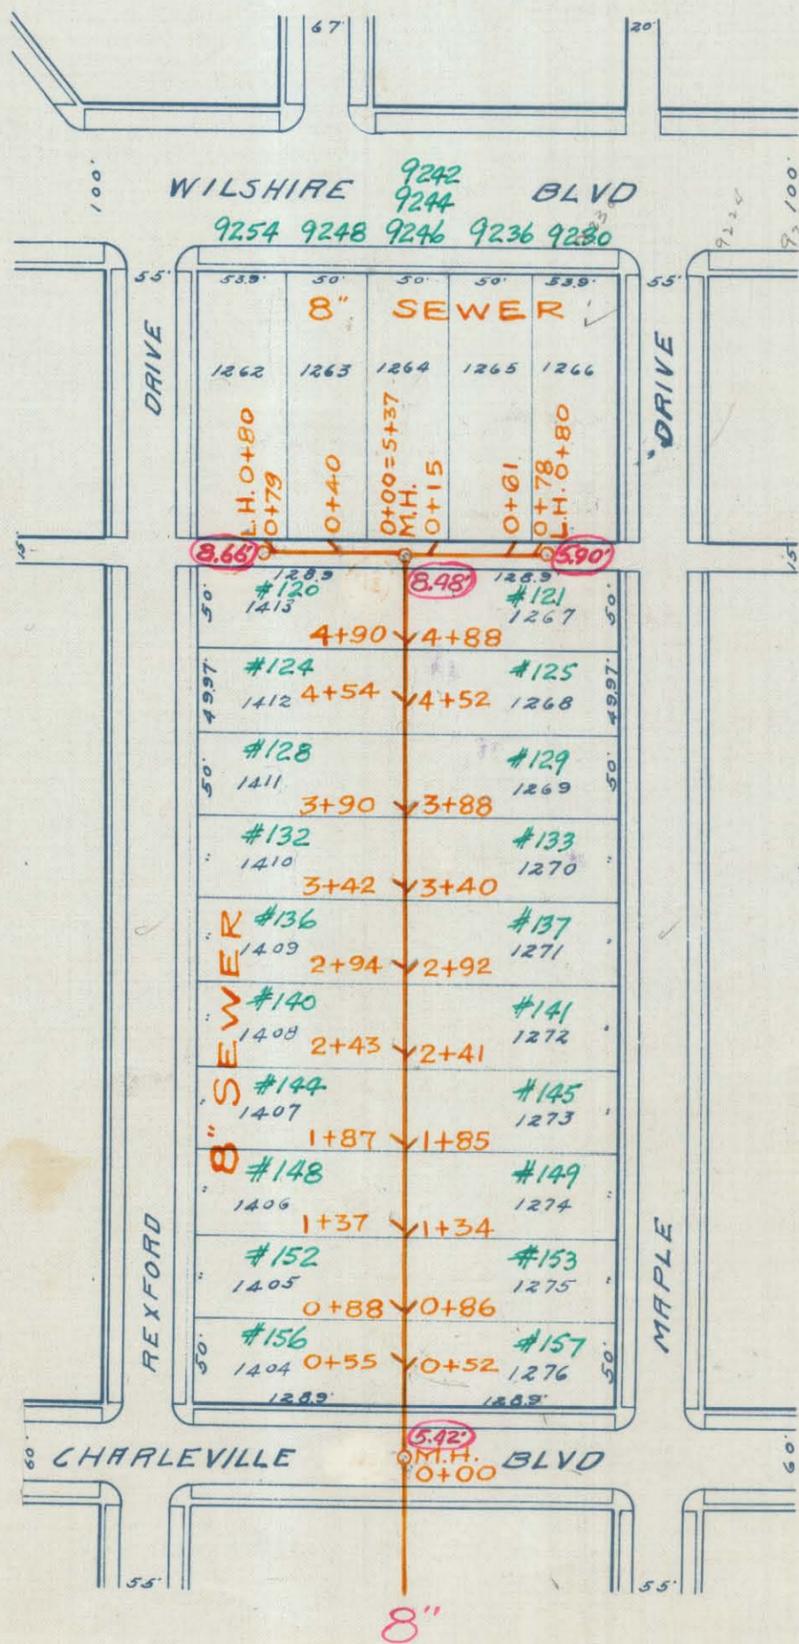

CITY OF BEVERLY HILLS


TRACT 6380

M.B. 69-11-20

SCALE 1"=100'

-1926-


10

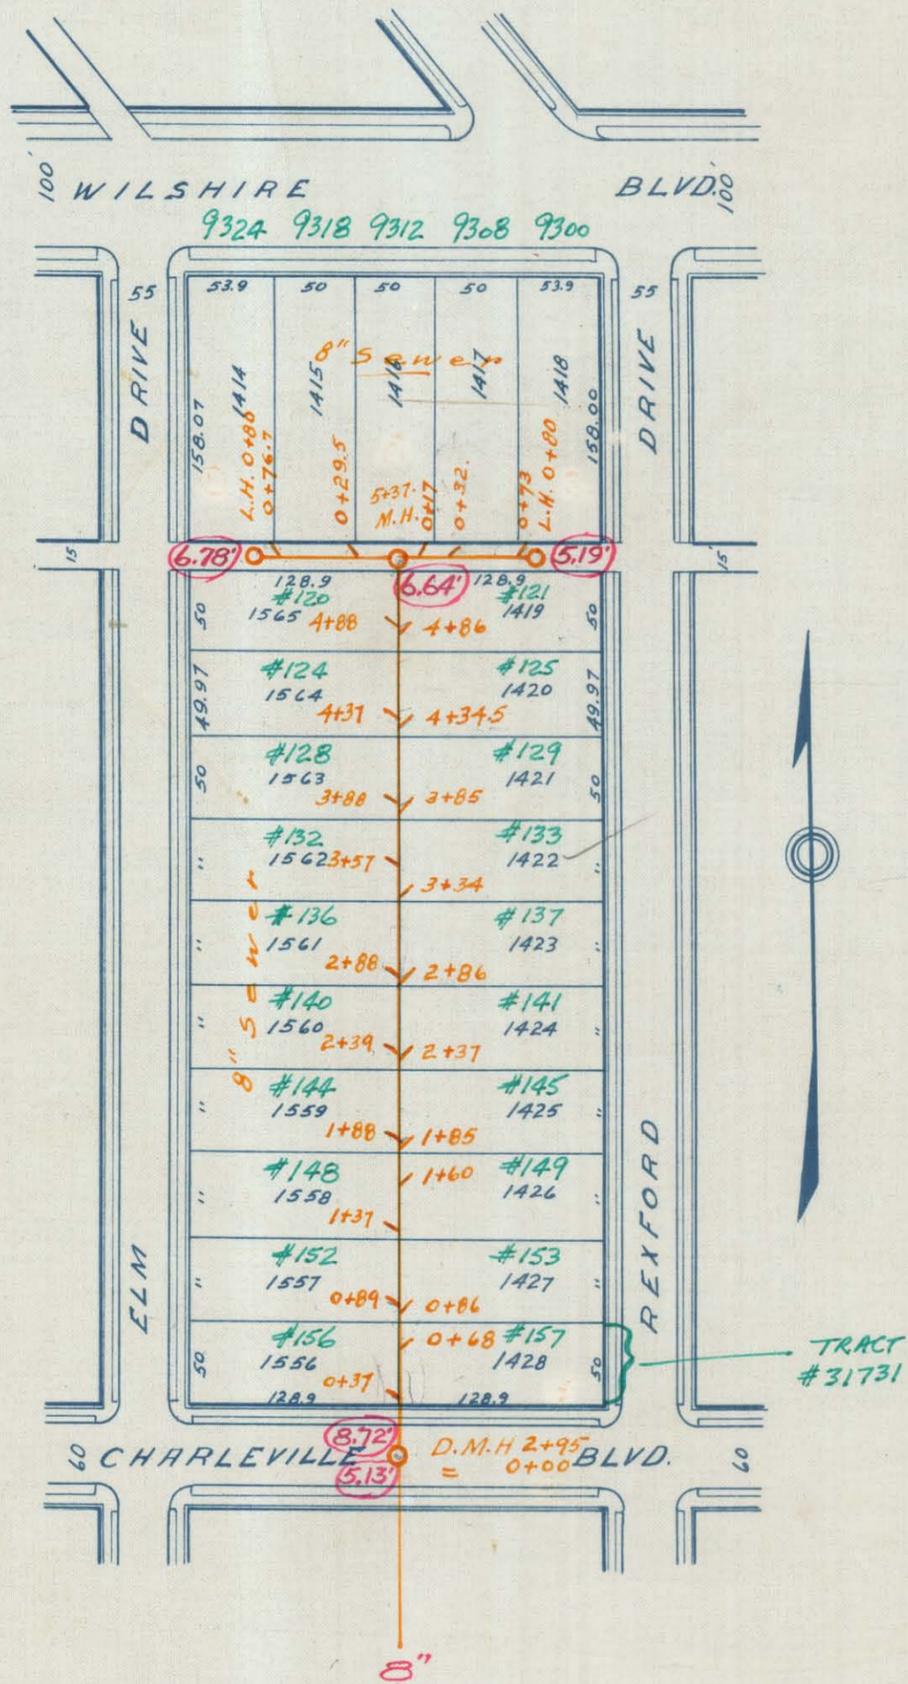

CITY OF BEVERLY HILLS

TRACT 6380

M.B. 69-11-20  
 SCALE 1 inch = 100 ft  
 1926

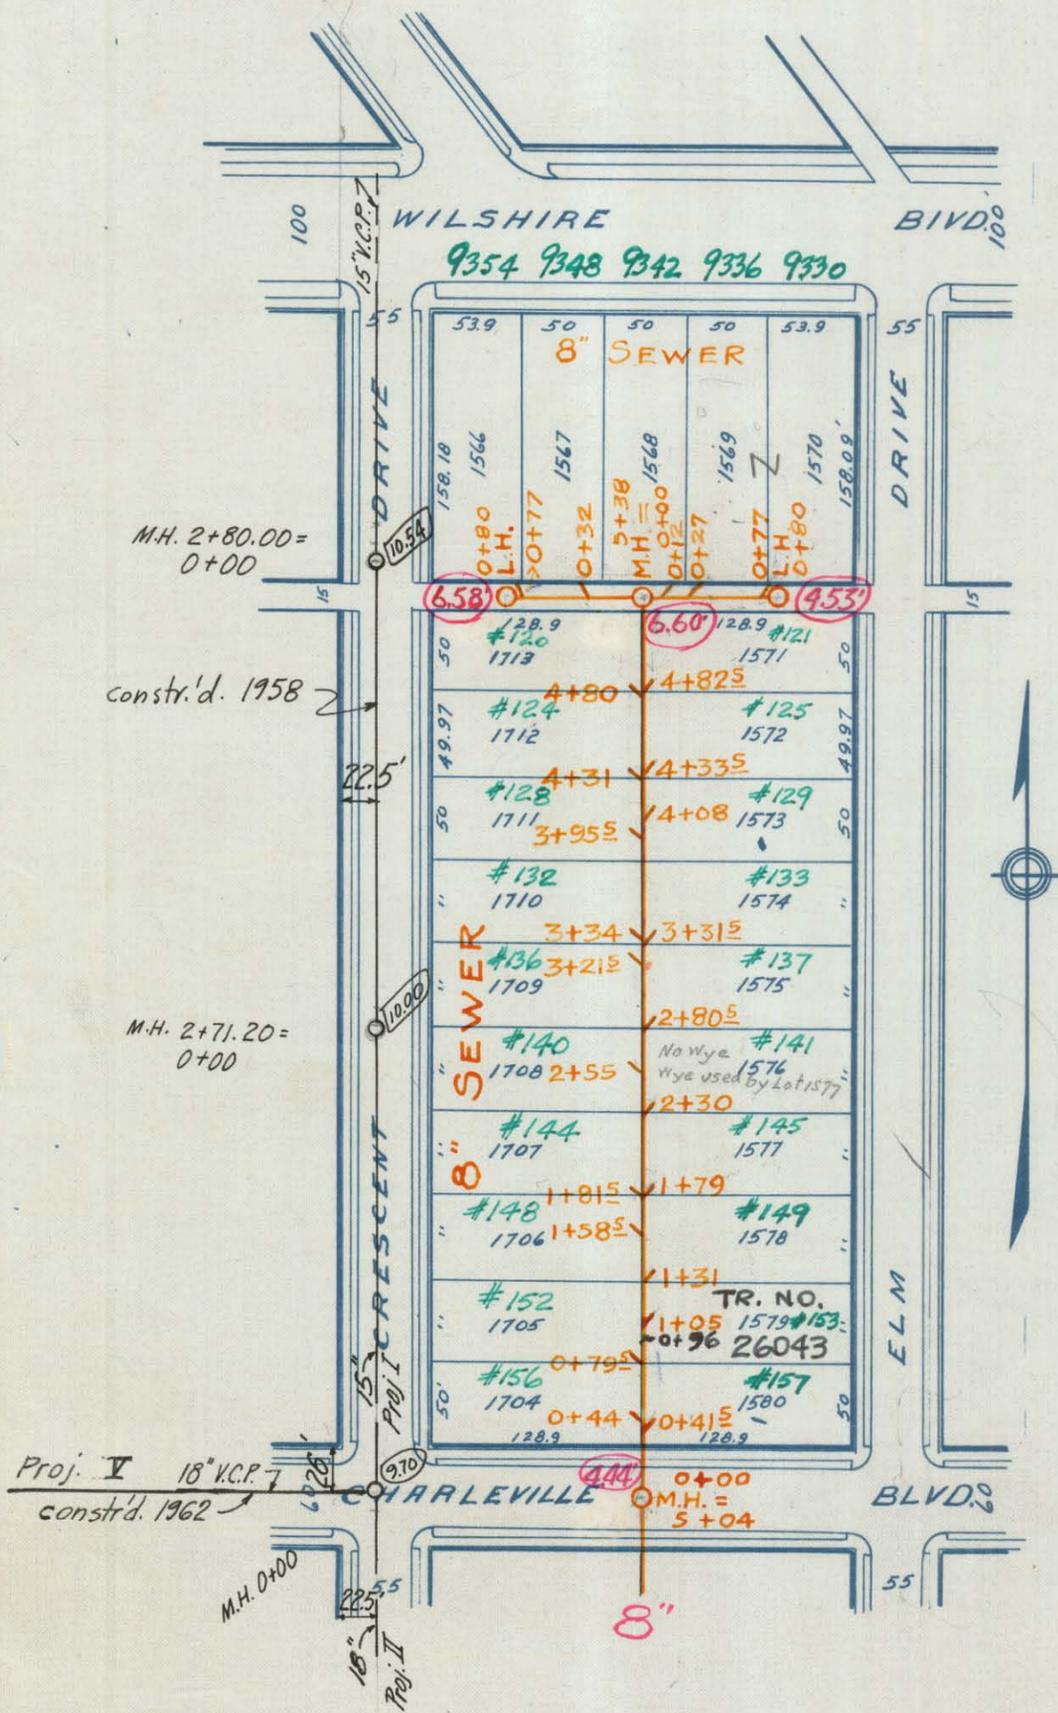


CITY OF BEVERLY HILLS

TRACT 6380

M.B. 69-11-20  
SCALE 1 inch = 100 ft.

-1926-



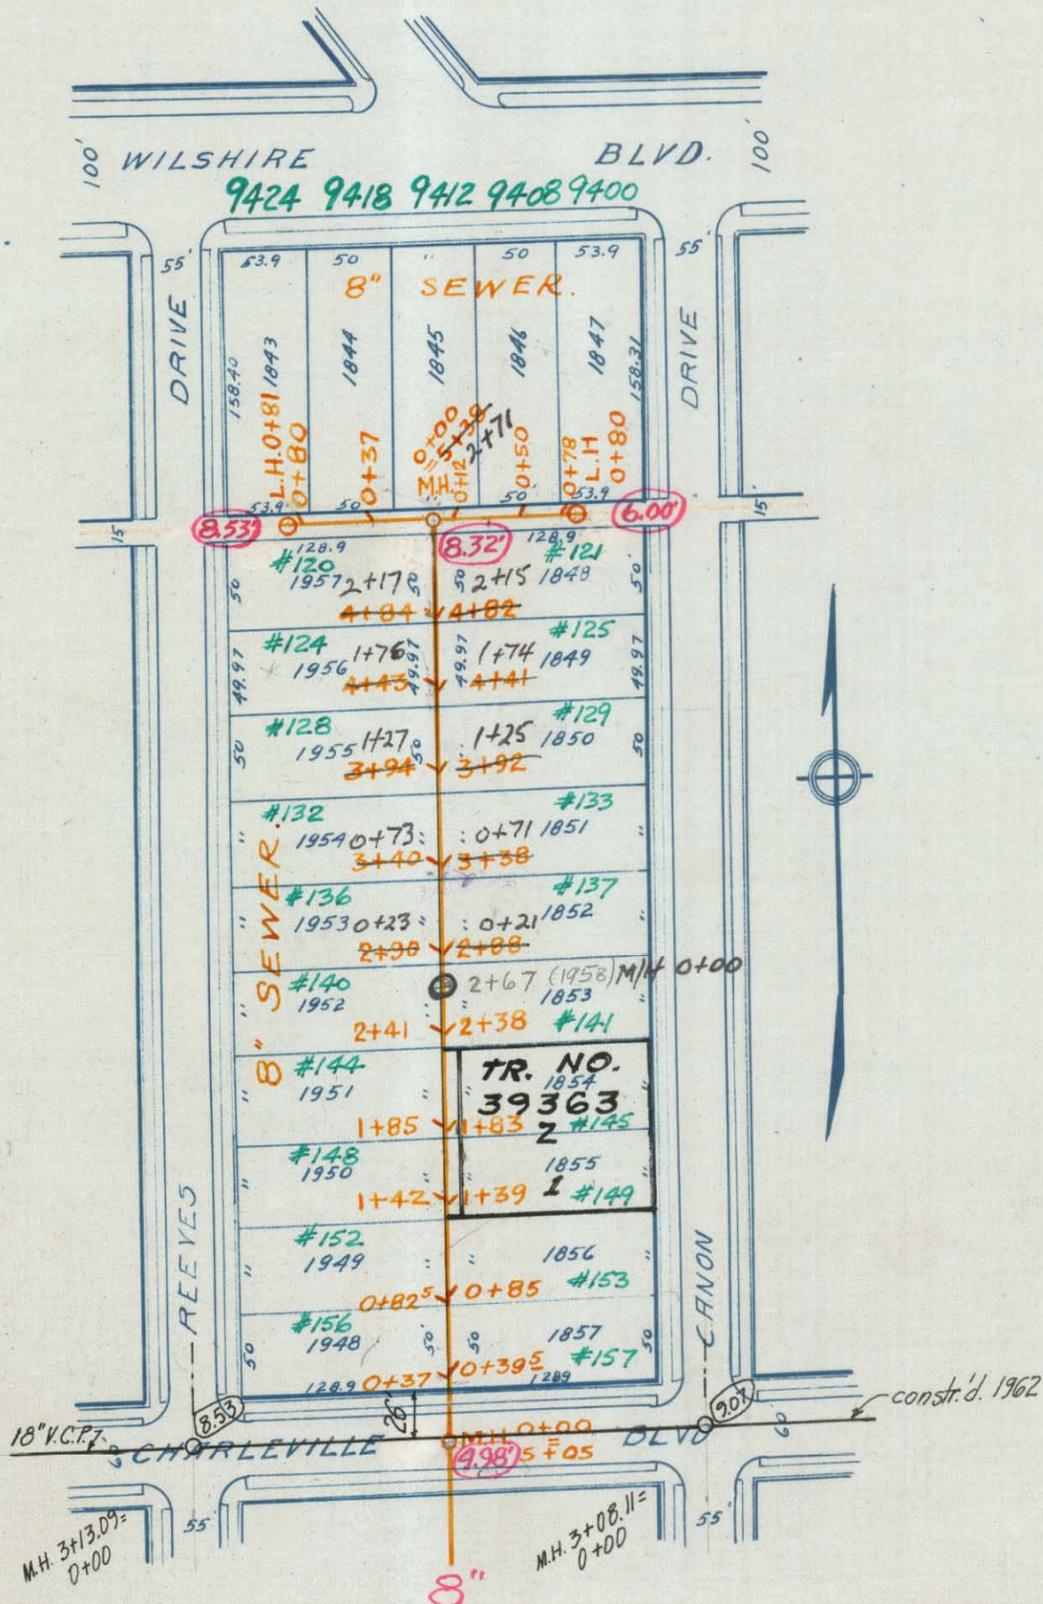


271  
2525  
13.5

CITY OF BEVERLY HILLS  
TRACT 6380  
M.B. 69-11-20  
SCALE 1"=100'  
1926

14






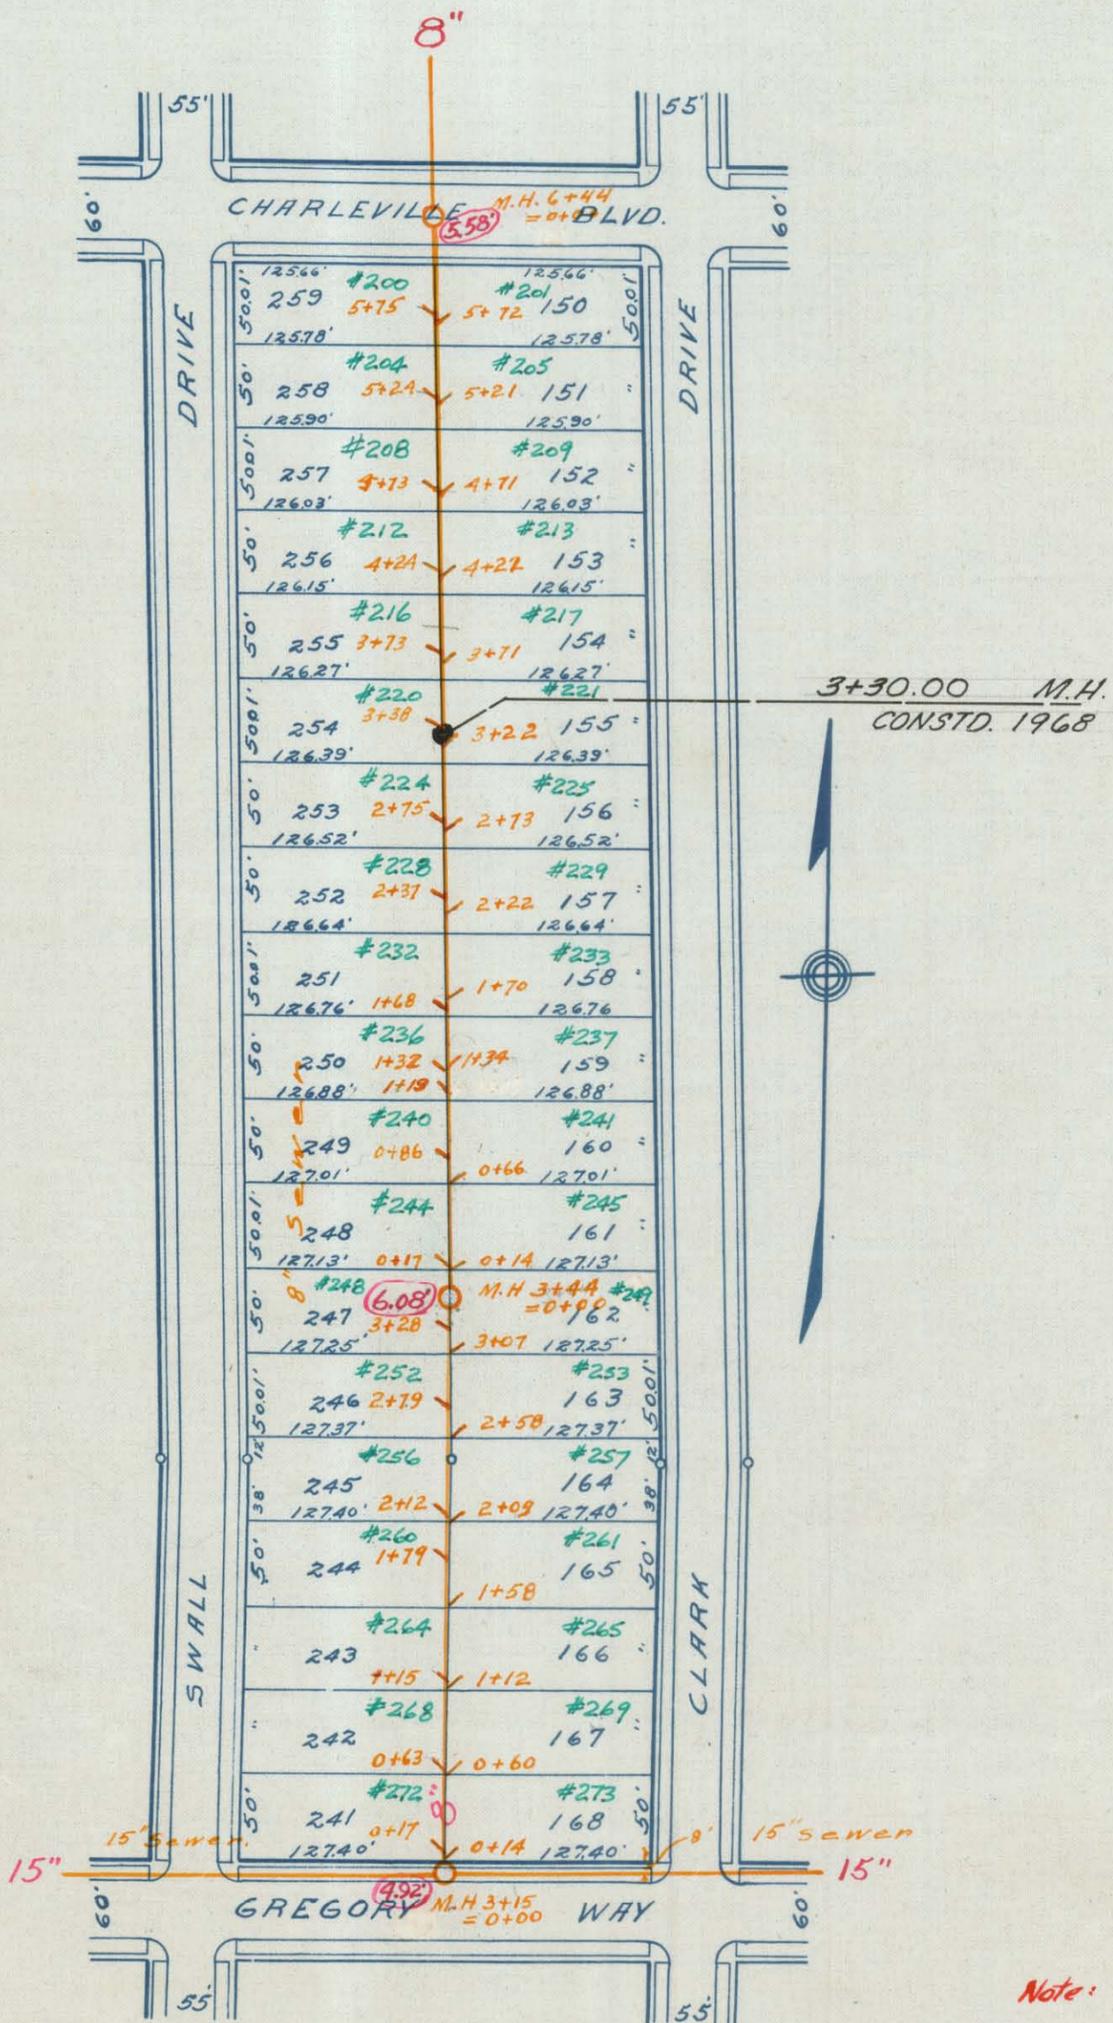

Note: No Saddles  
on 15" line along  
Gregory Way.

CITY OF BEVERLY HILLS  
TRACT 6380  
M.B. 69-11-20  
SCALE 1 inch = 100 ft.  
1926

17

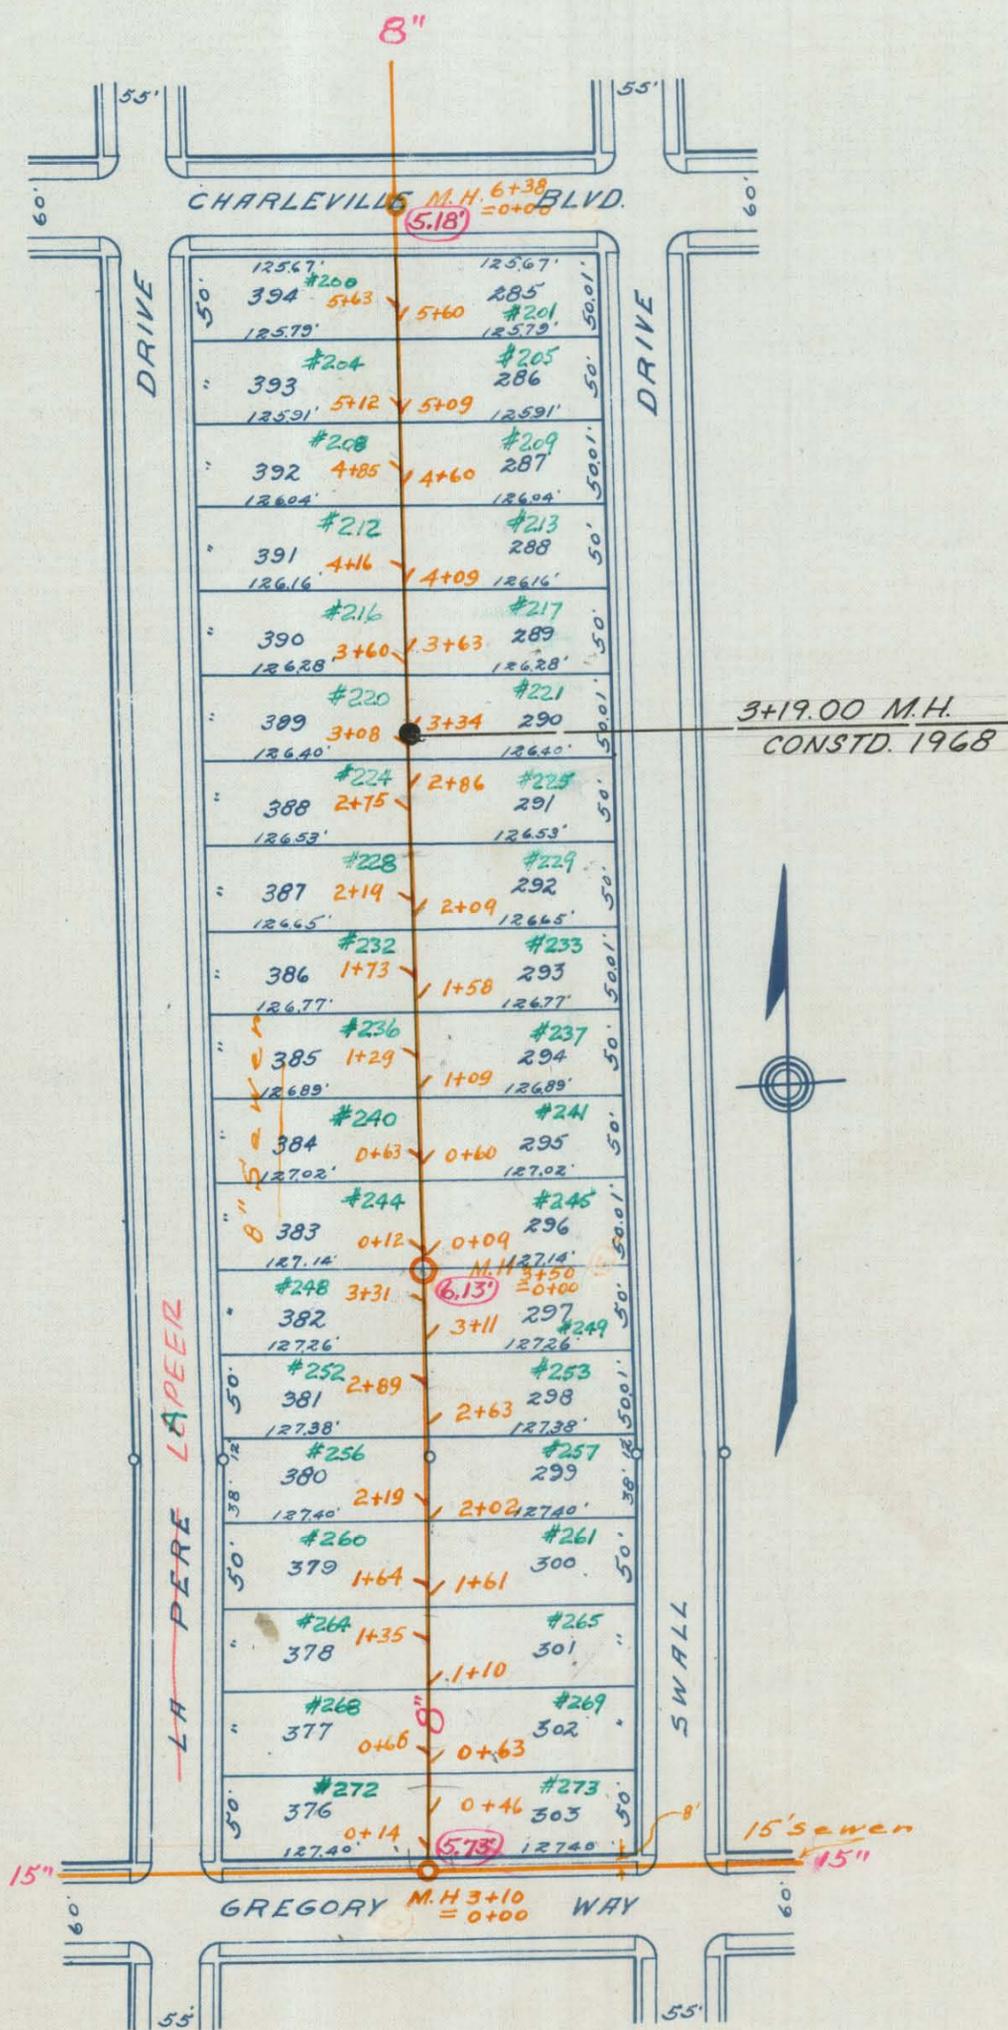

Note: No Saddles  
on 15" line along  
Gregory way.


CITY OF BEVERLY HILLS

TRACT 6380

M.B. 69-11-20  
SCALE 1 inch = 100 ft.

1926

18

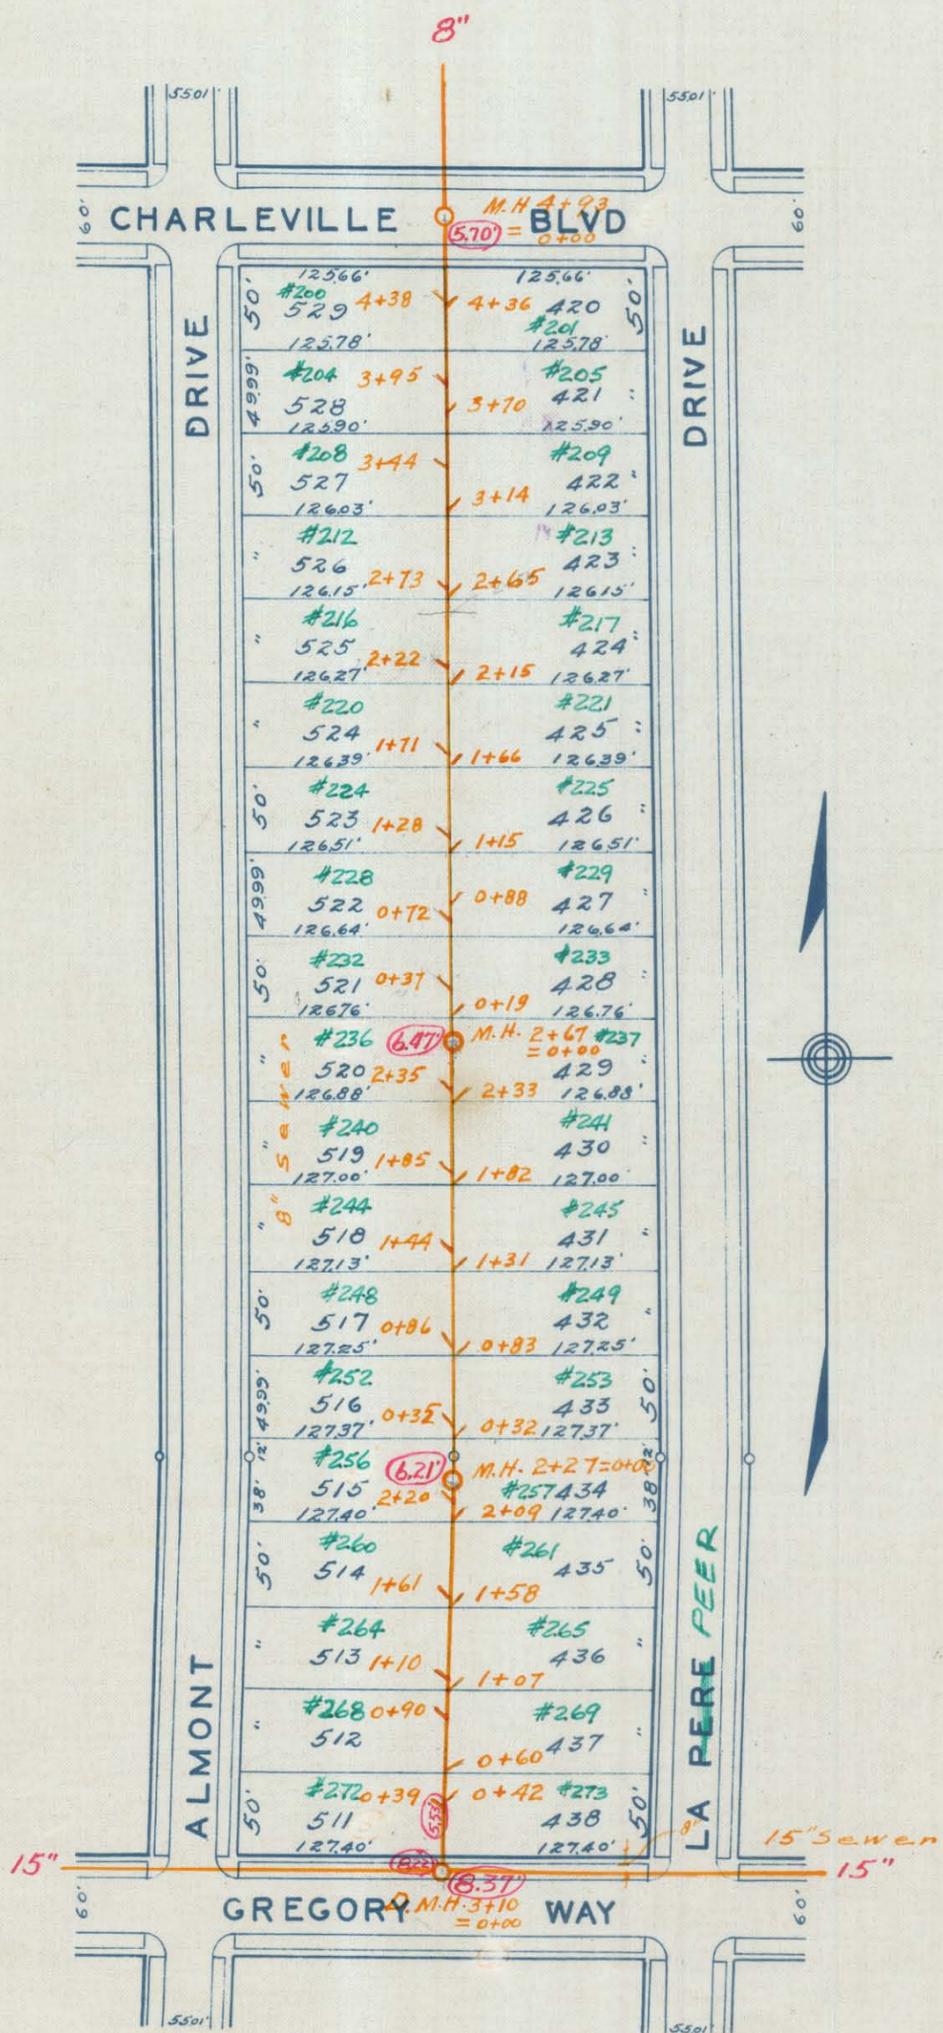


Note: No Saddles on 15" line along Gregory Way

CITY OF BEVERLY HILLS  
 TRACT 6380  
 M.B. 69-11-20  
 SCALE 1"=100'


1926

19

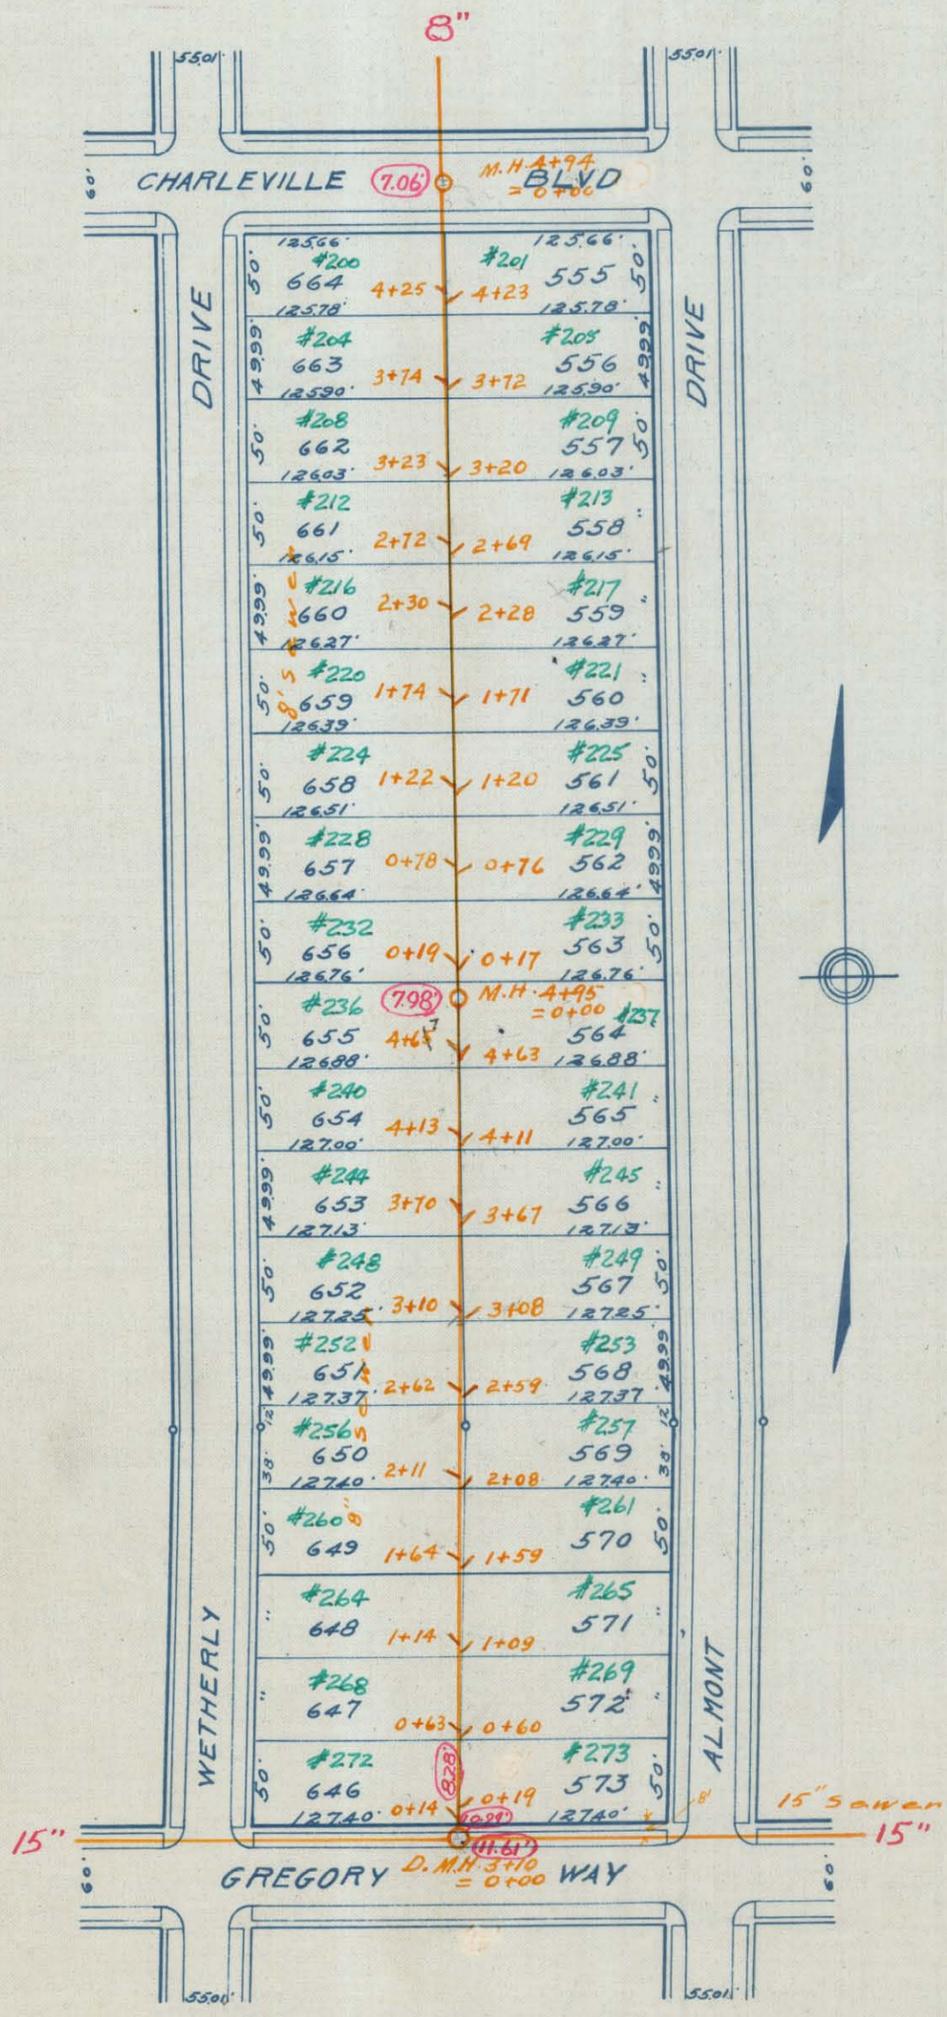


Note: No Saddles on 15" line along Gregory Way.

CITY OF BEVERLY HILLS  
 TRACT 6380  
 M.B 69-11-20  
 SCALE 1"=100'  
 1926

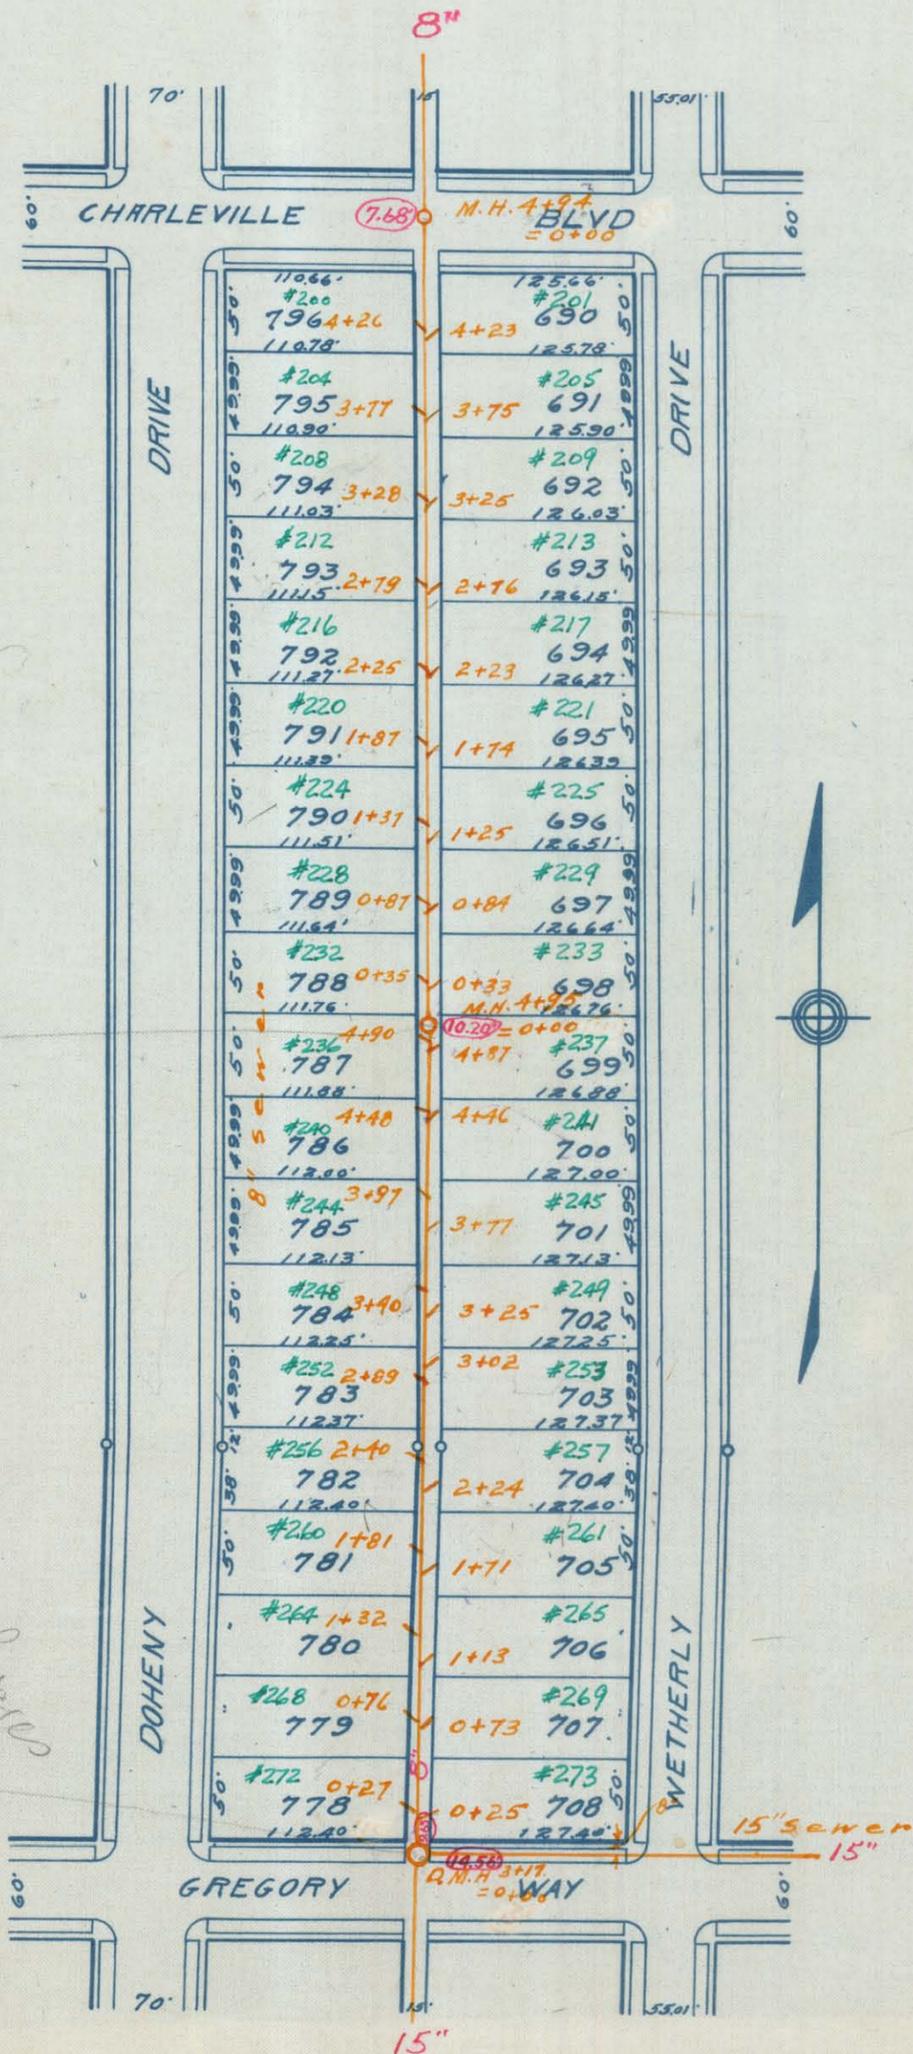


*Damage pipes in street where garages are built. Location of pipes marked on garage - marked on windowsills.*

*Note: No Saddles on 15" line on Gregory and 15" line South from Manhole.*

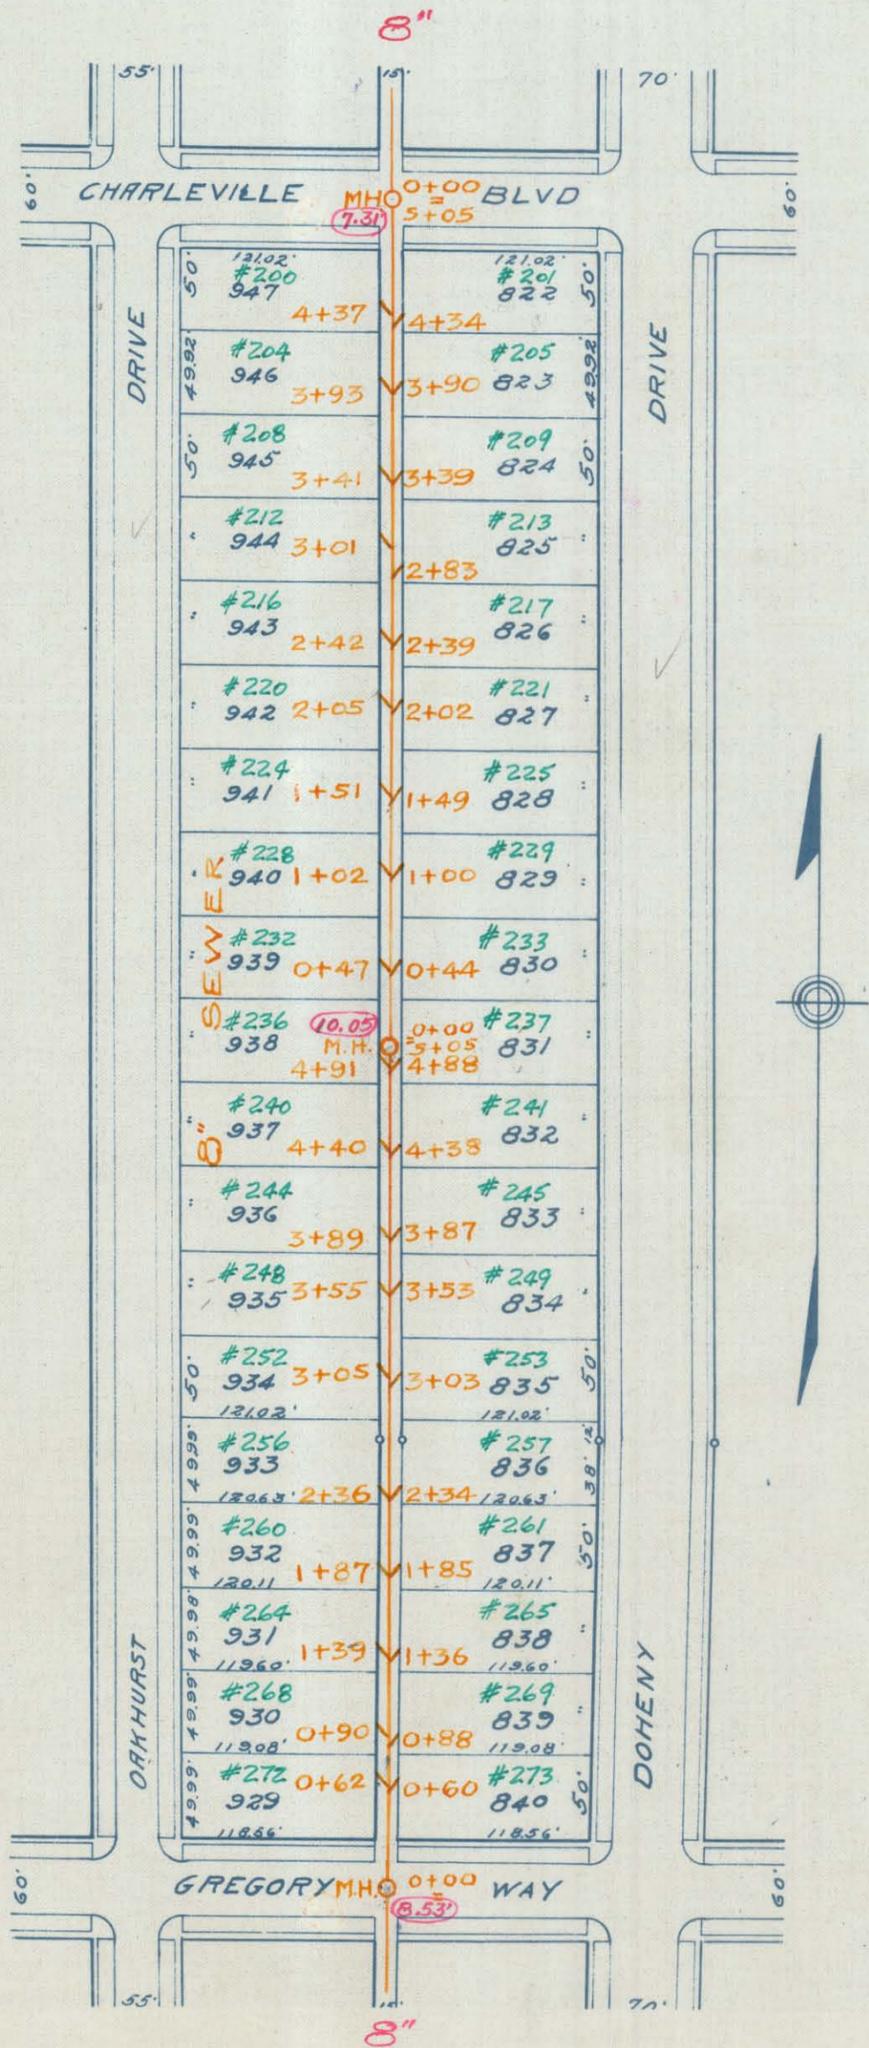


CITY OF BEVERLY HILLS  
 TRACT 6380  
 M. B. 69-11-20  
 SCALE 1"=100'  
 1926

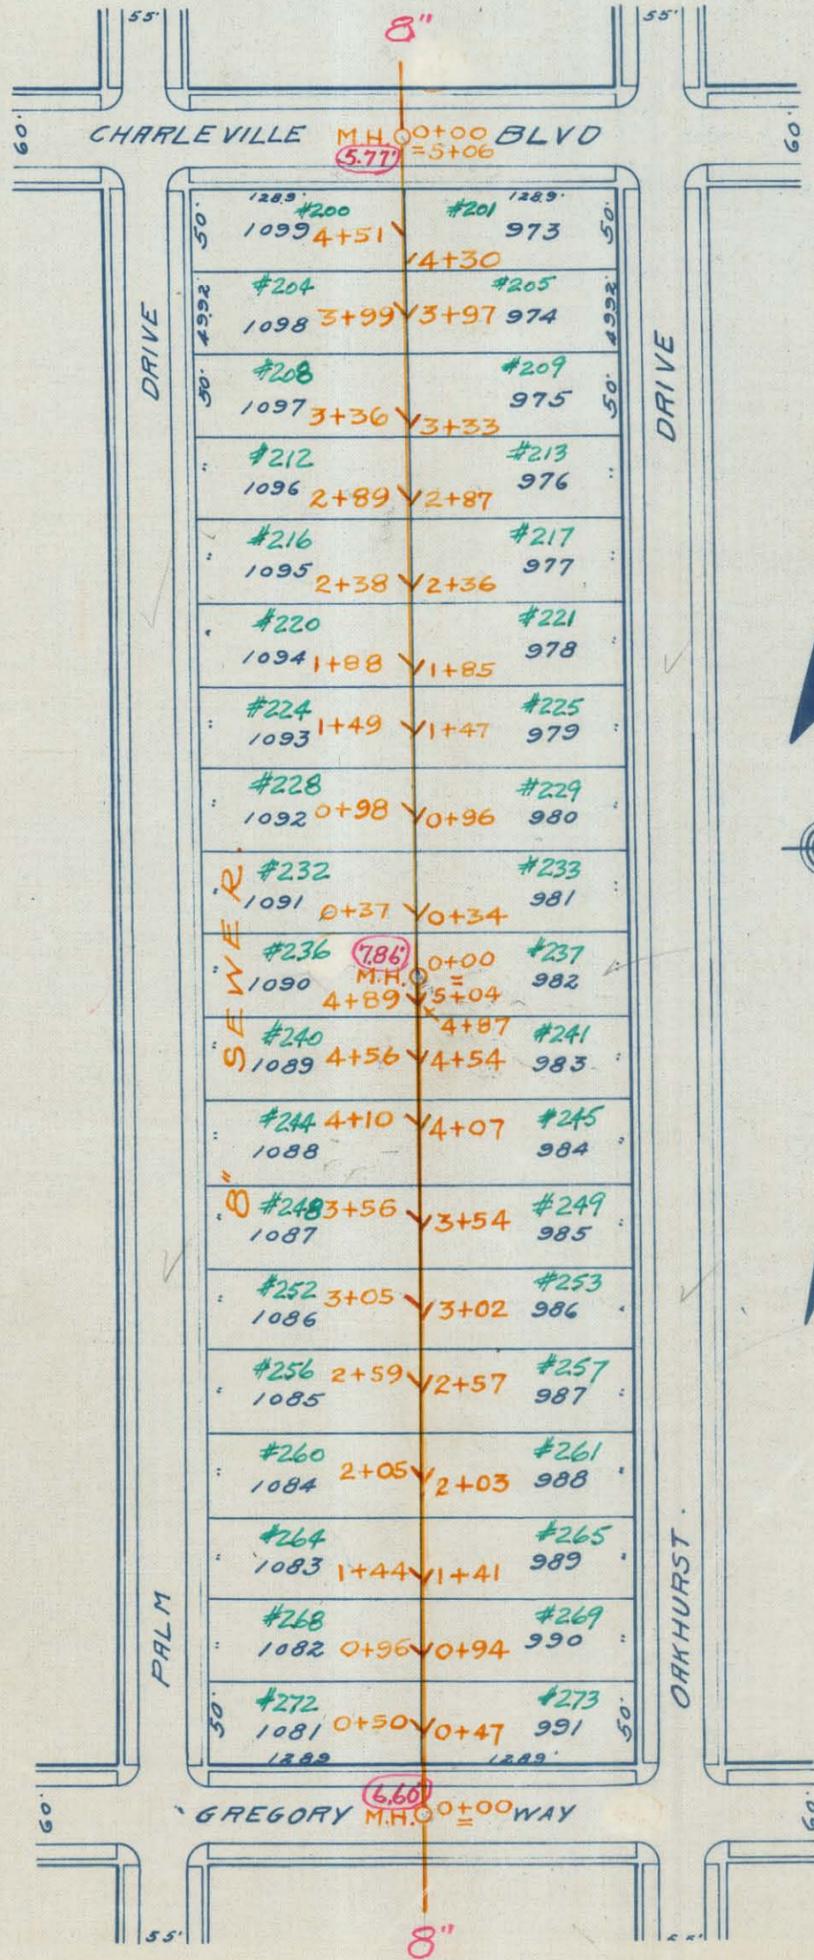

CITY OF BEVERLY HILLS  
 TRACT 6380  
 M.B 69-11-20  
 SCALE 1"=100'  
 1926

23

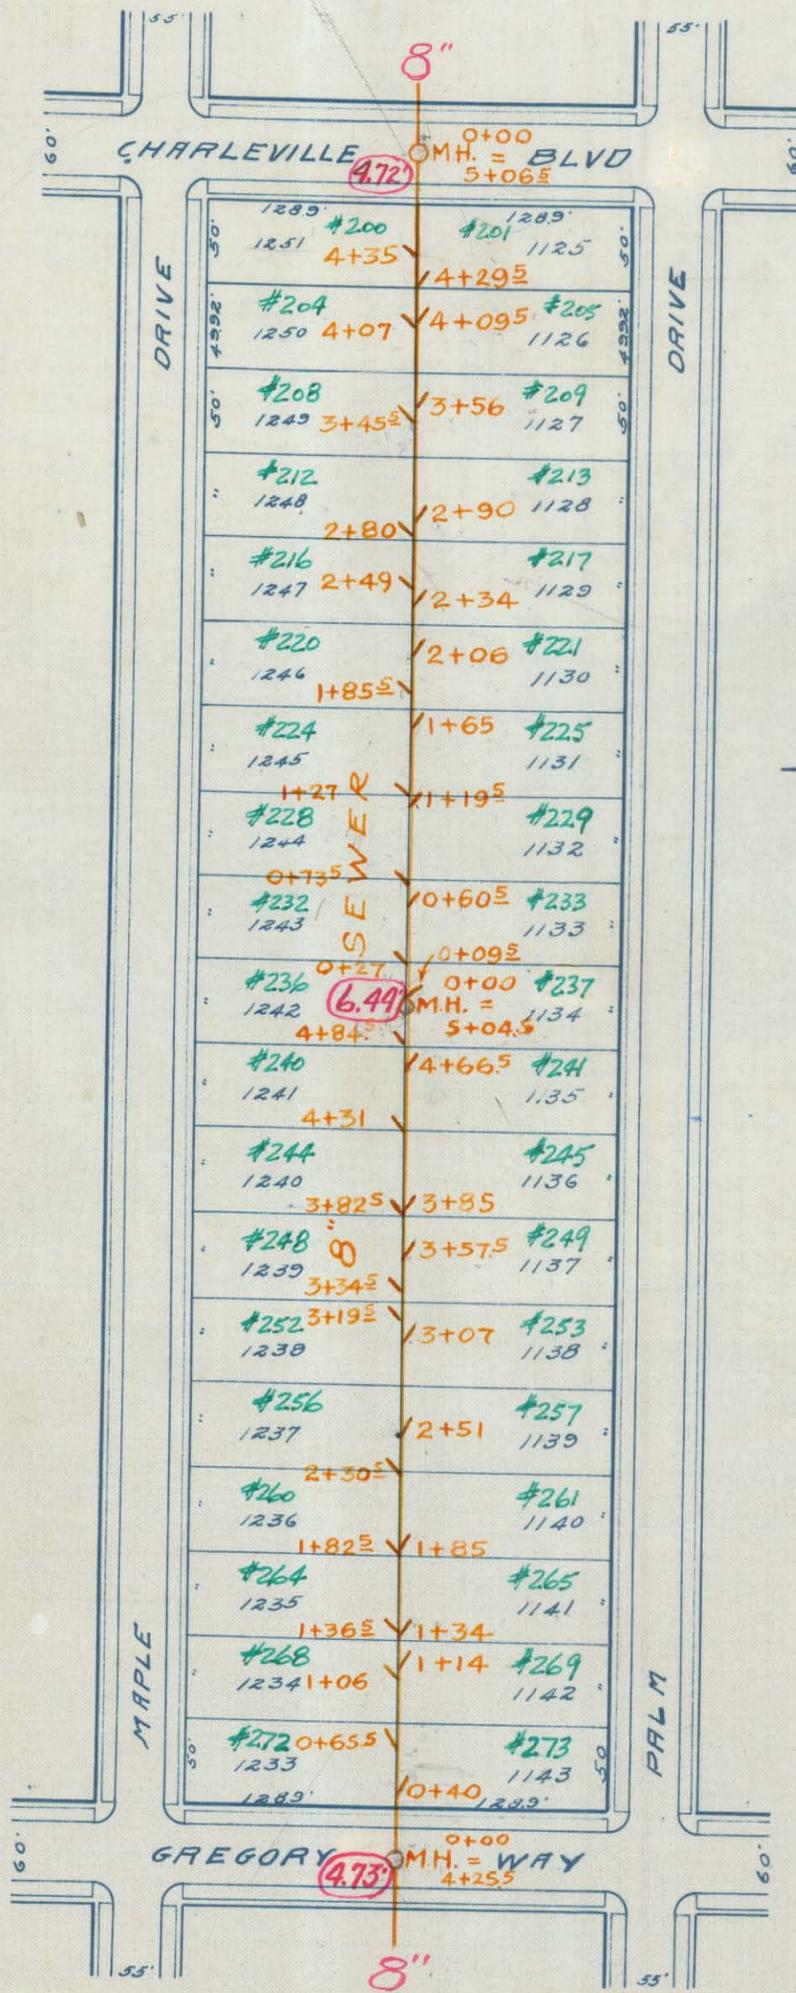


CITY OF BEVERLY HILLS

TRACT 6380

M.B. 69-11-20

SCALE 1"=100'


1926

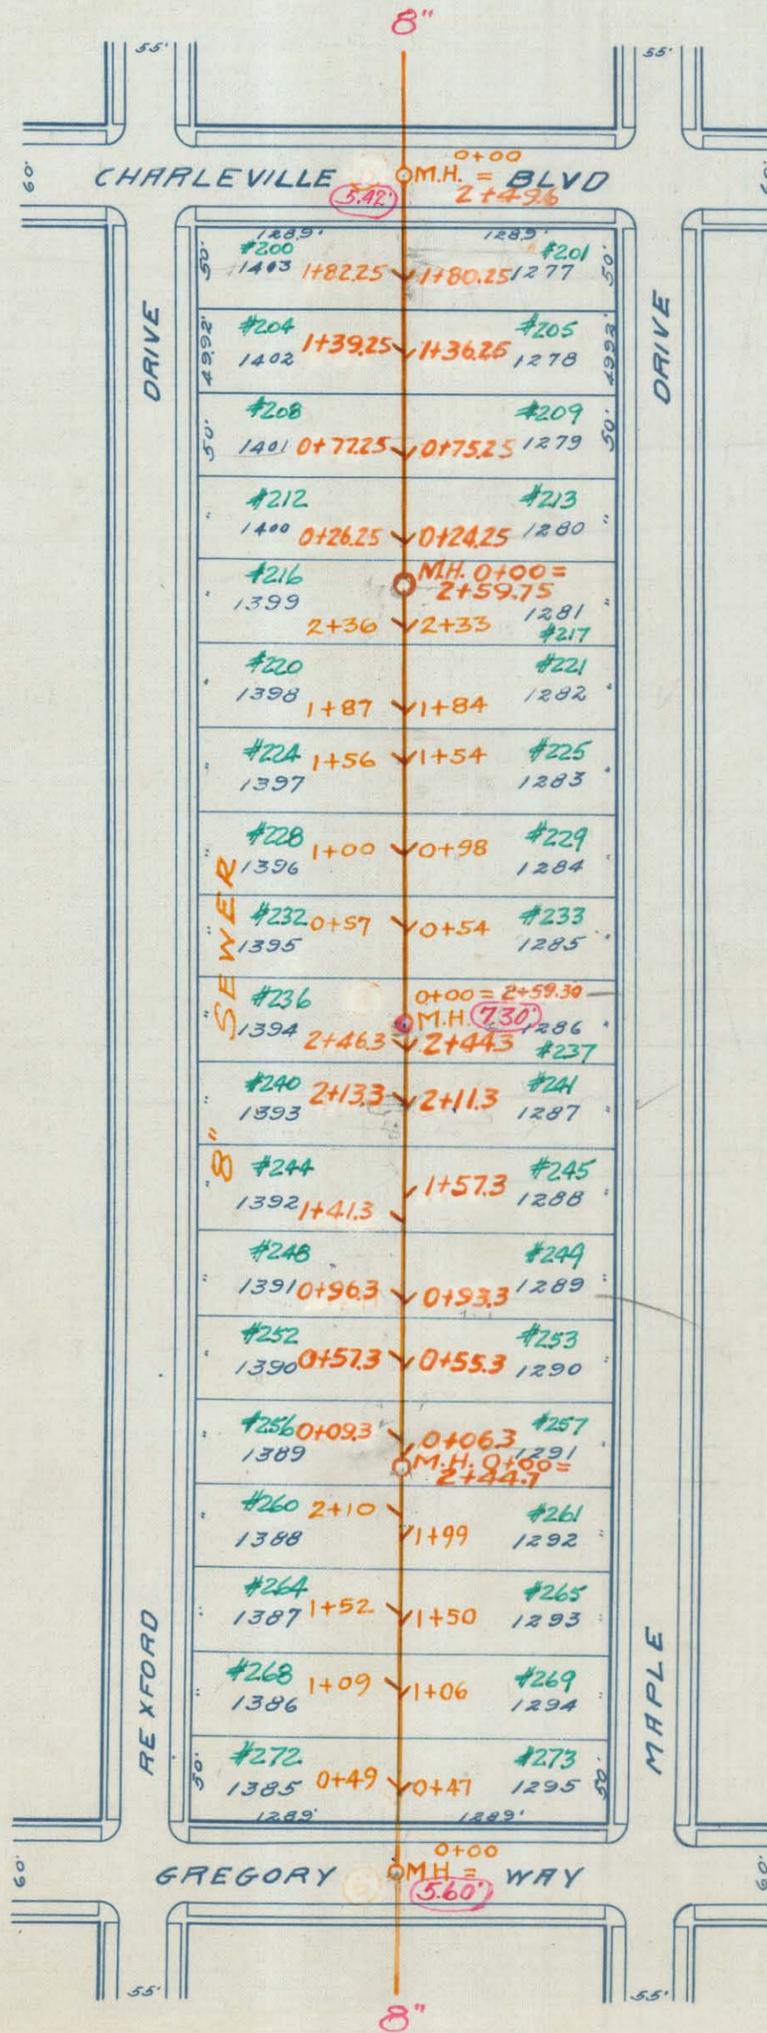

4" A.C. Pavement

CITY OF BEVERLY HILLS  
 TRACT 6380  
 M.B. 69-11-20  
 SCALE 1"=100'  
 -1926-

25

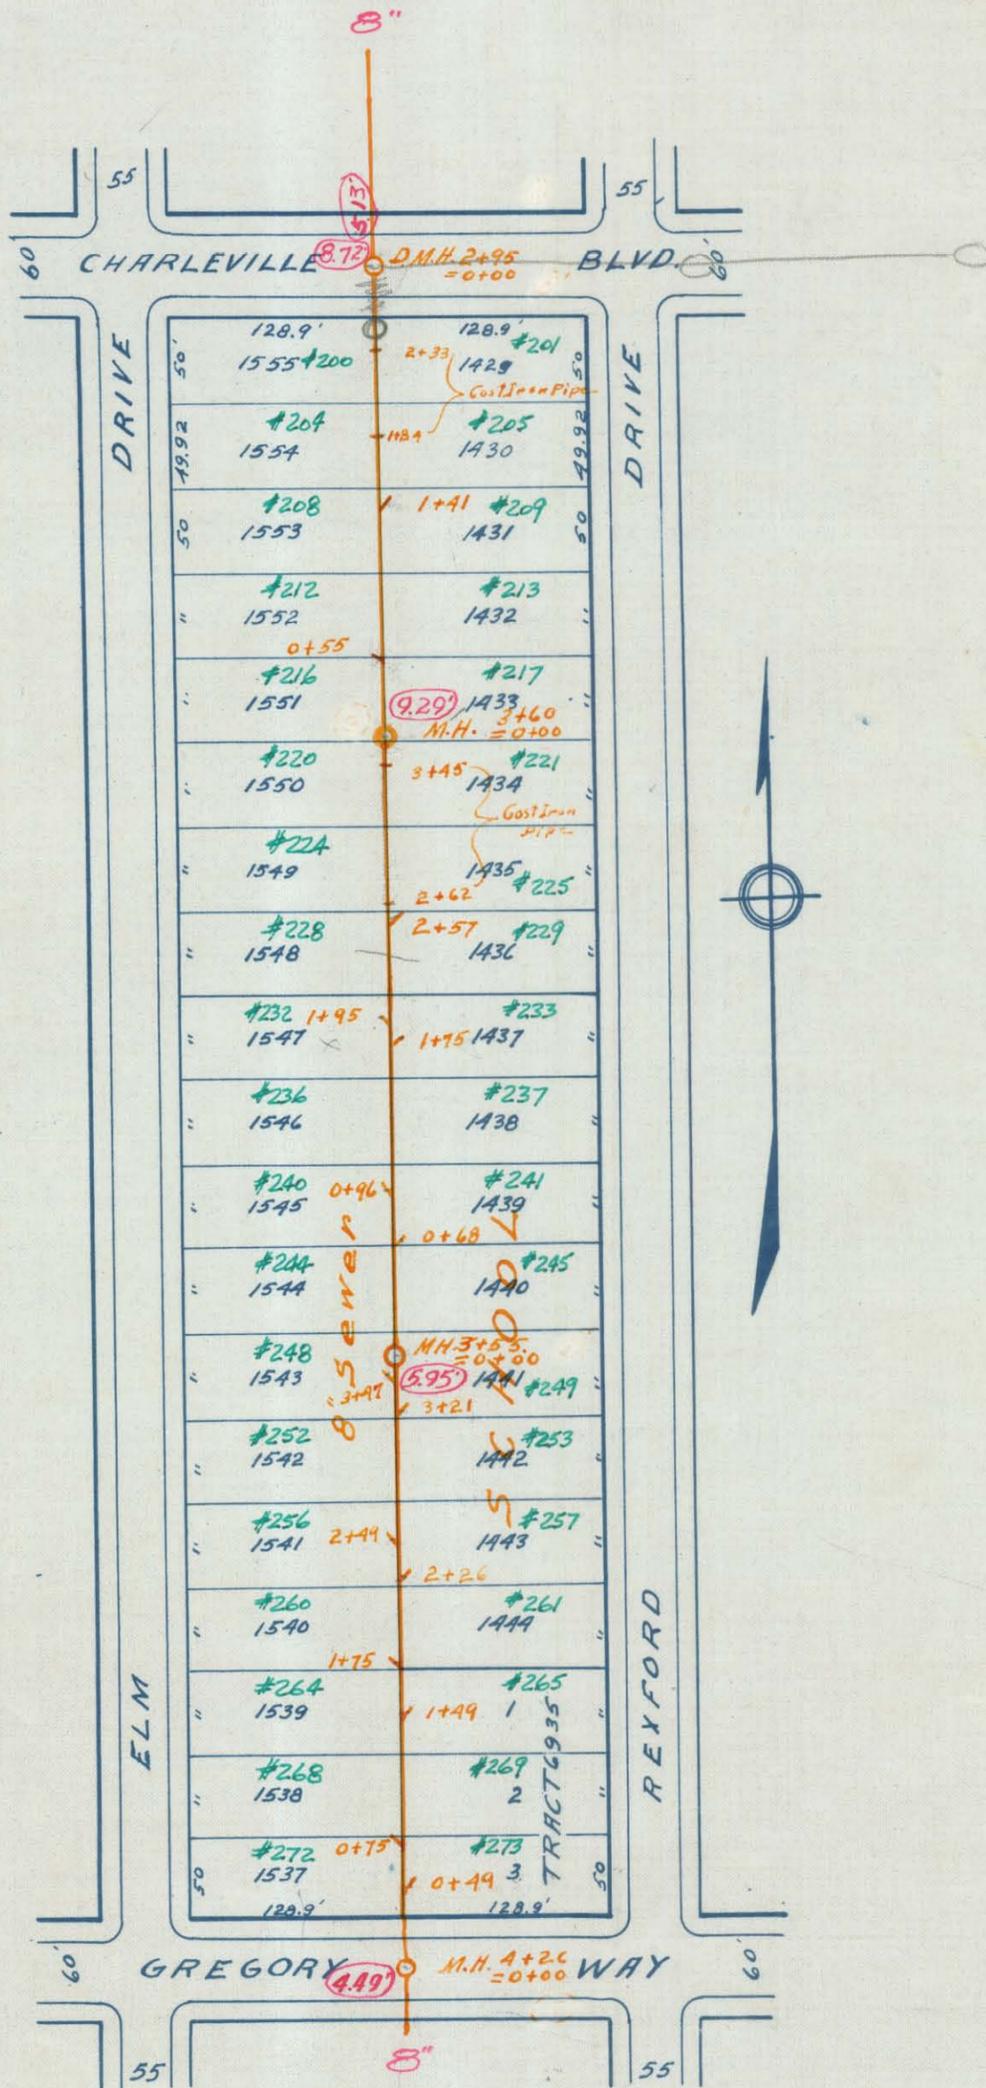

TRACT 6380

M.B. 69-11-20


SCALE 1 inch = 100 ft.

1926


26






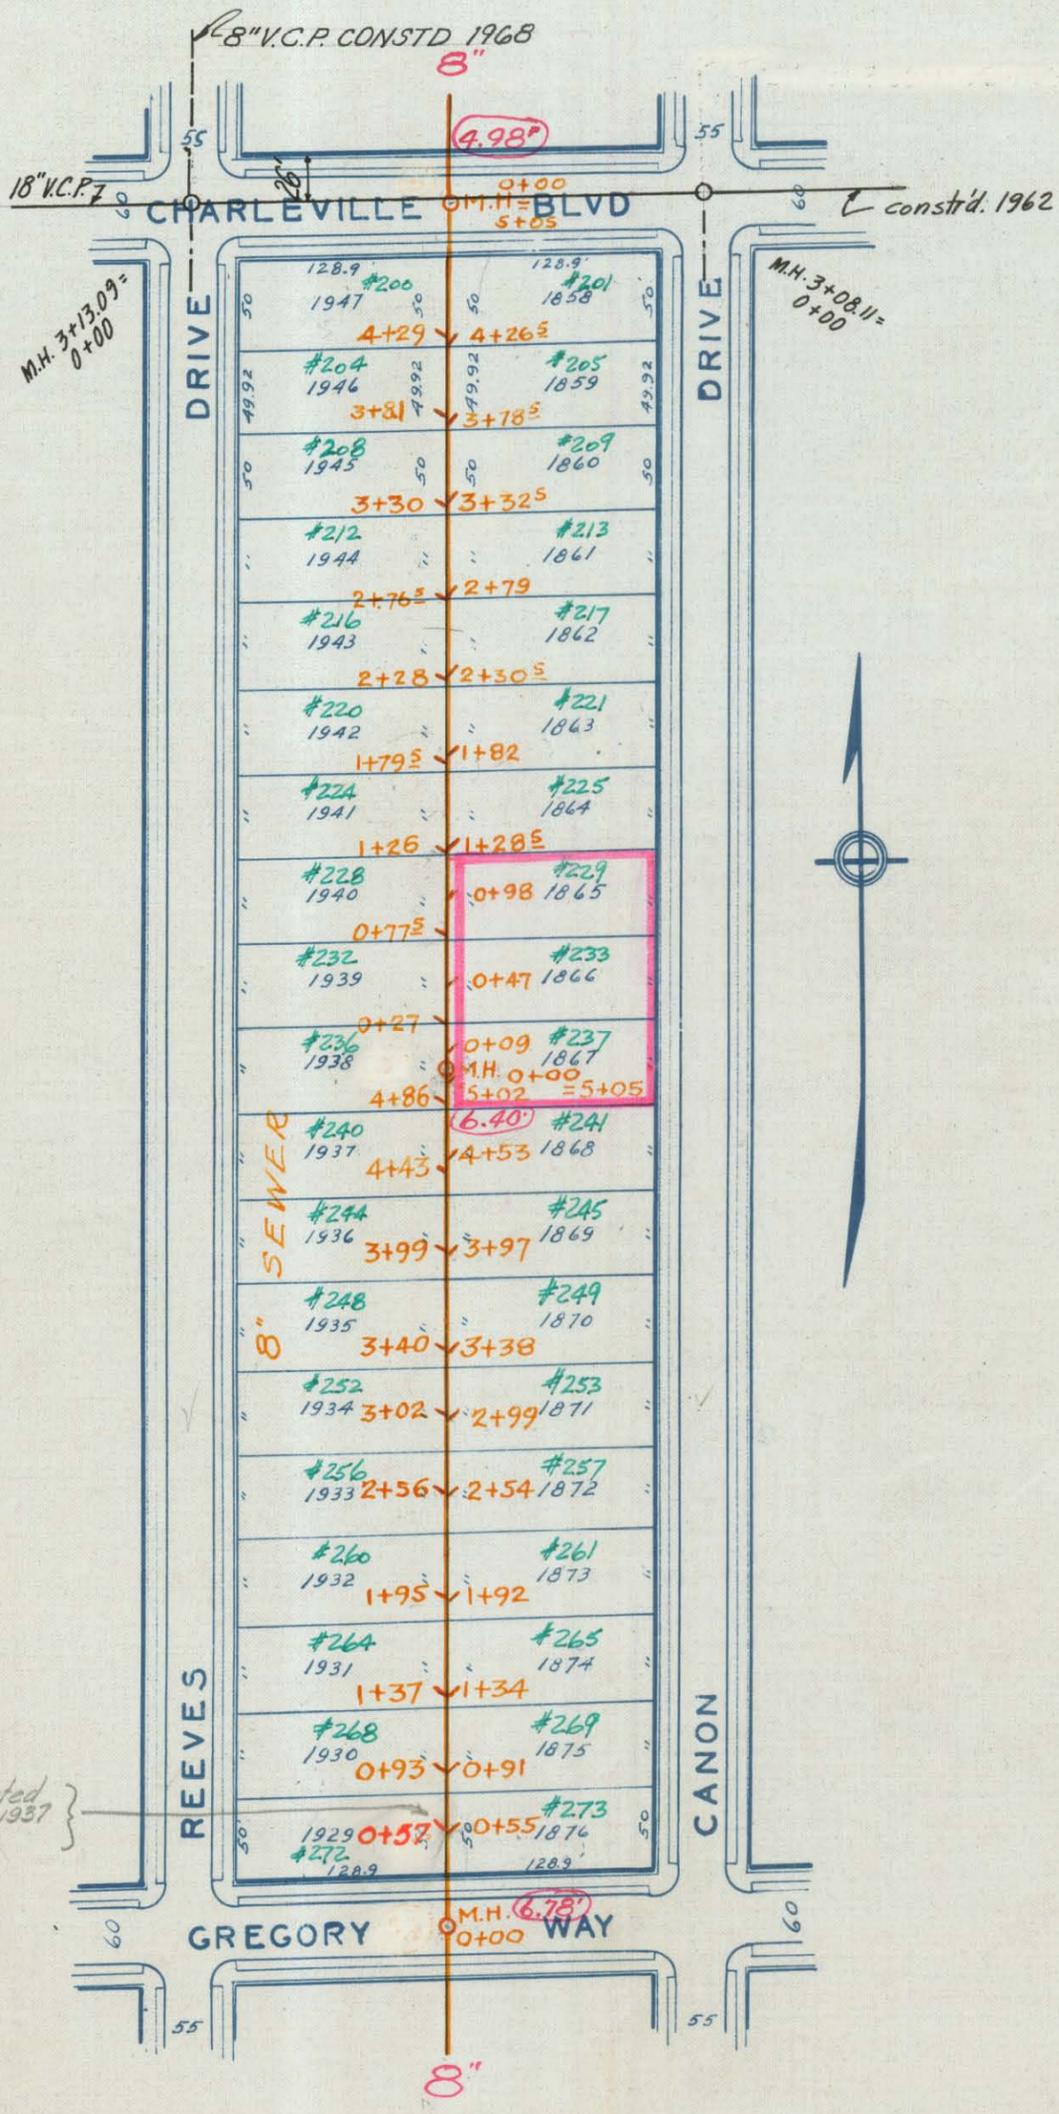

CITY OF BEVERLY HILLS  
 TRACT 6380  
 M.B. 69-11-20  
 SCALE 1"=100'  
 1926

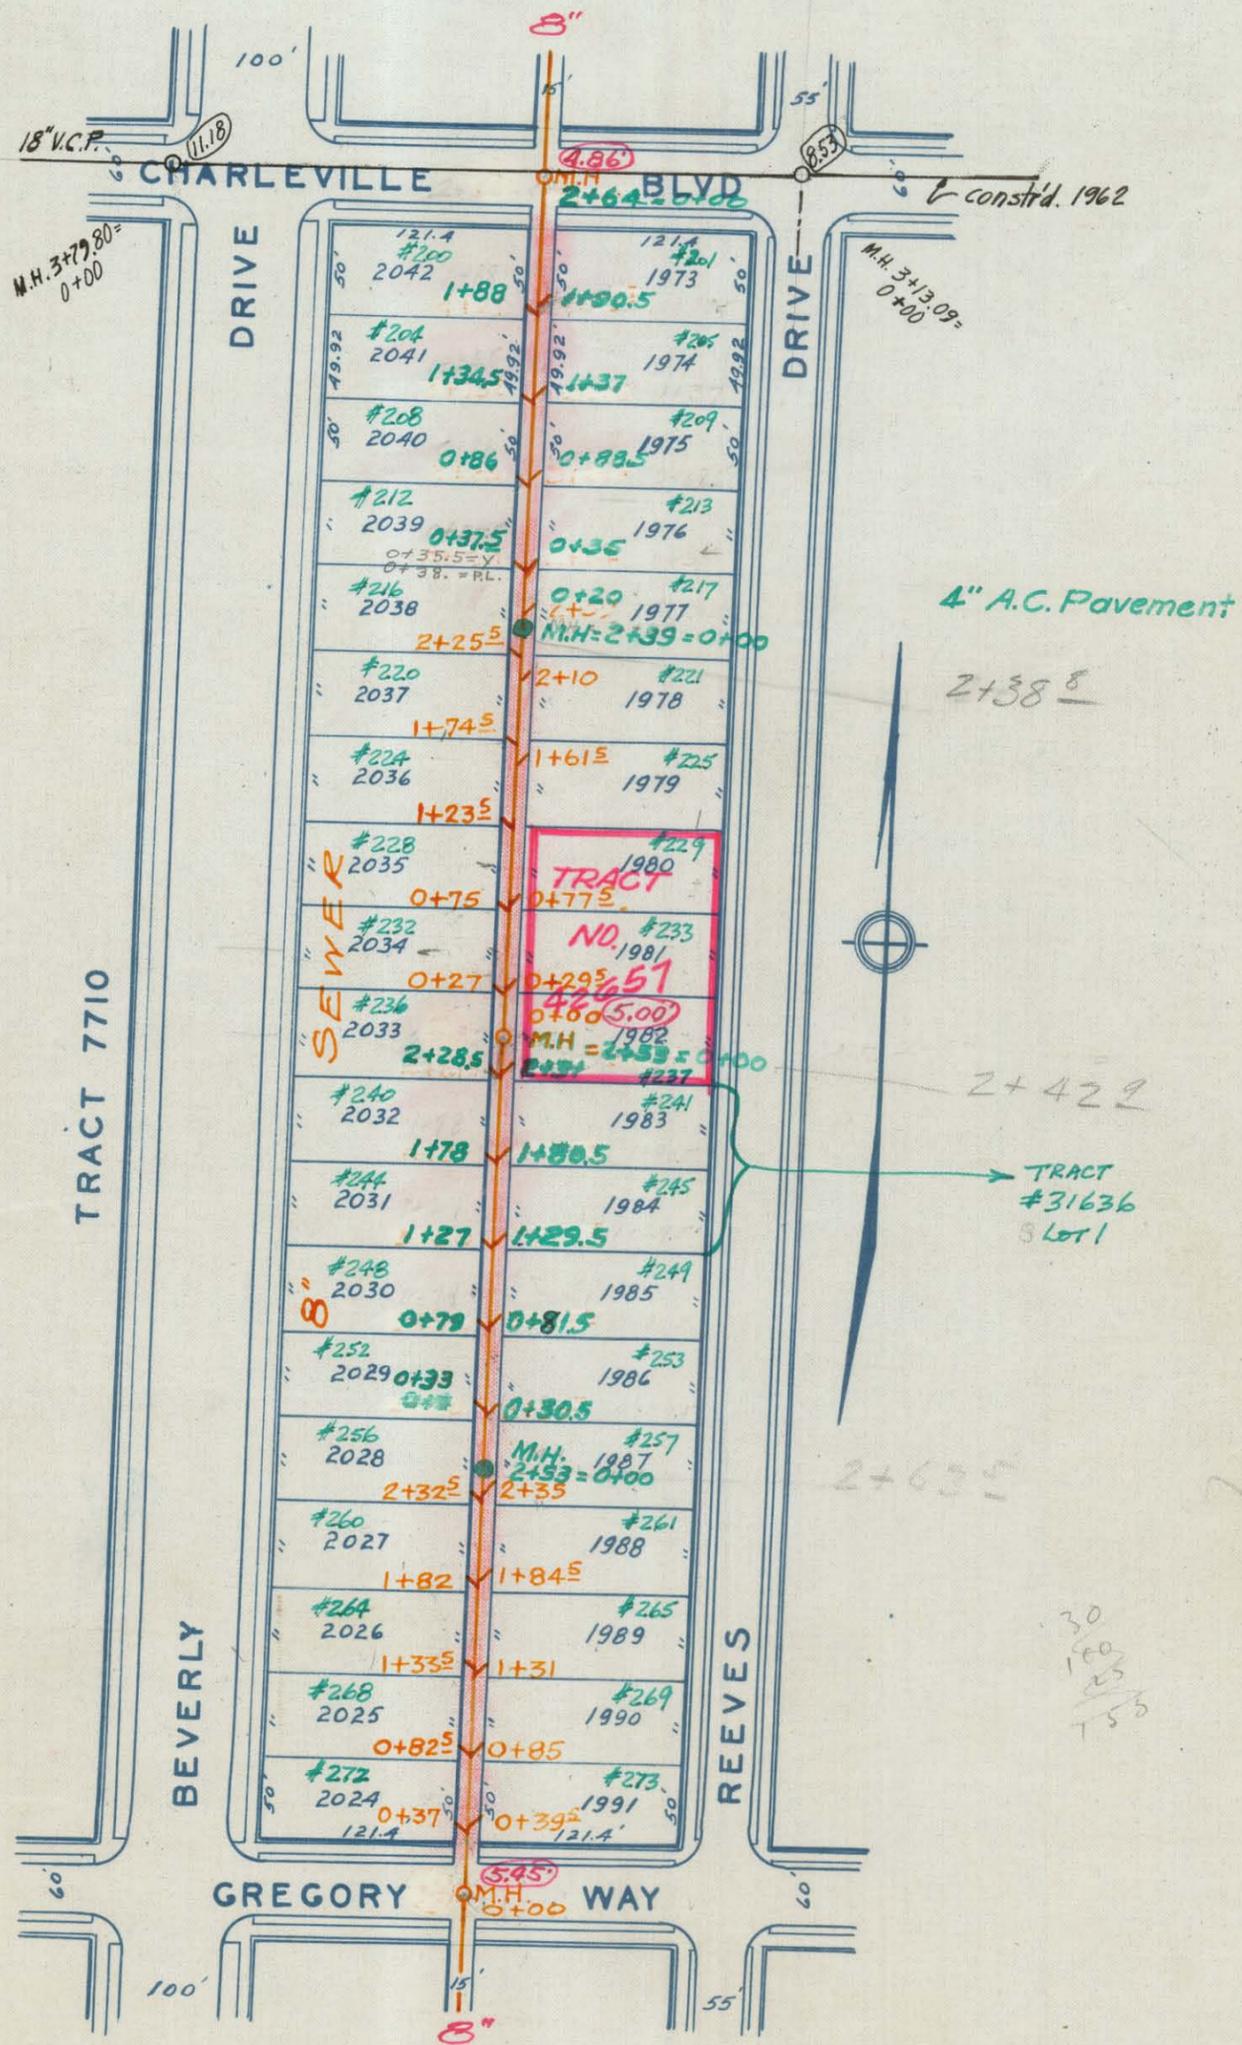

CITY OF BEVERLY HILLS  
 TRACT 6380  
 M. B. 69-11-20  
 SCALE 1"=100'  
 -1926-

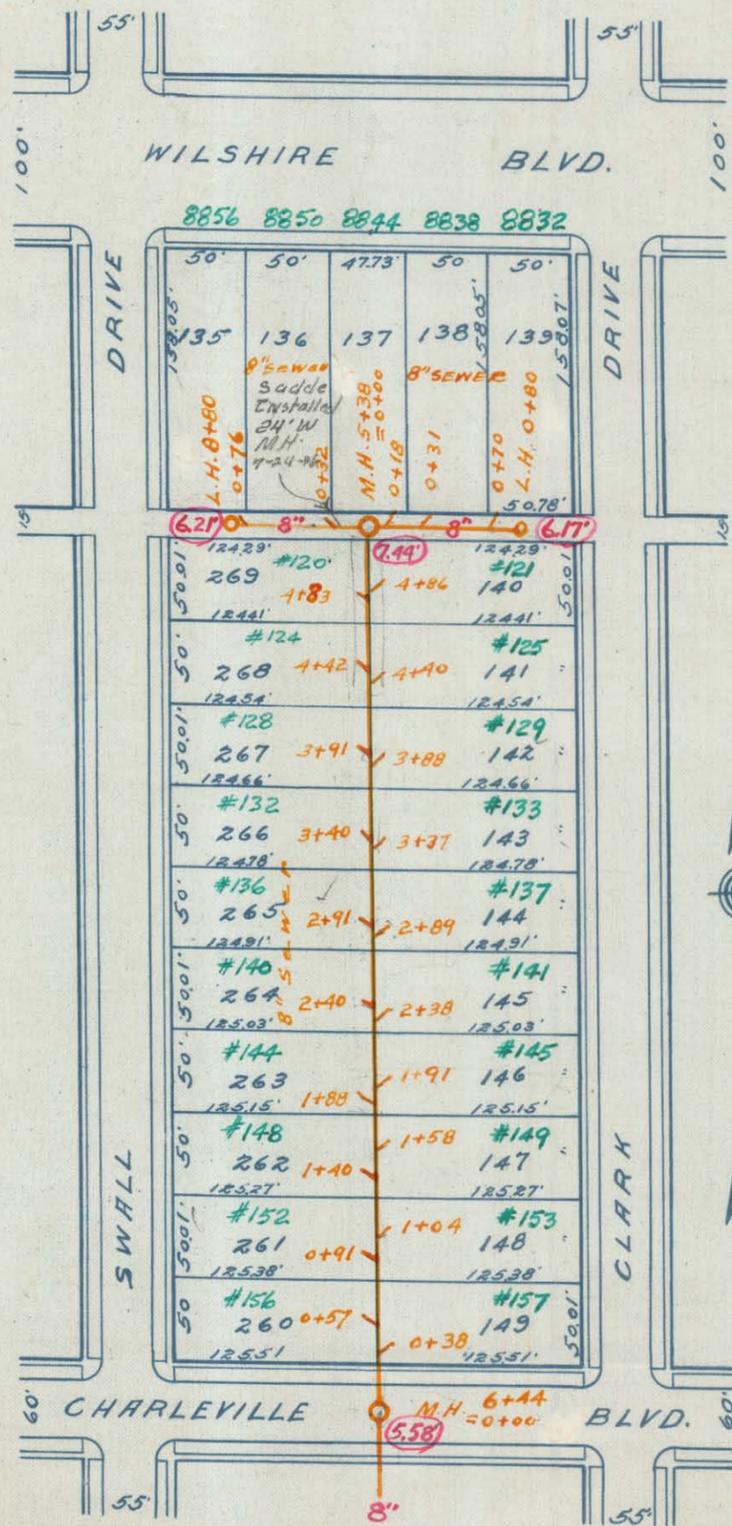


5.99  
2.91  
2.47

CITY OF BEVERLY HILLS  
TRACT 6380  
M.B. 69-11-20  
SCALE 1 inch = 100 ft.  
1926

2


2

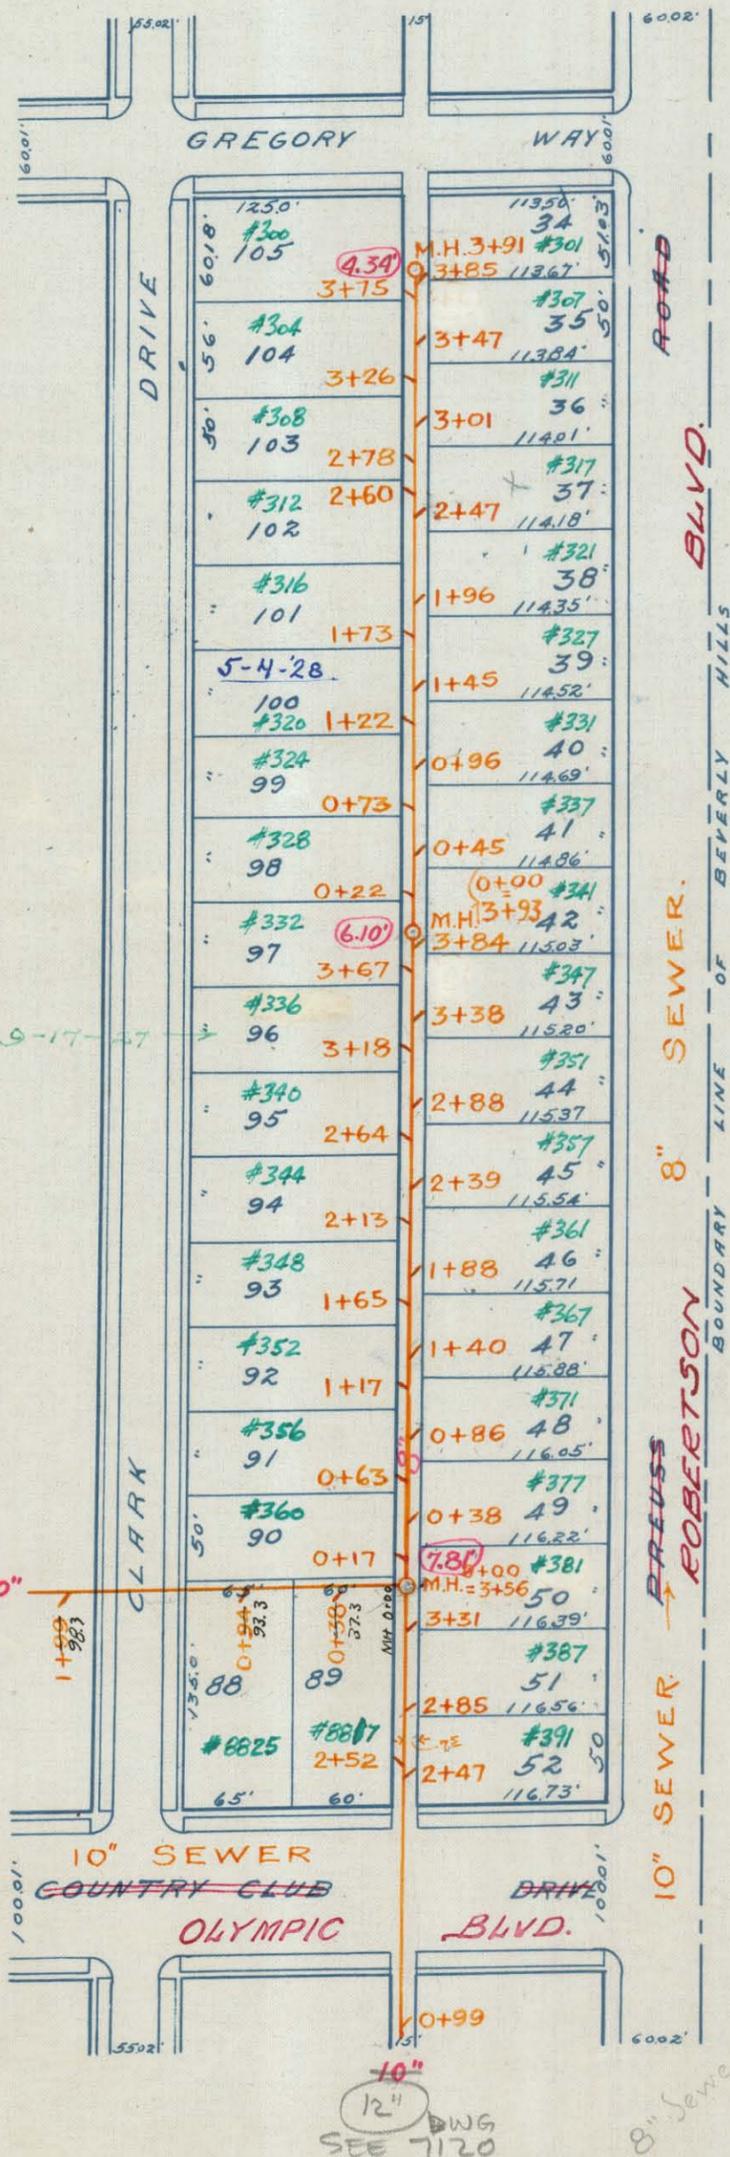

ENTER DATE OF PERMIT ON THIS SHEET

Note: No Saddles on 10" line in alley North of Olympic, and South in E of alley across Olympic. 8" line from Manhole North, is O.K.

CITY OF BEVERLY HILLS  
 TRACT 6380  
 M.B. 69-11-20  
 SCALE 1 inch = 100 ft.  
 -1926-

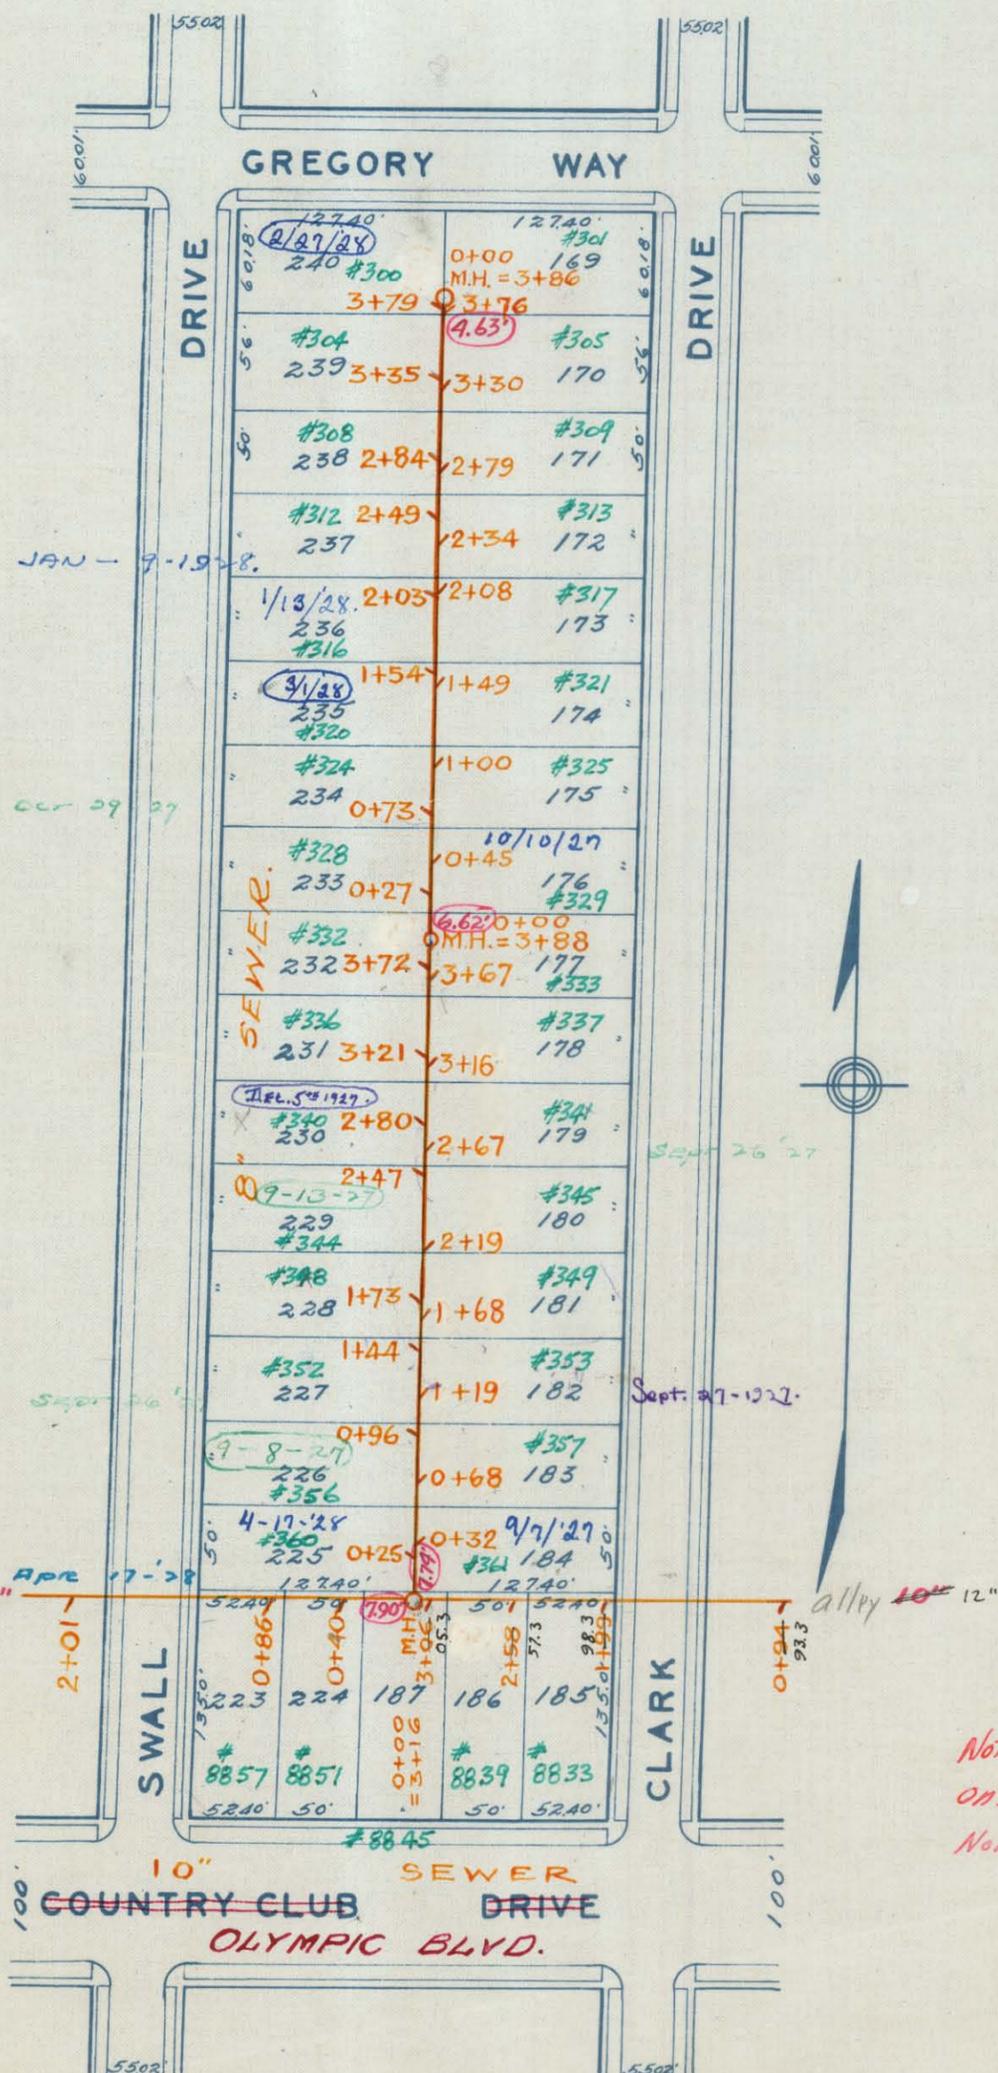

ENTER DATE OF PERMIT ON THIS SHEET


Note: No Saddles on line in alley North of Olympic.

CITY OF BEVERLY HILLS  
 TRACT 6380  
 M. B. 69-11-20  
 SCALE 1"=100'  
 -1926-

32





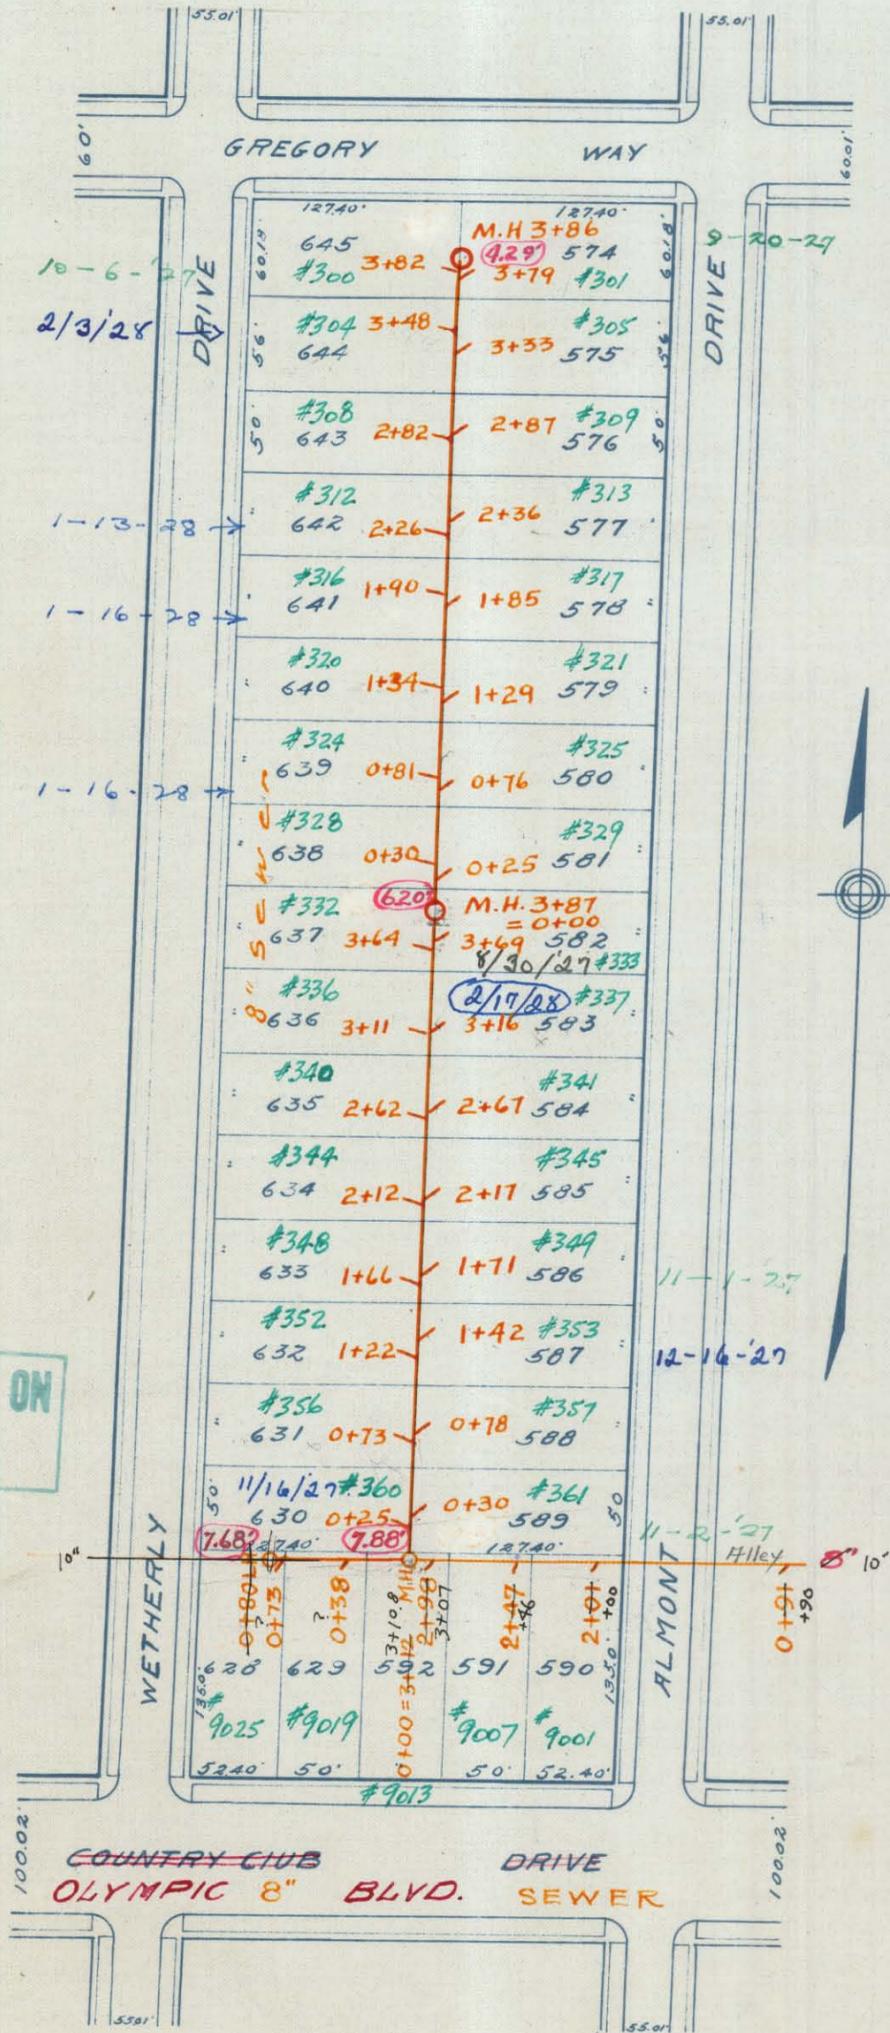


ENTER DATE OF PERMIT ON THIS SHEET

Note: No Saddles on 8" line in alley North of Olympic

CITY OF BEVERLY HILLS  
 TRACT 6380  
 M. B. 69-11-20  
 SCALE 1"=100'  
 -1926-

35

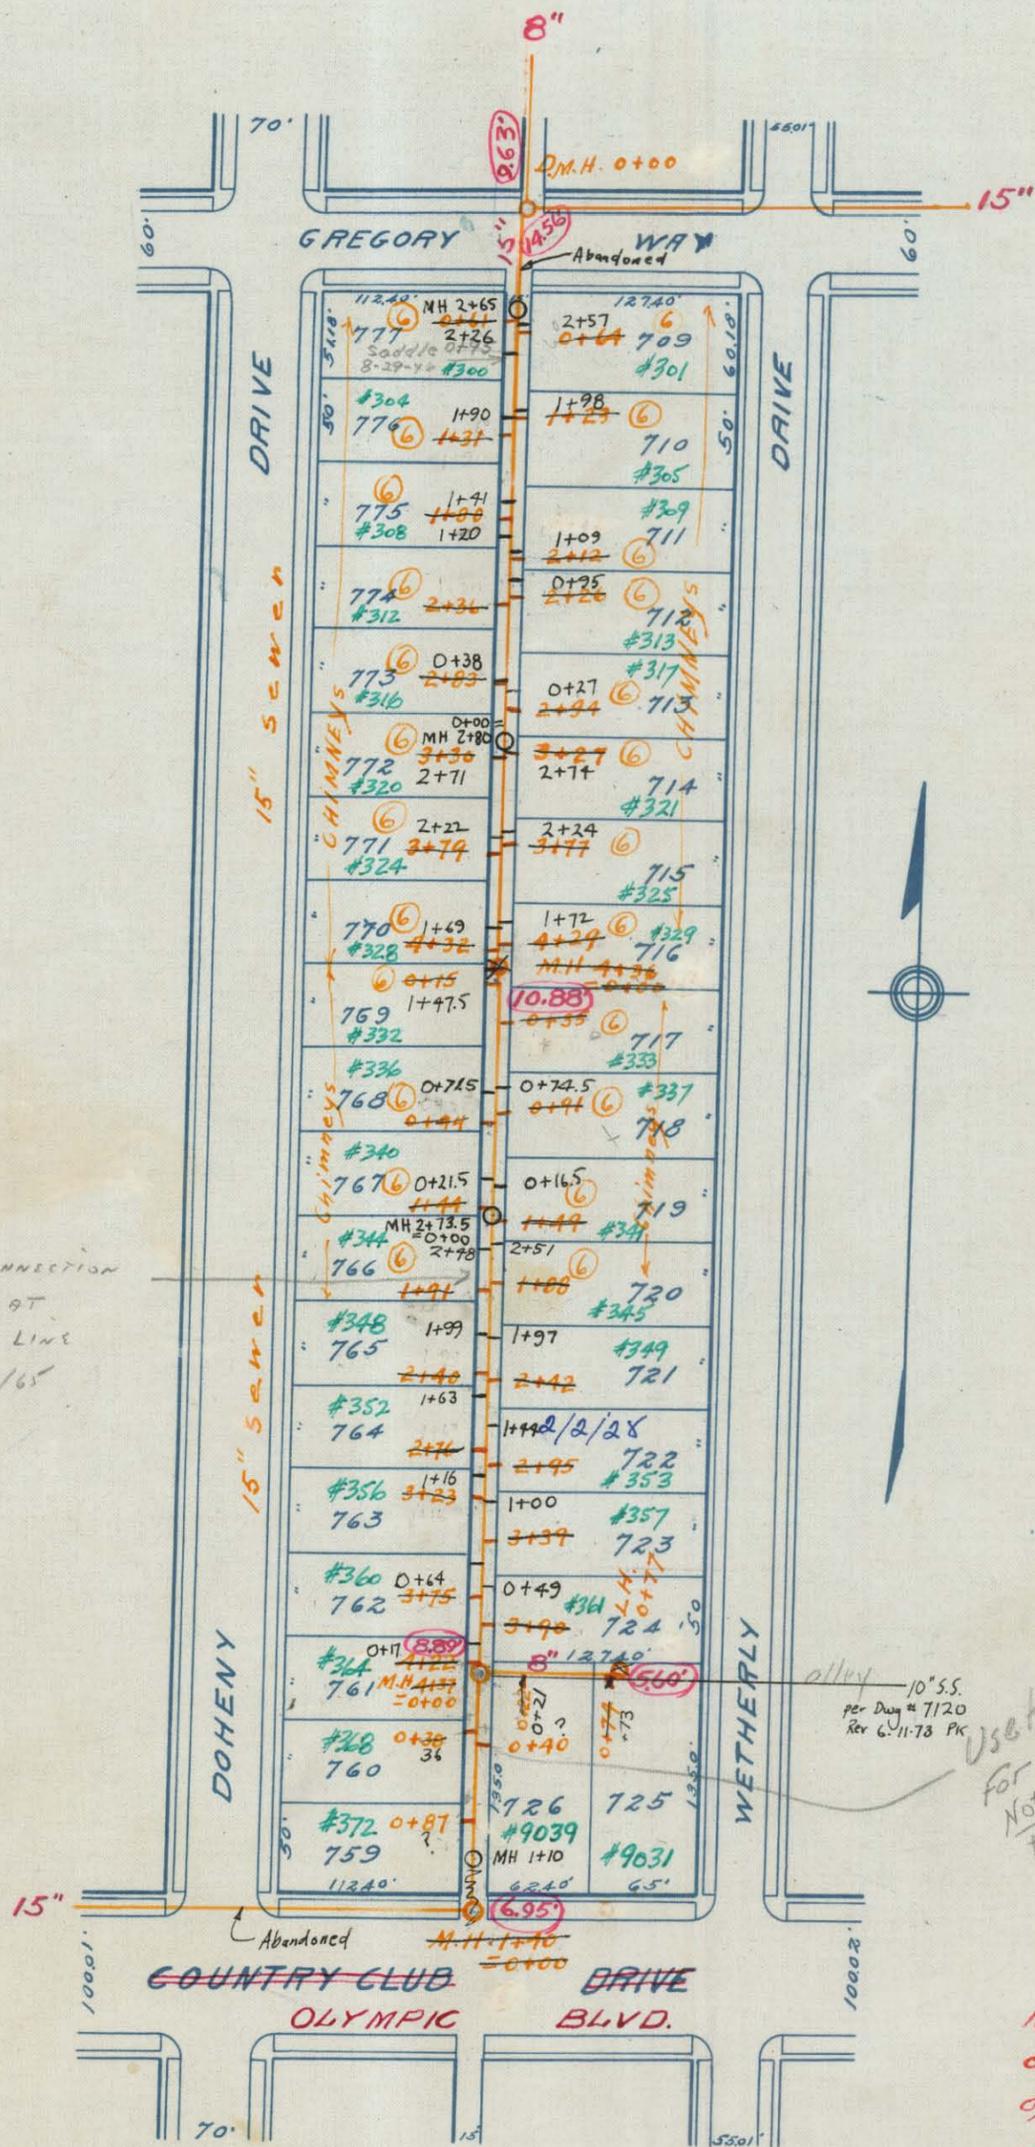


SEWER CONNECTION  
18" deep at  
PROPERTY LINE  
7/13/65

Use this connection only  
for lot 726  
Note: Plumber (Bob Stotts) disregarded  
this advice and used Y on E-W Alley  
Nonsensical

Note: No Saddles  
on 15" line in E  
of Alley and line  
along Olympic.


CITY OF BEVERLY HILLS  
TRACT 6380  
M.B. 69-11-20  
SCALE 1"=100'  
1926

36

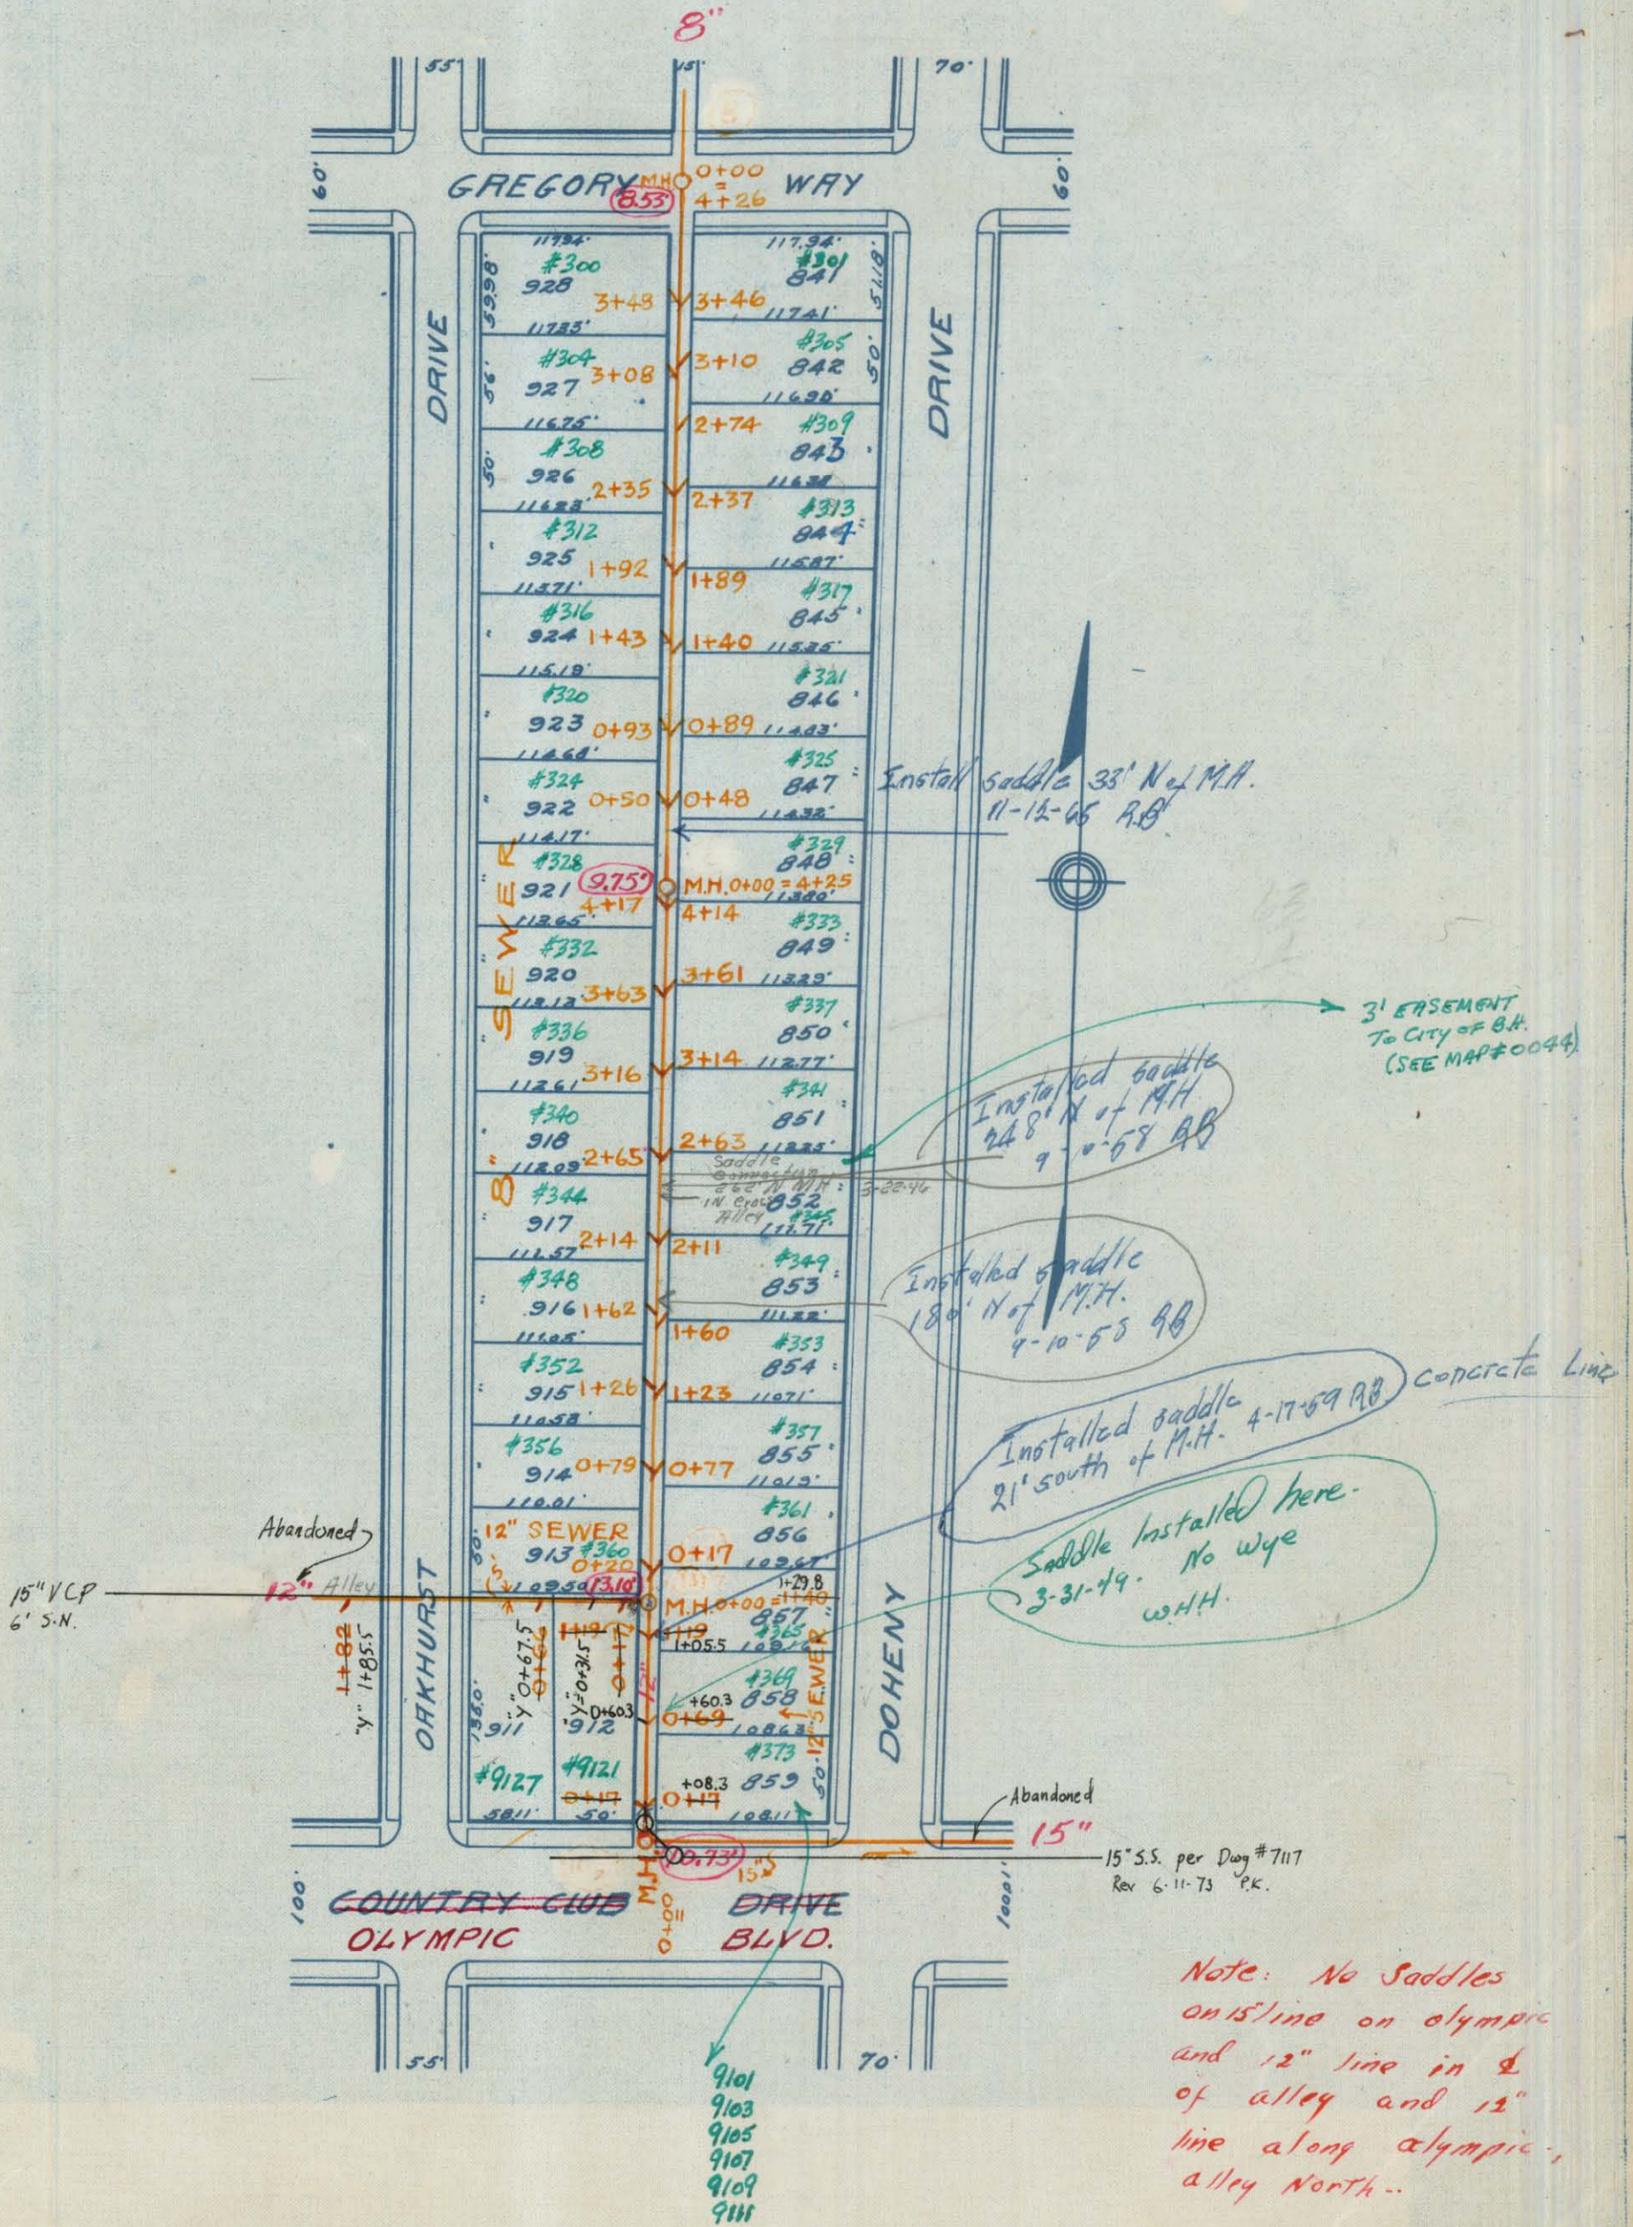


CITY OF BEVERLY HILLS  
 TRACT 6380  
 M.B. 69-11-20  
 SCALE 1"=100'  
 1926

37

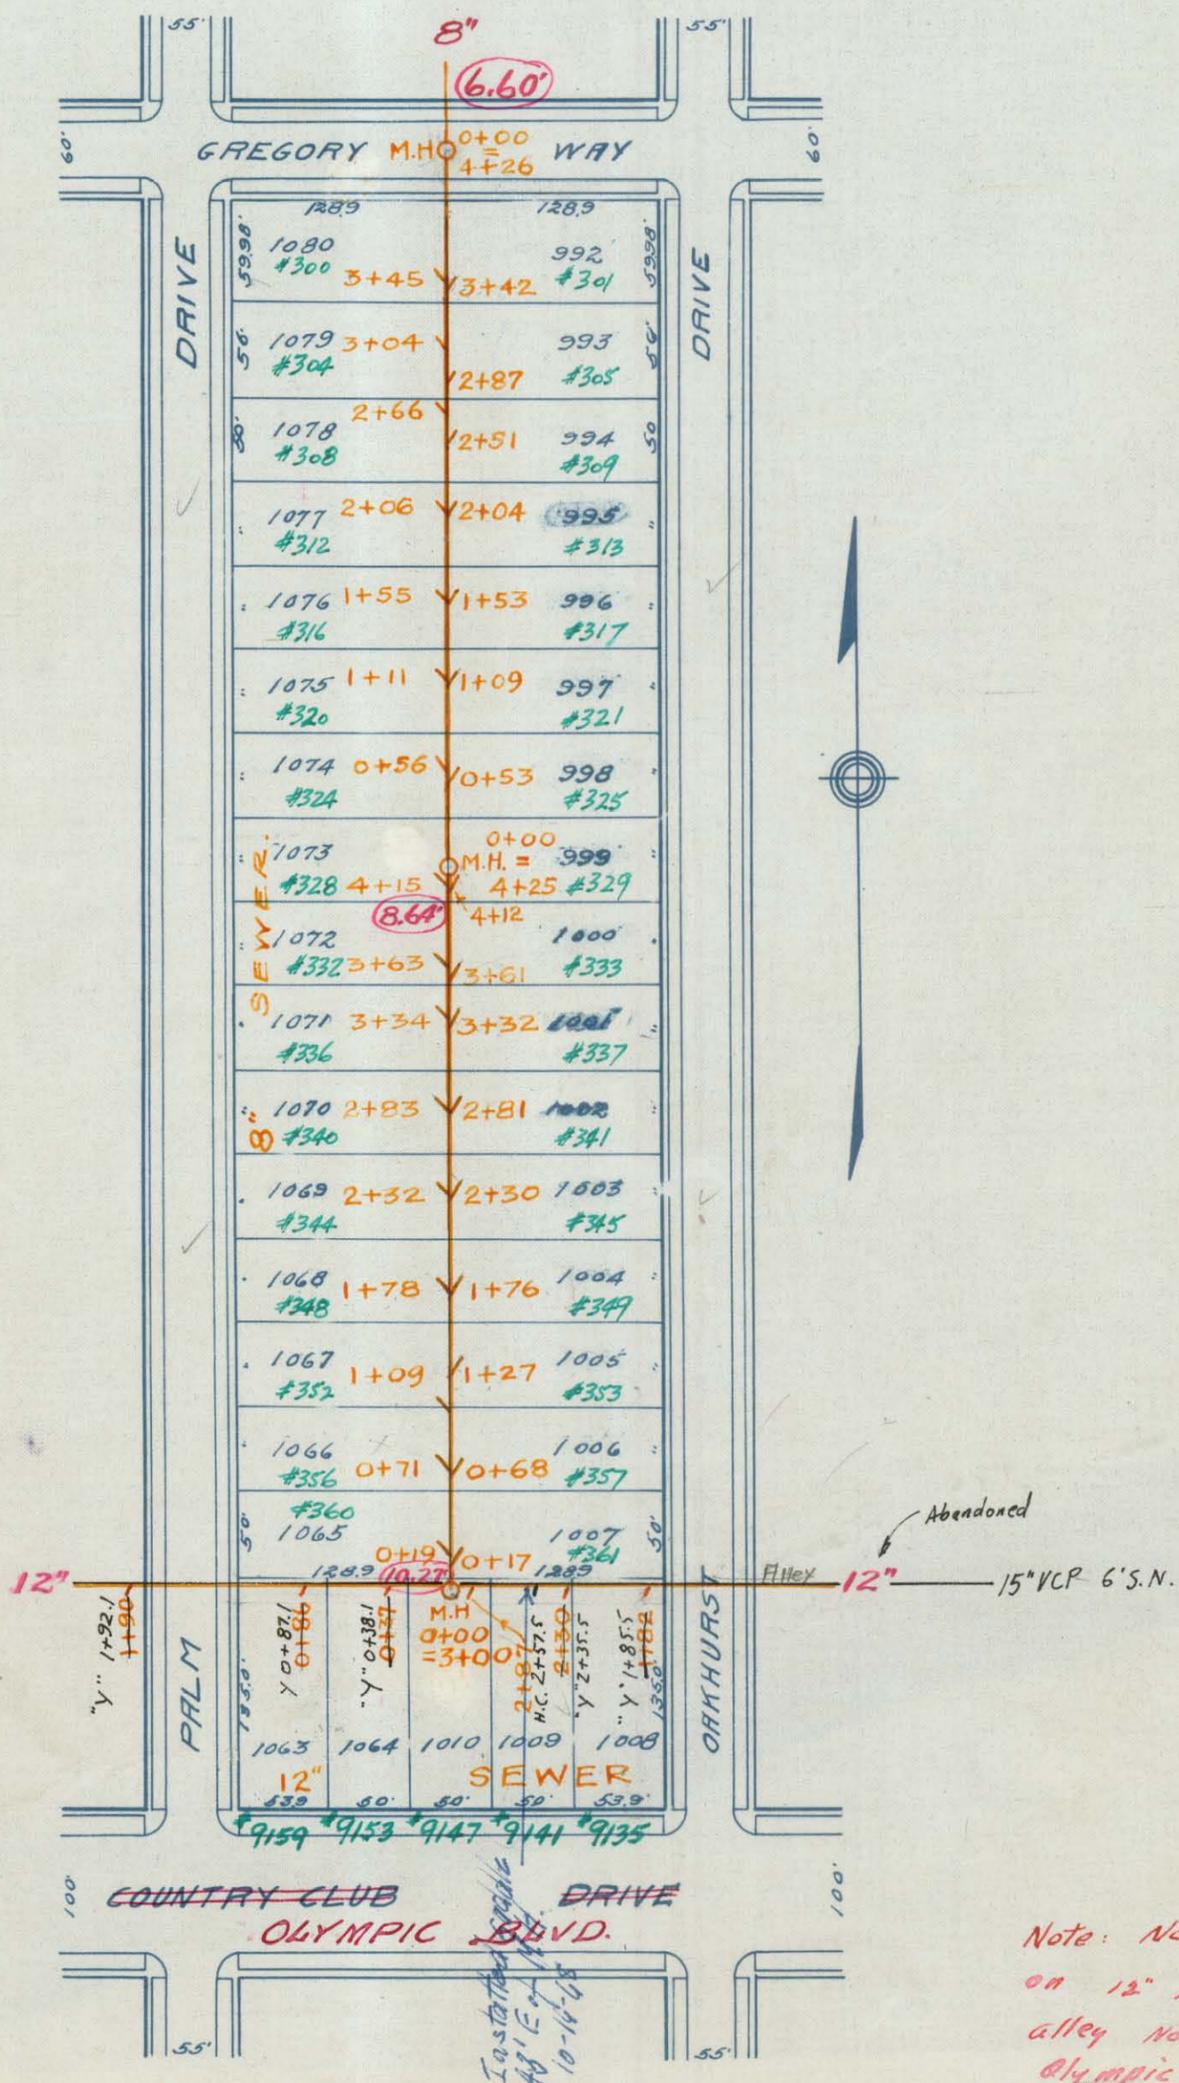


CITY OF BEVERLY HILLS  
 TRACT 6380  
 M.B. 69-11-20  
 SCALE 1"=100'  
 1926

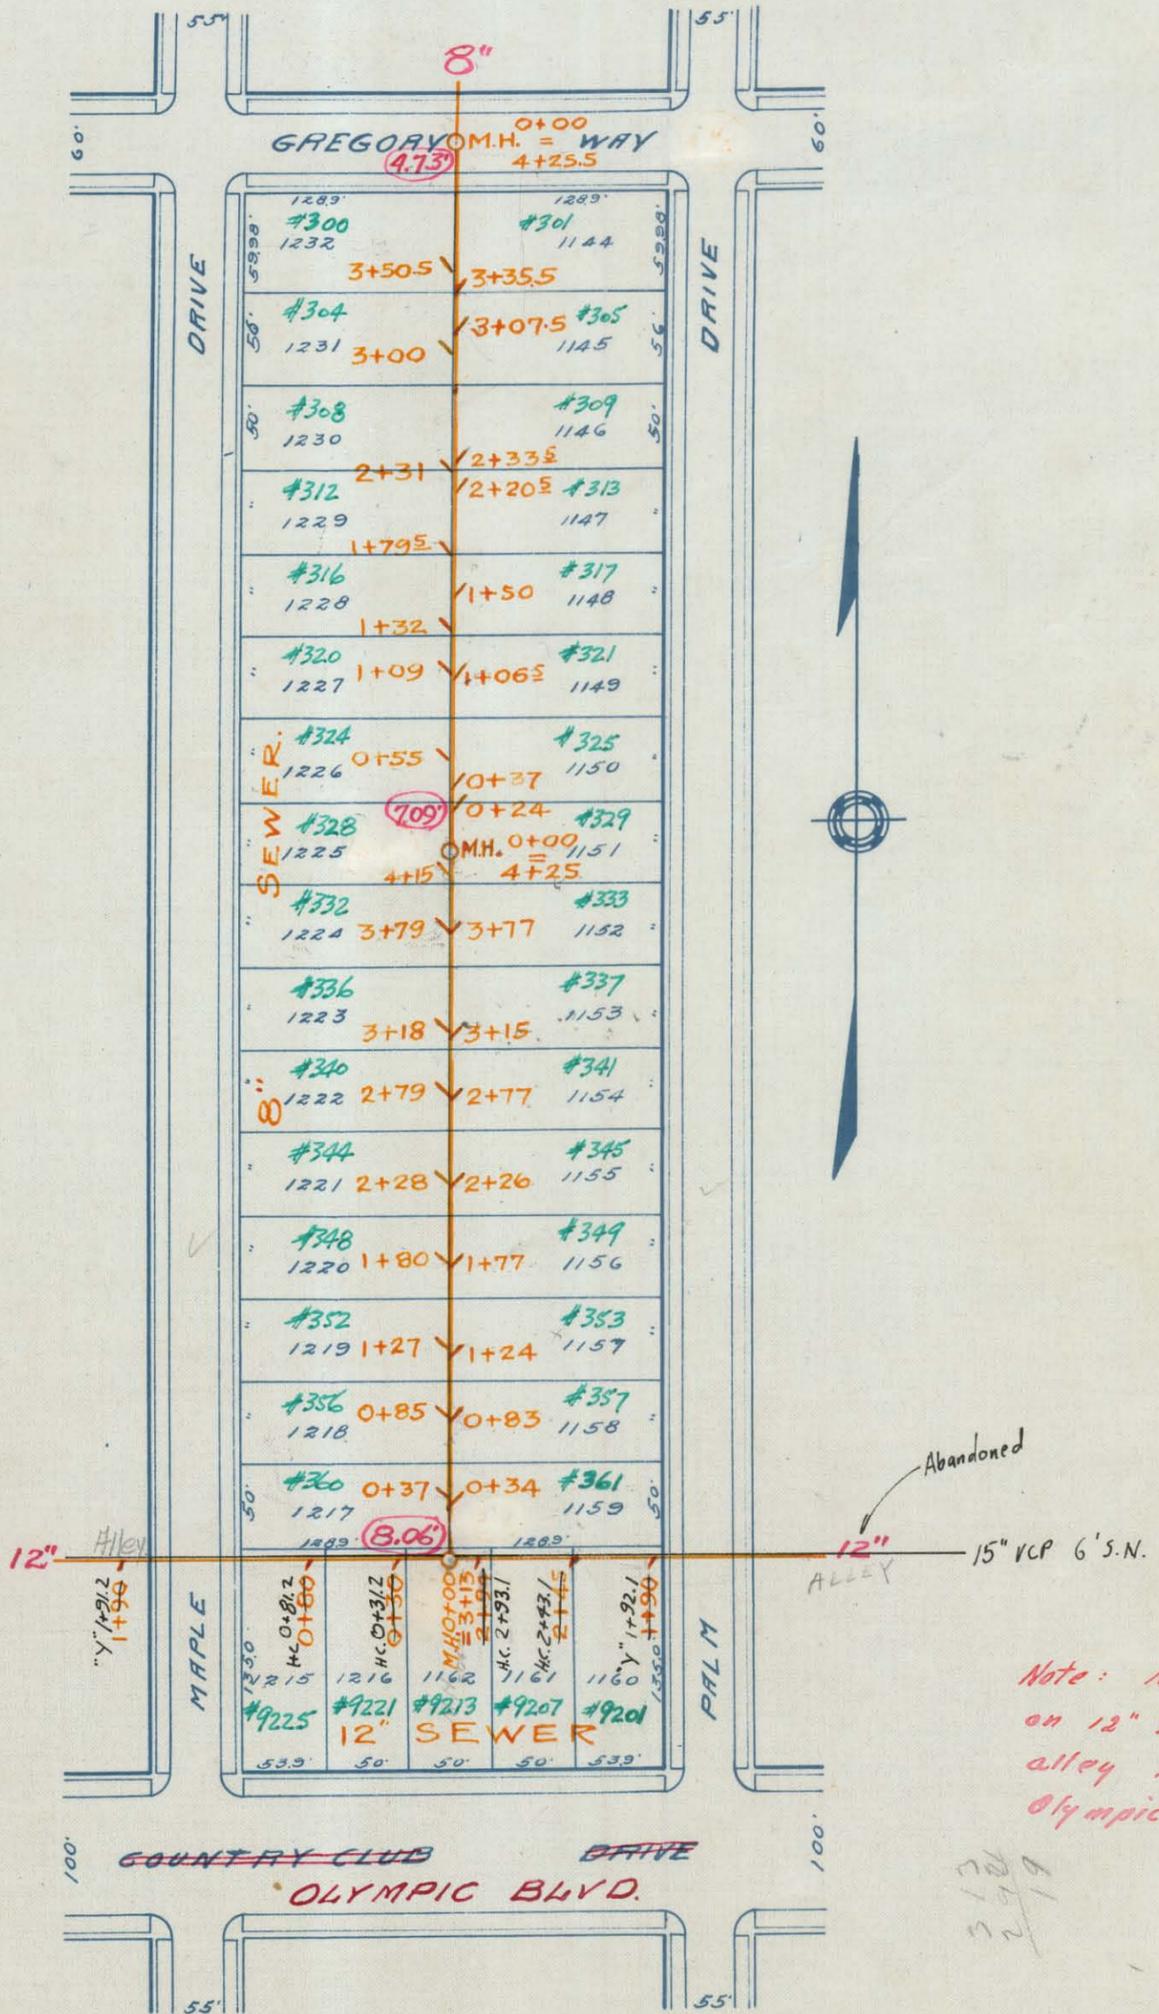

CITY OF BEVERLY HILLS  
 TRACT 6380  
 M.B. 69-11-20  
 SCALE 1"=100'  
 1926


39

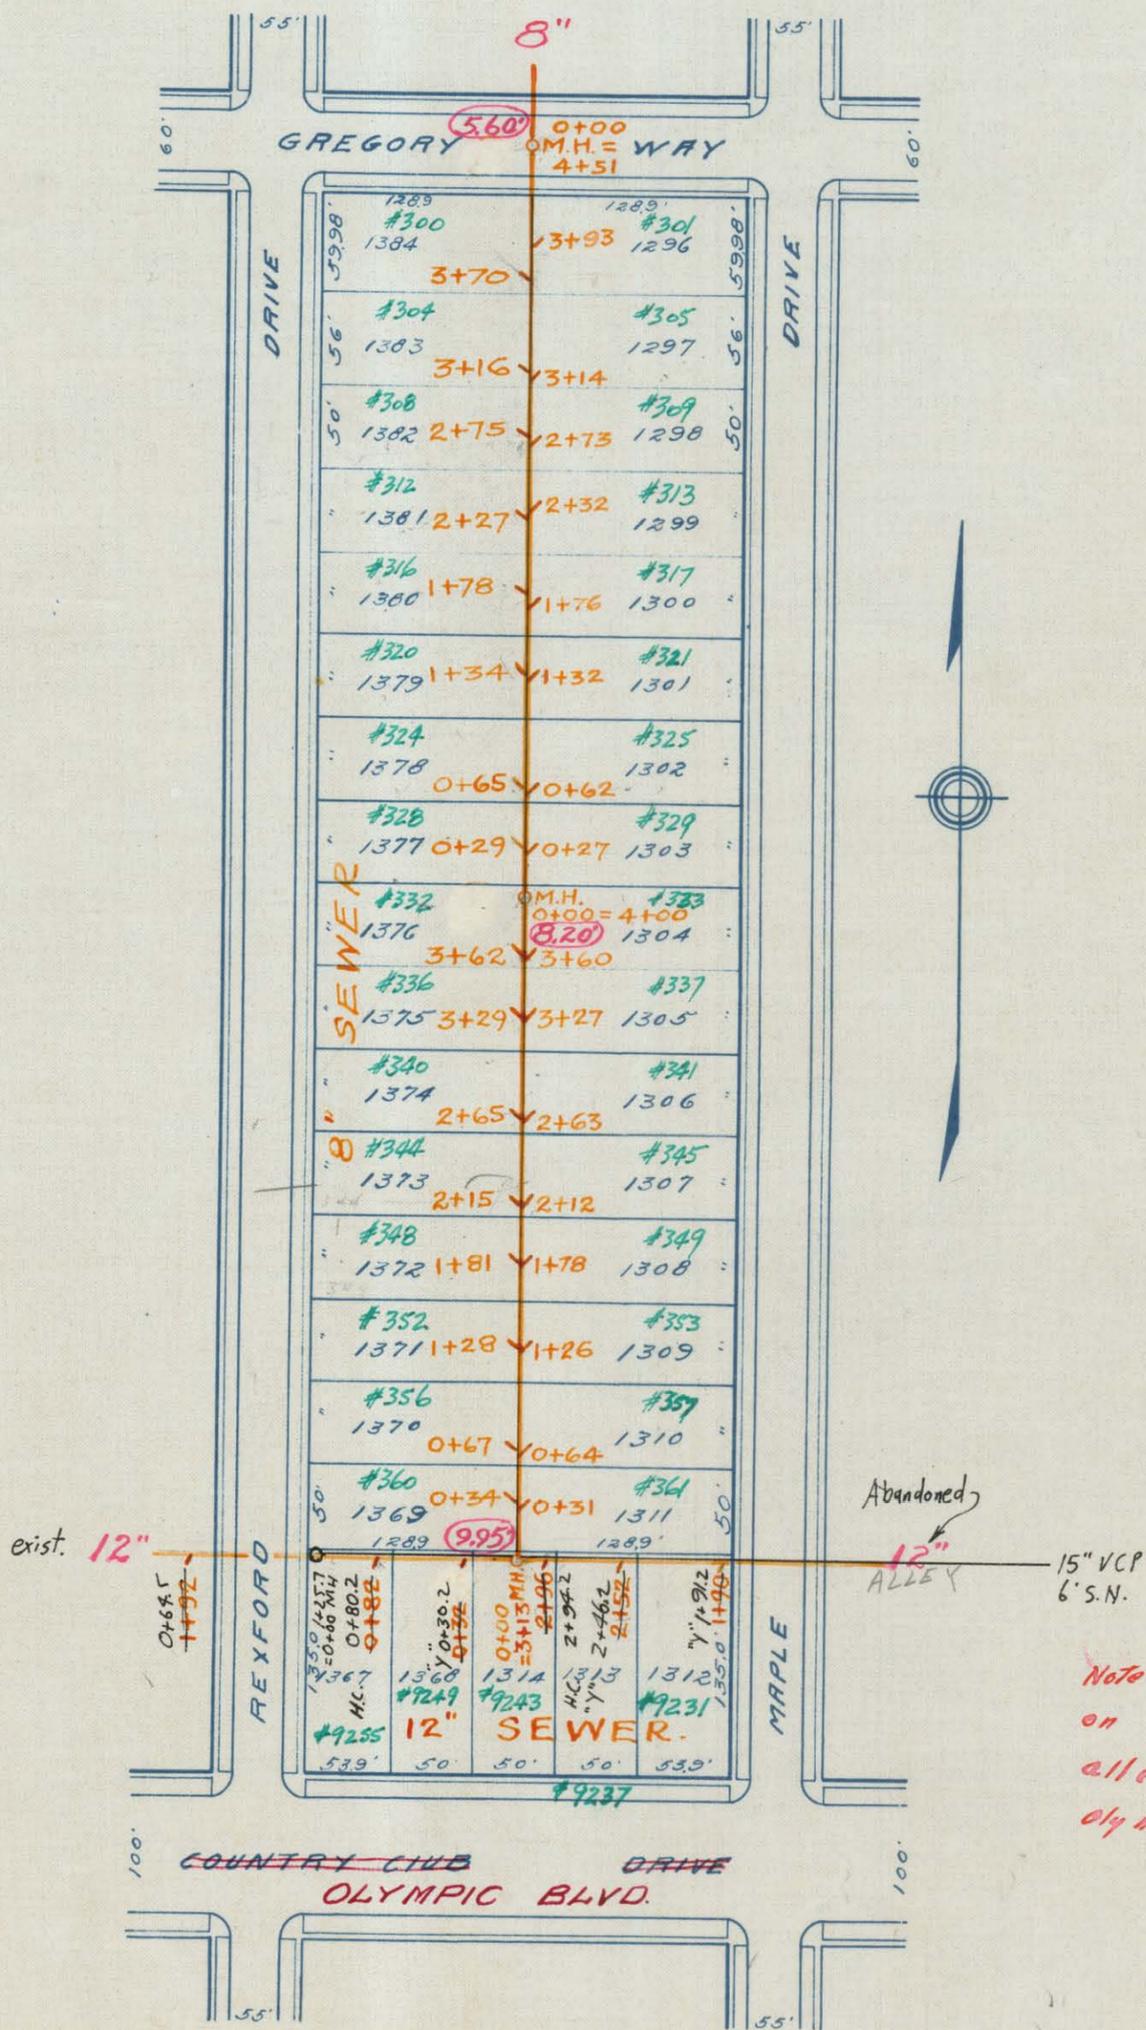

*Note: No Saddles on 12" line in alley North of Olympic*

CITY OF BEVERLY HILLS  
 TRACT 6380  
 M.B. 69-11-20  
 SCALE 1"=100'  
 -1926-


40

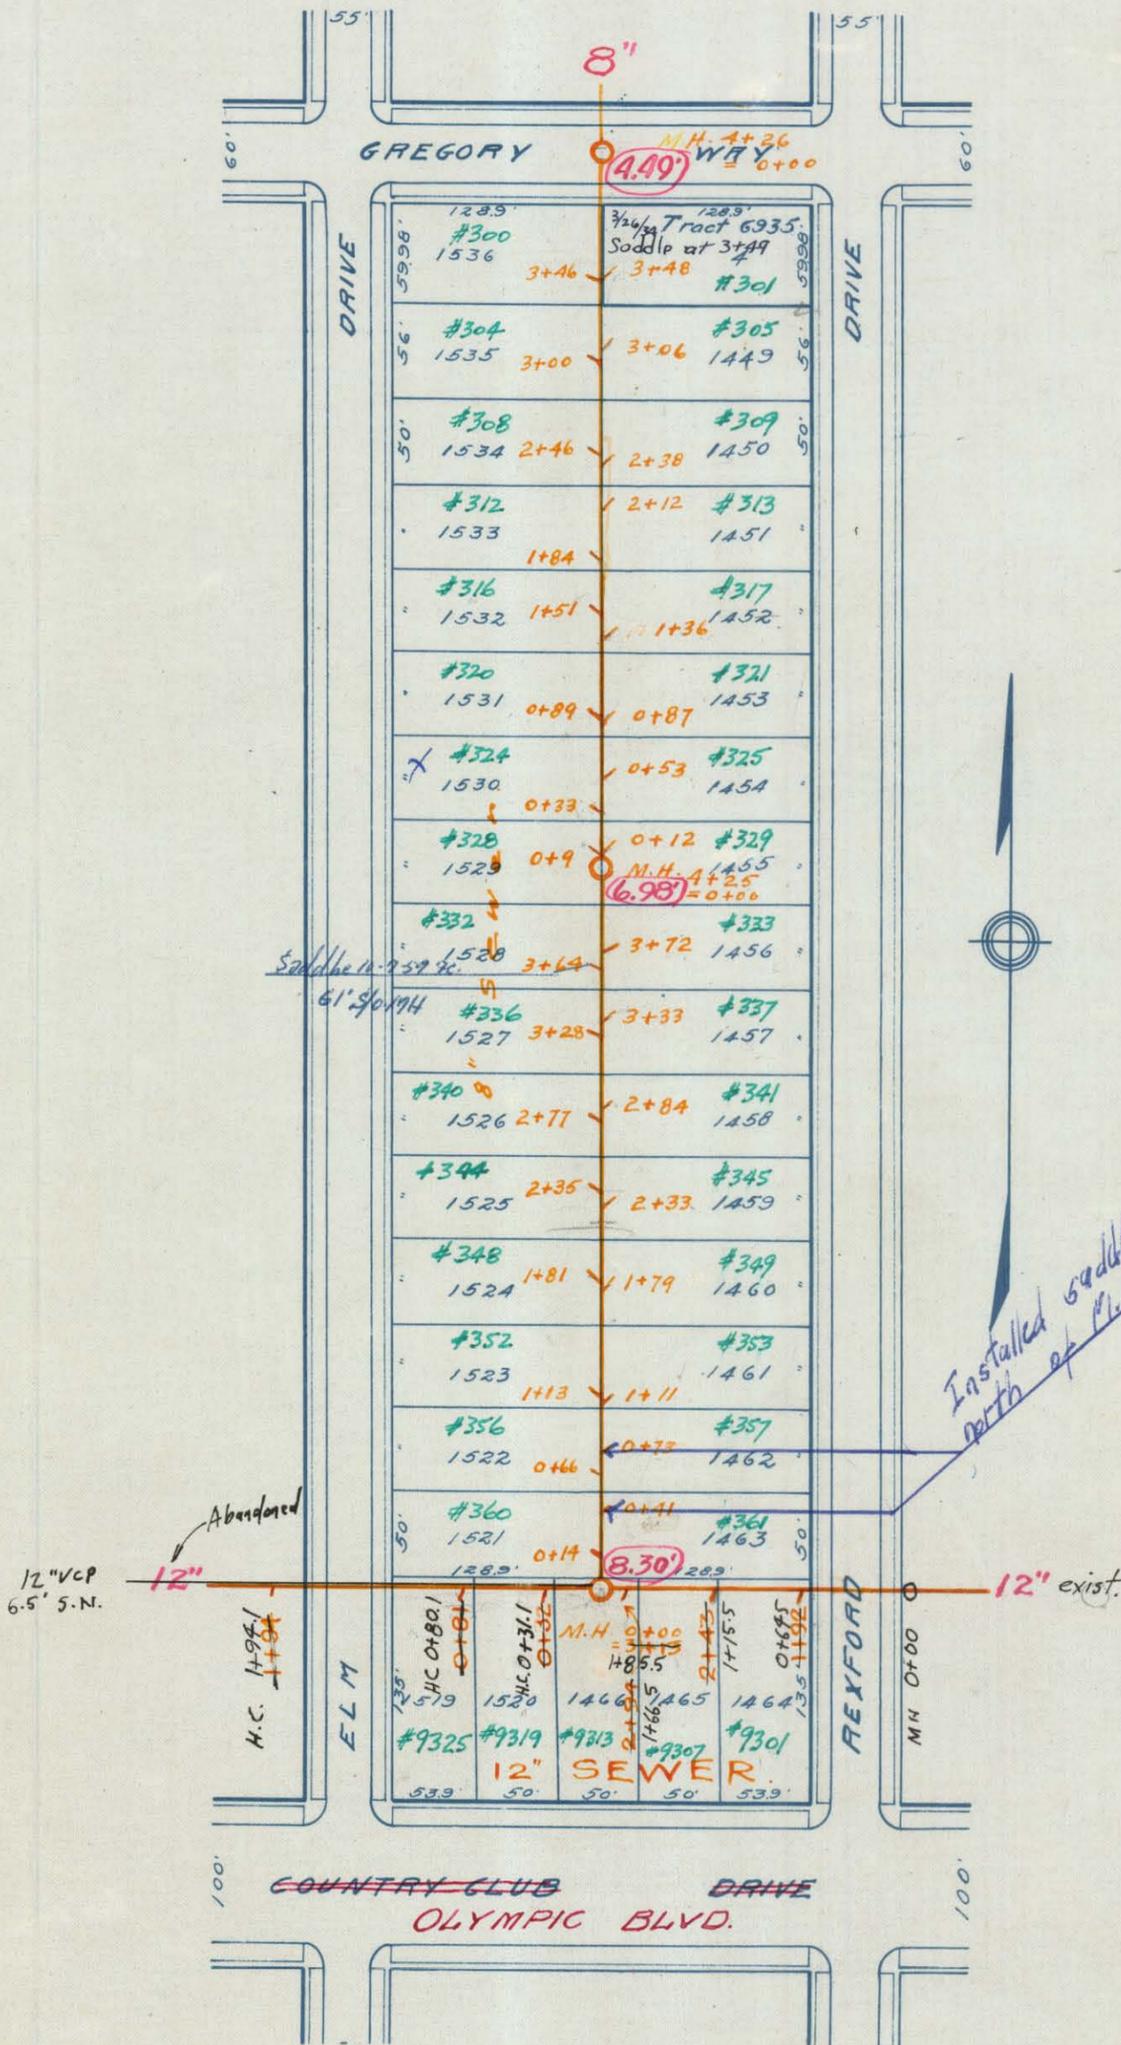

CITY OF BEVERLY HILLS  
TRACT 6380  
M. B. 69-11-20  
SCALE 1"=100'

1926

4

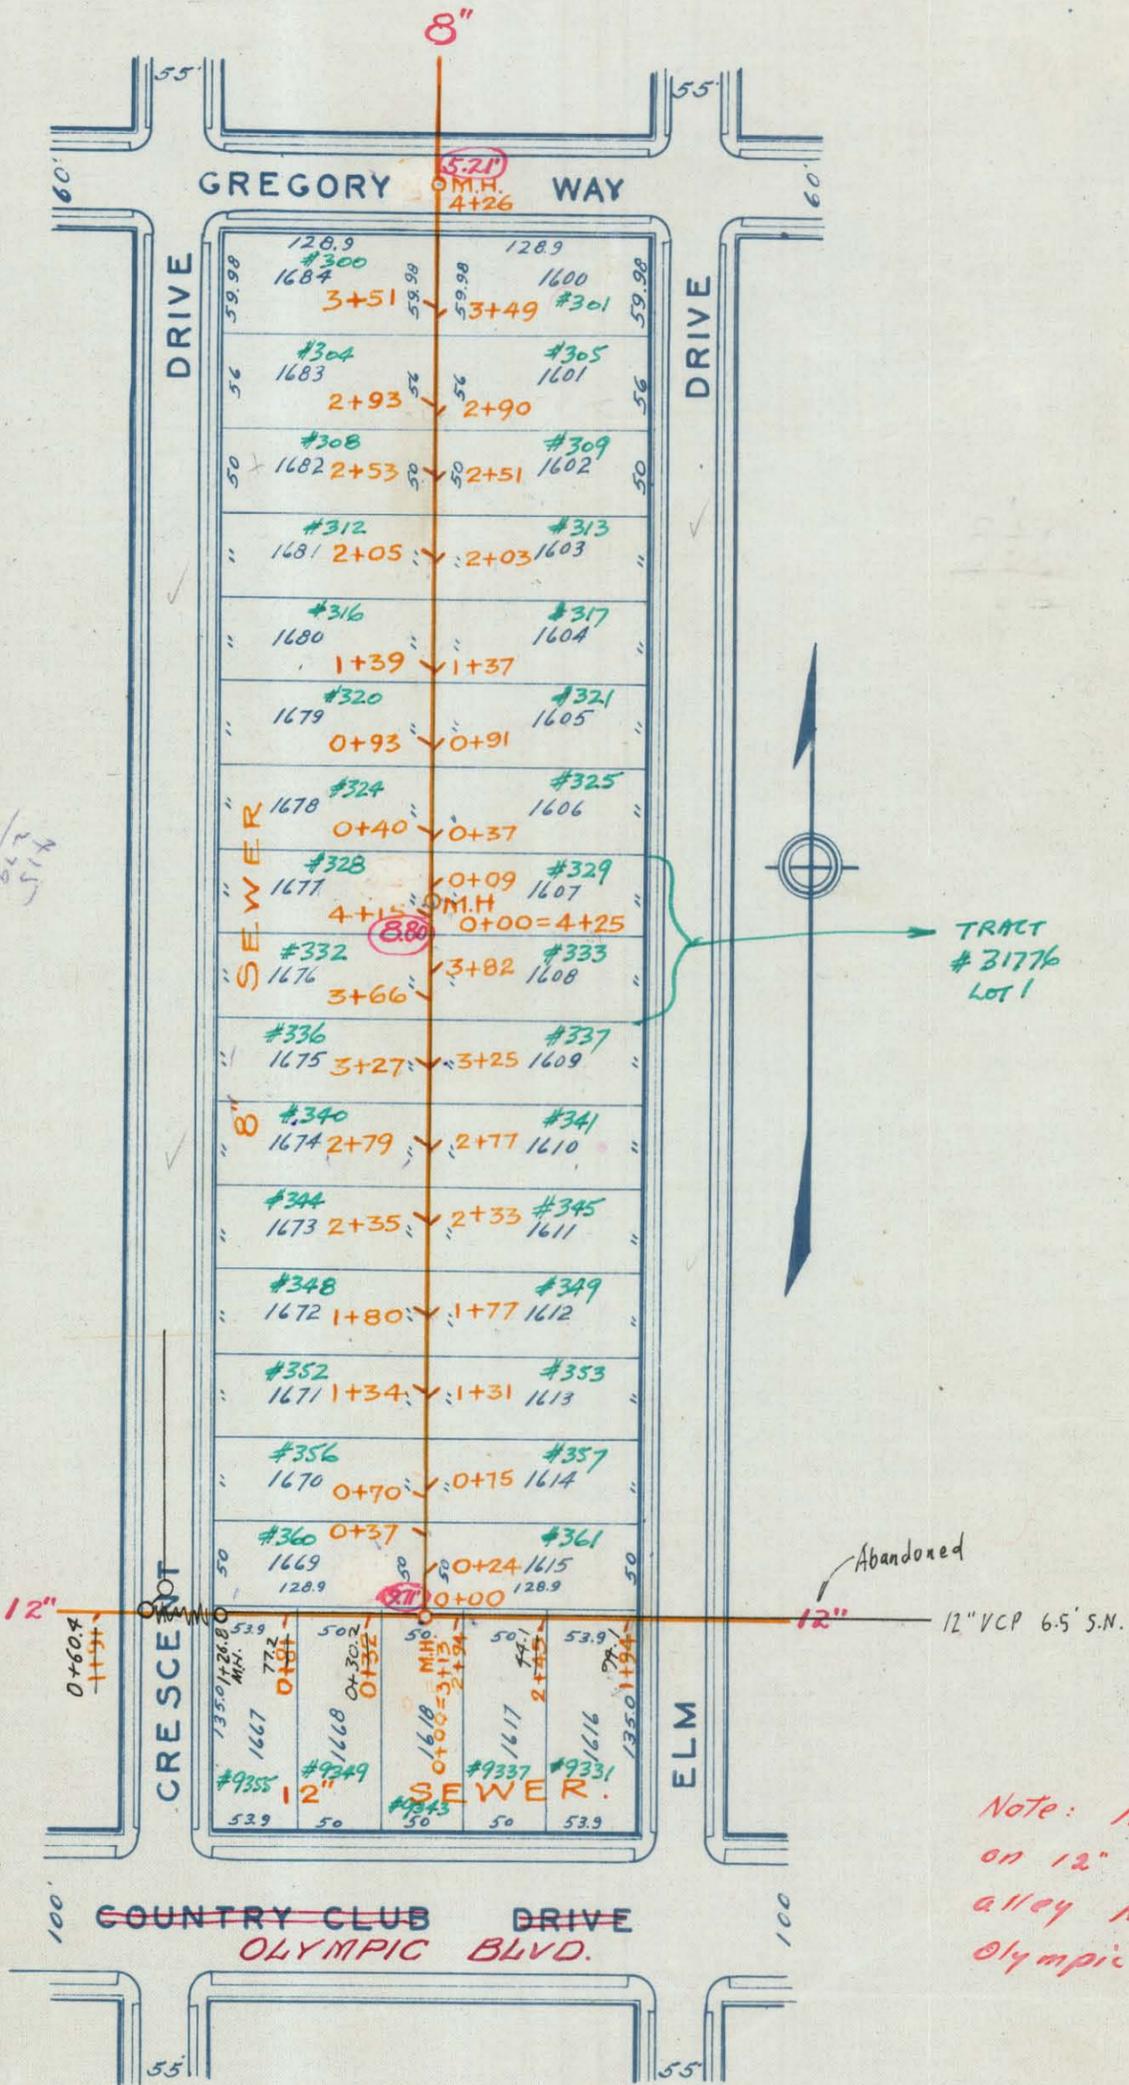


101  
517  
151

Note: No Saddles on 12" line in alley North of Olympic

CITY OF BEVERLY HILLS  
 TRACT 6380  
 M.B. 69-11-20  
 SCALE 1"=100'  
 -1926-

42

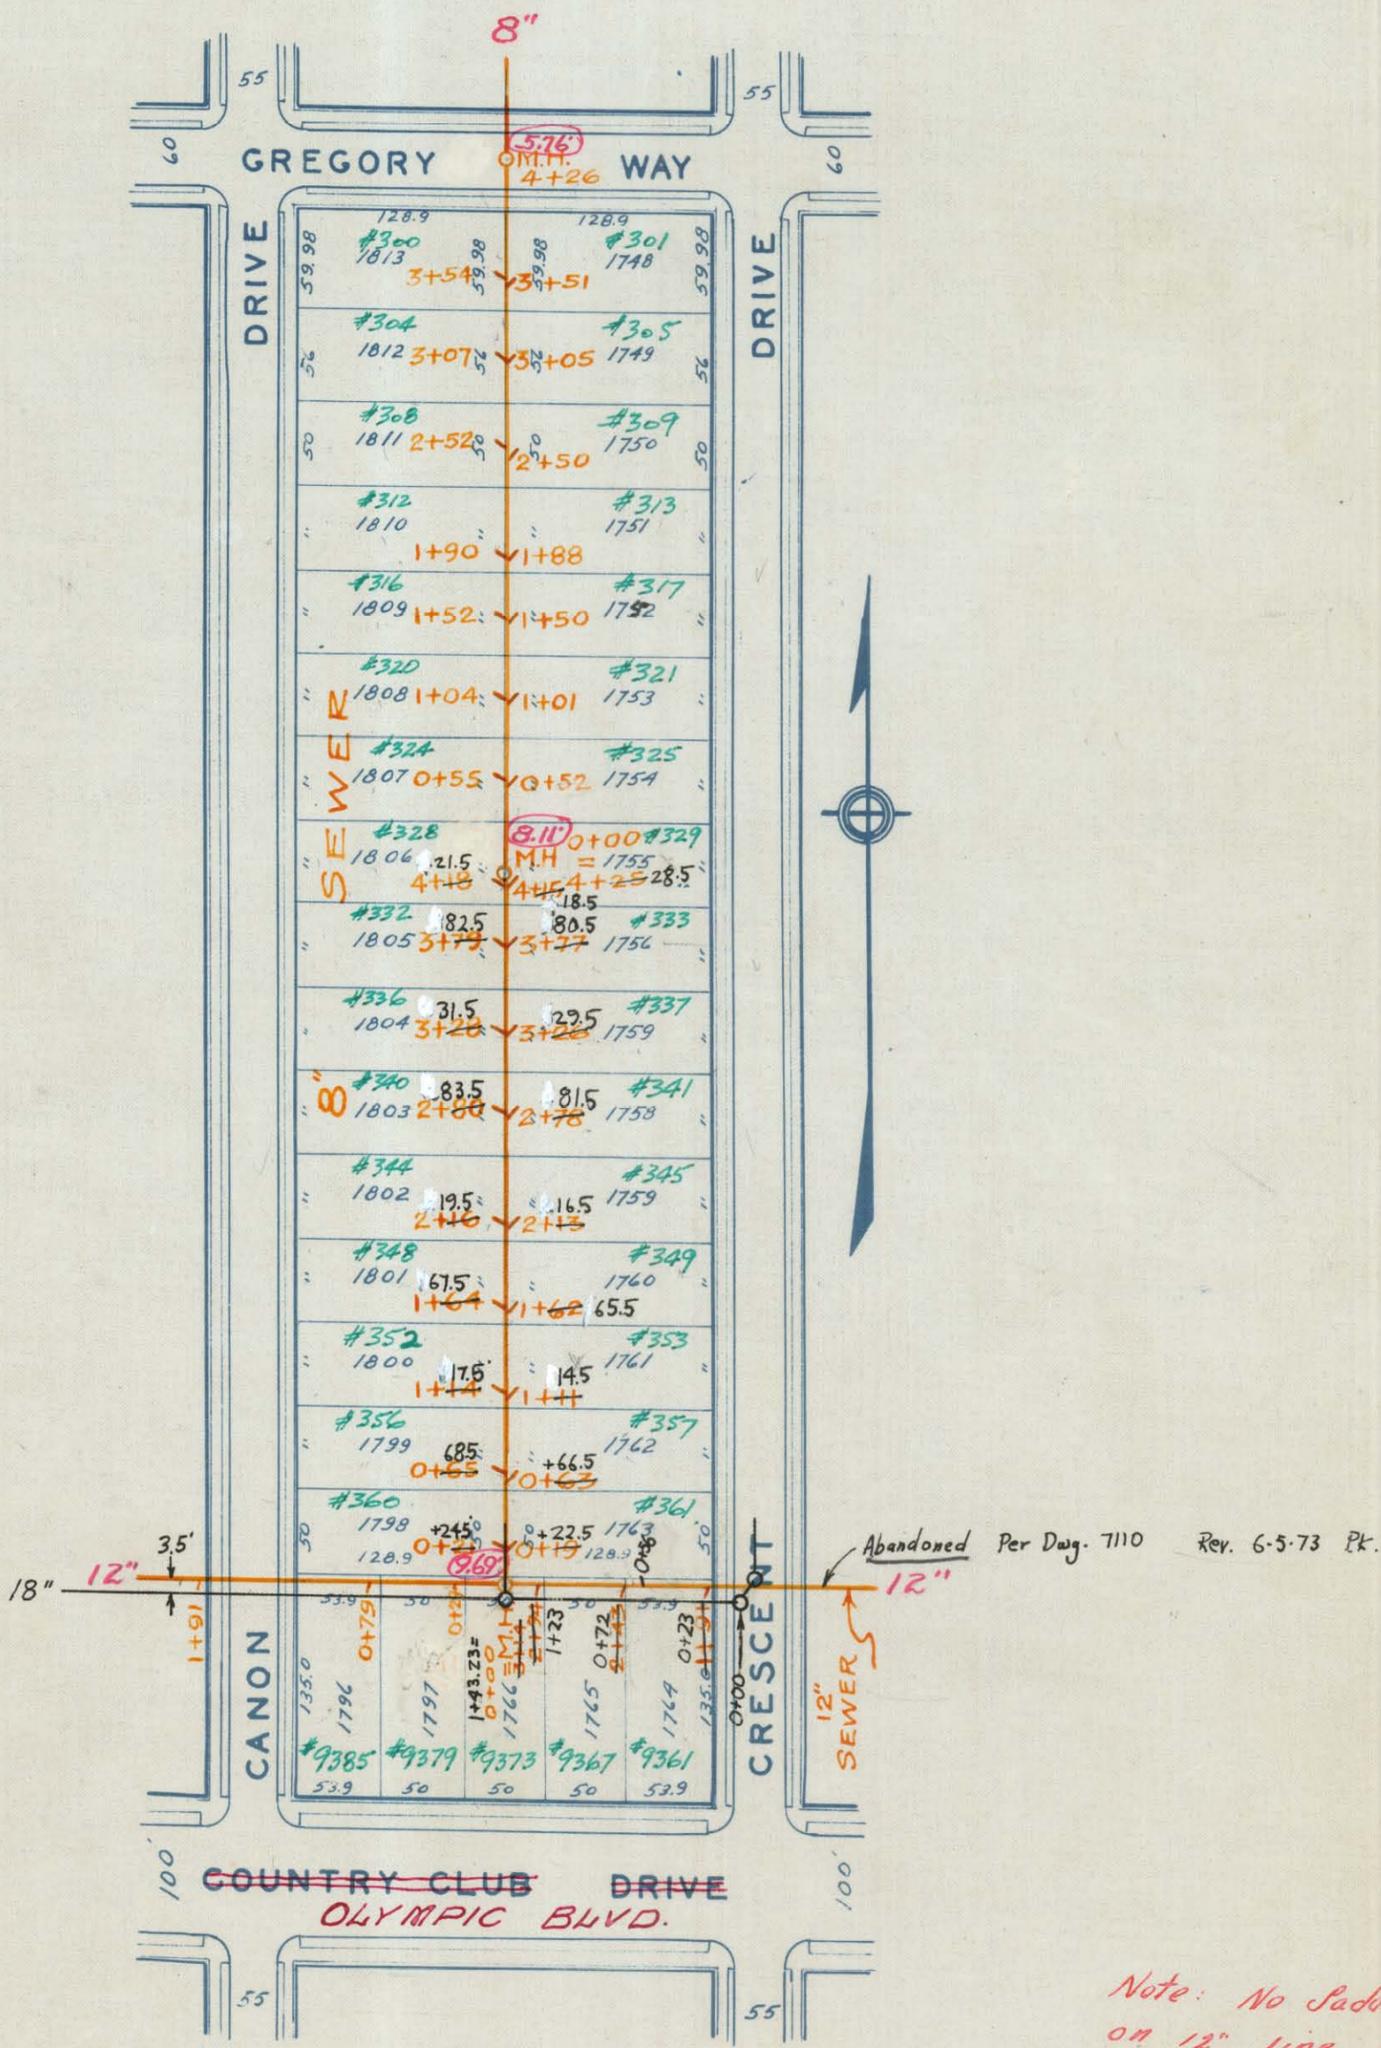

Note: No Saddles on 12" line in alley North of Olympic.

CITY OF BEVERLY HILLS  
 TRACT 6380  
 M.B 69-11-20  
 SCALE 1"=100'  
 -1926-

43

✓ 235  
191


✓ 226  
275  
171

TR. No. 42402

Installed Saddle 170'  
North of M.H. 10-11-63

313  
291  
22

137  
79  
59

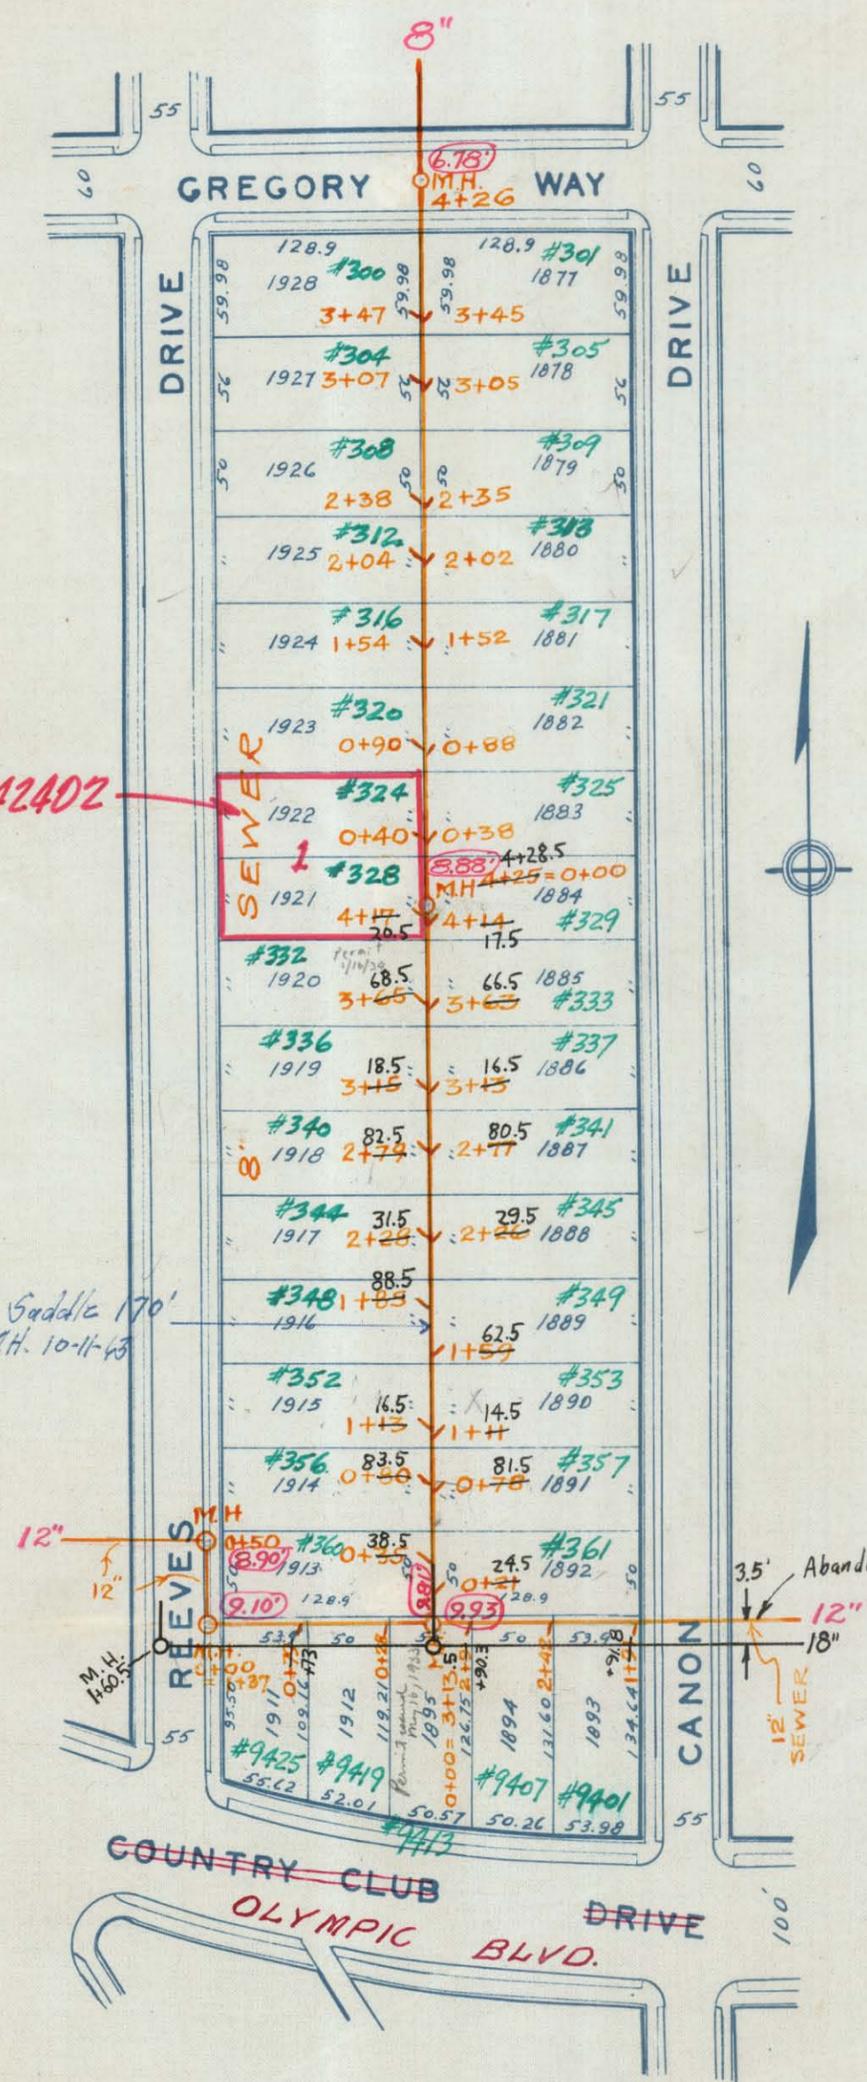

3.5' Abandoned per Dwg # 7110 Rev 6-5-73 P.K.


Note: No Saddles  
on 12" line in  
alley North of  
Olympic, and 12"  
line along Reeves.

CITY OF BEVERLY HILLS  
 TRACT 6380  
 M.B. 69-11-20  
 SCALE 1"=100'  
 -1926-

44




ENTER DATE OF PERMIT ON THIS SHEET

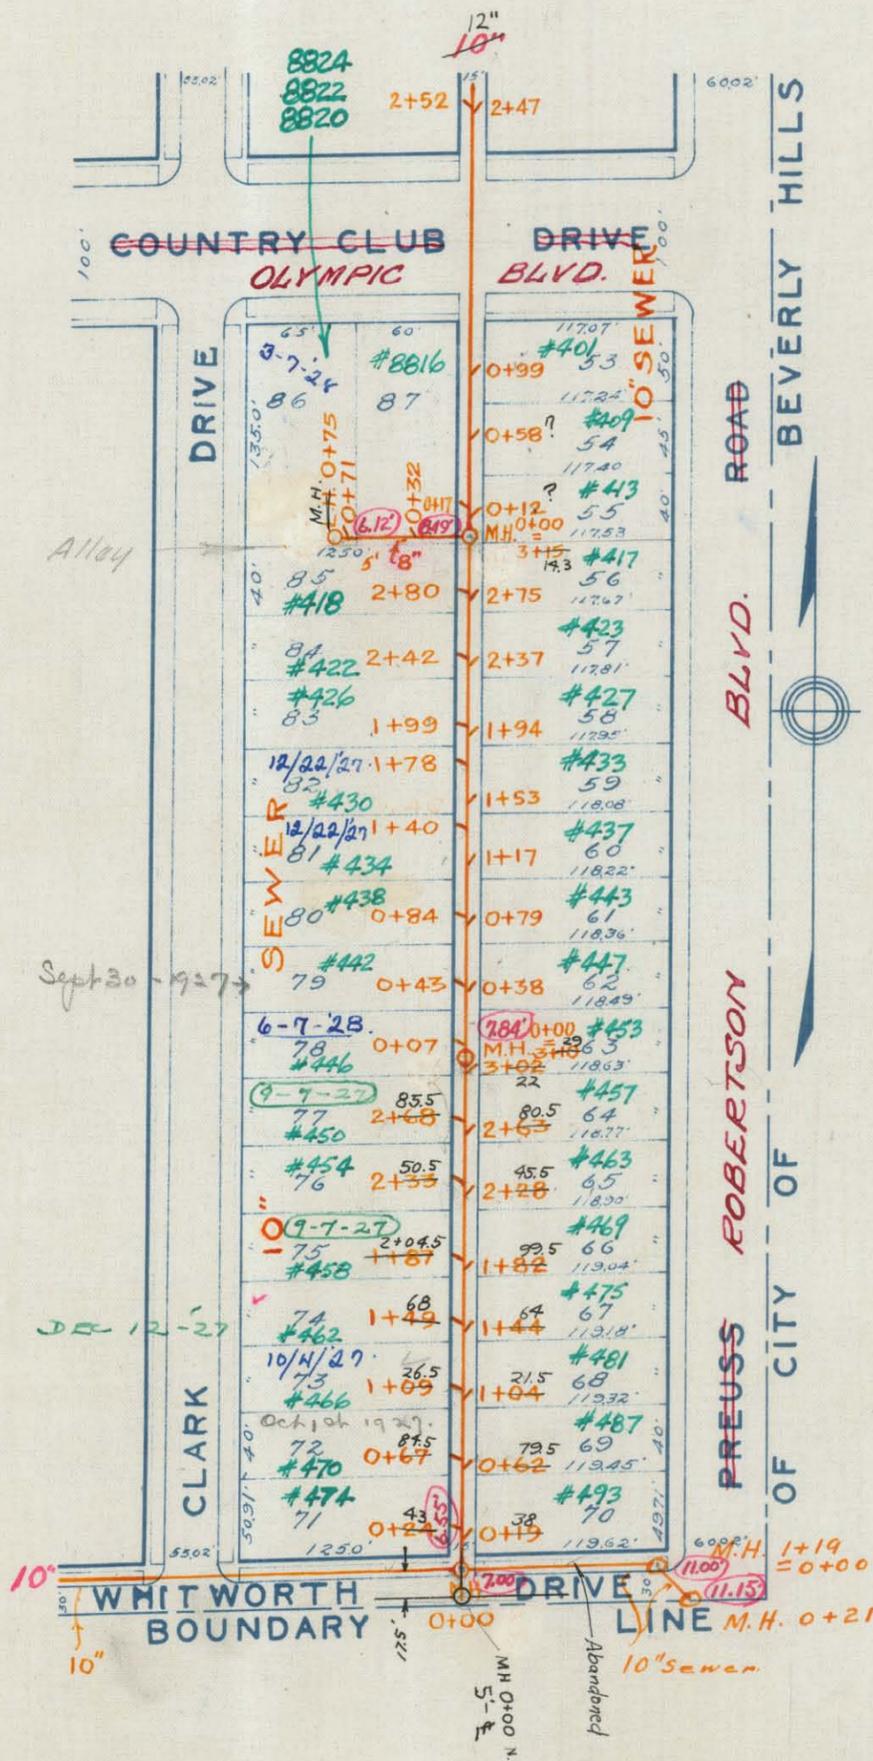

CITY OF BEVERLY HILLS  
 TRACT 6380  
 M.B. 69-11-20  
 SCALE 1"=100'  
 -1926-

46

COUNTRY CLUB DRIVE  
OLYMPIC BLVD.

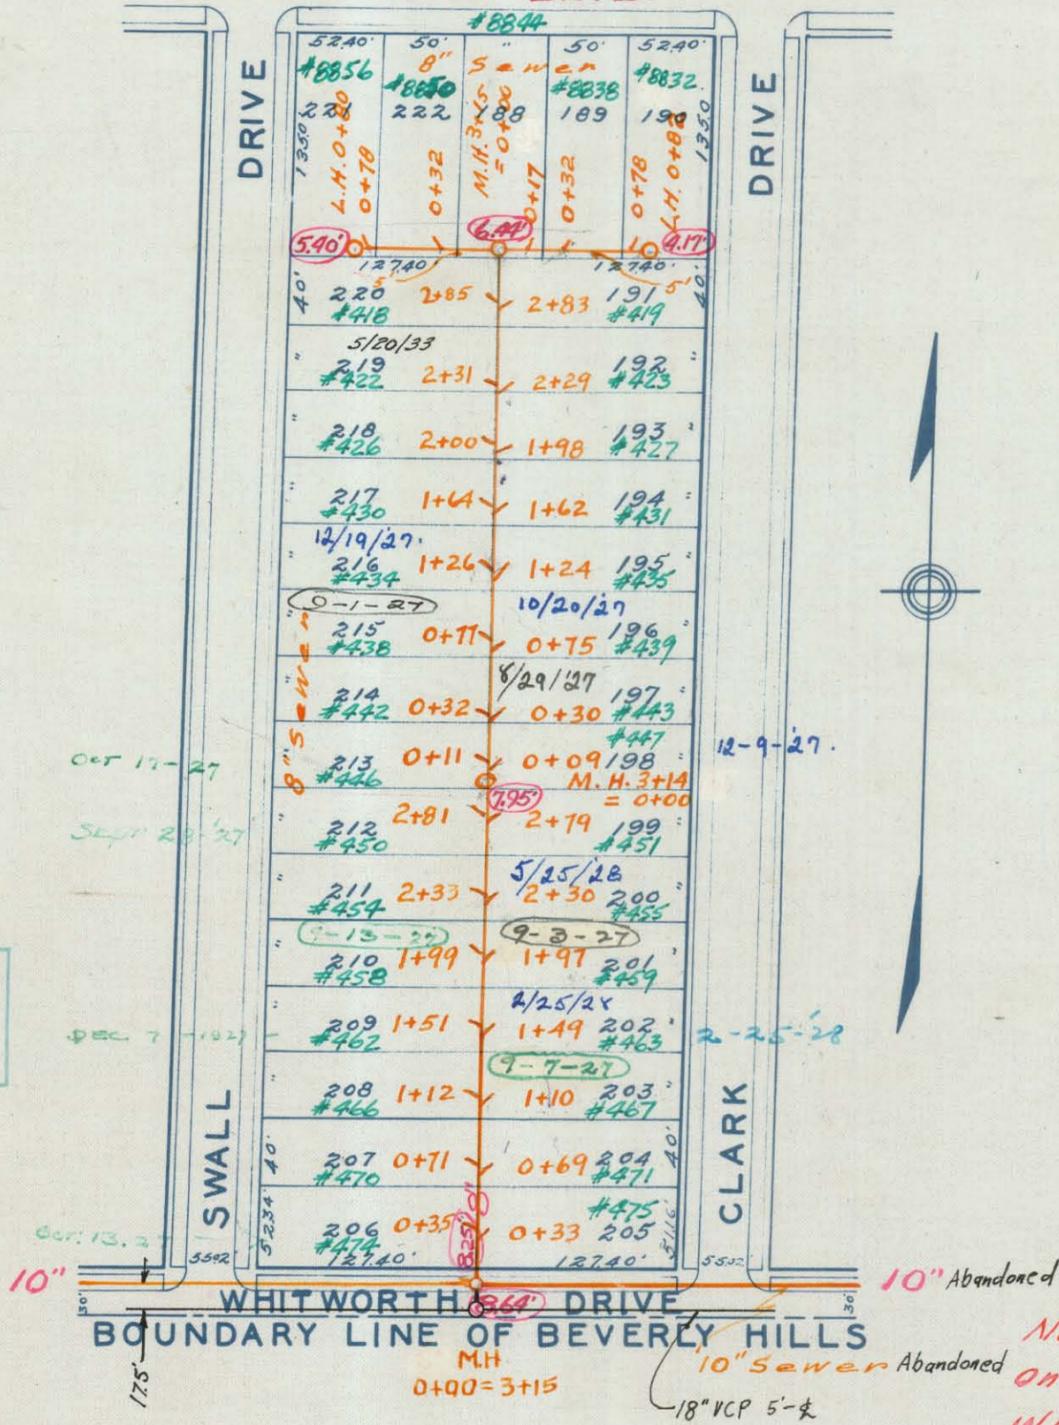


ENTER DATE OF PERMIT ON THIS SHEET

Note: No Saddles on 10" line along Whitworth

CITY OF BEVERLY HILLS  
TRACT 6380  
M.B. 69-11-20  
SCALE 1"=100'

47

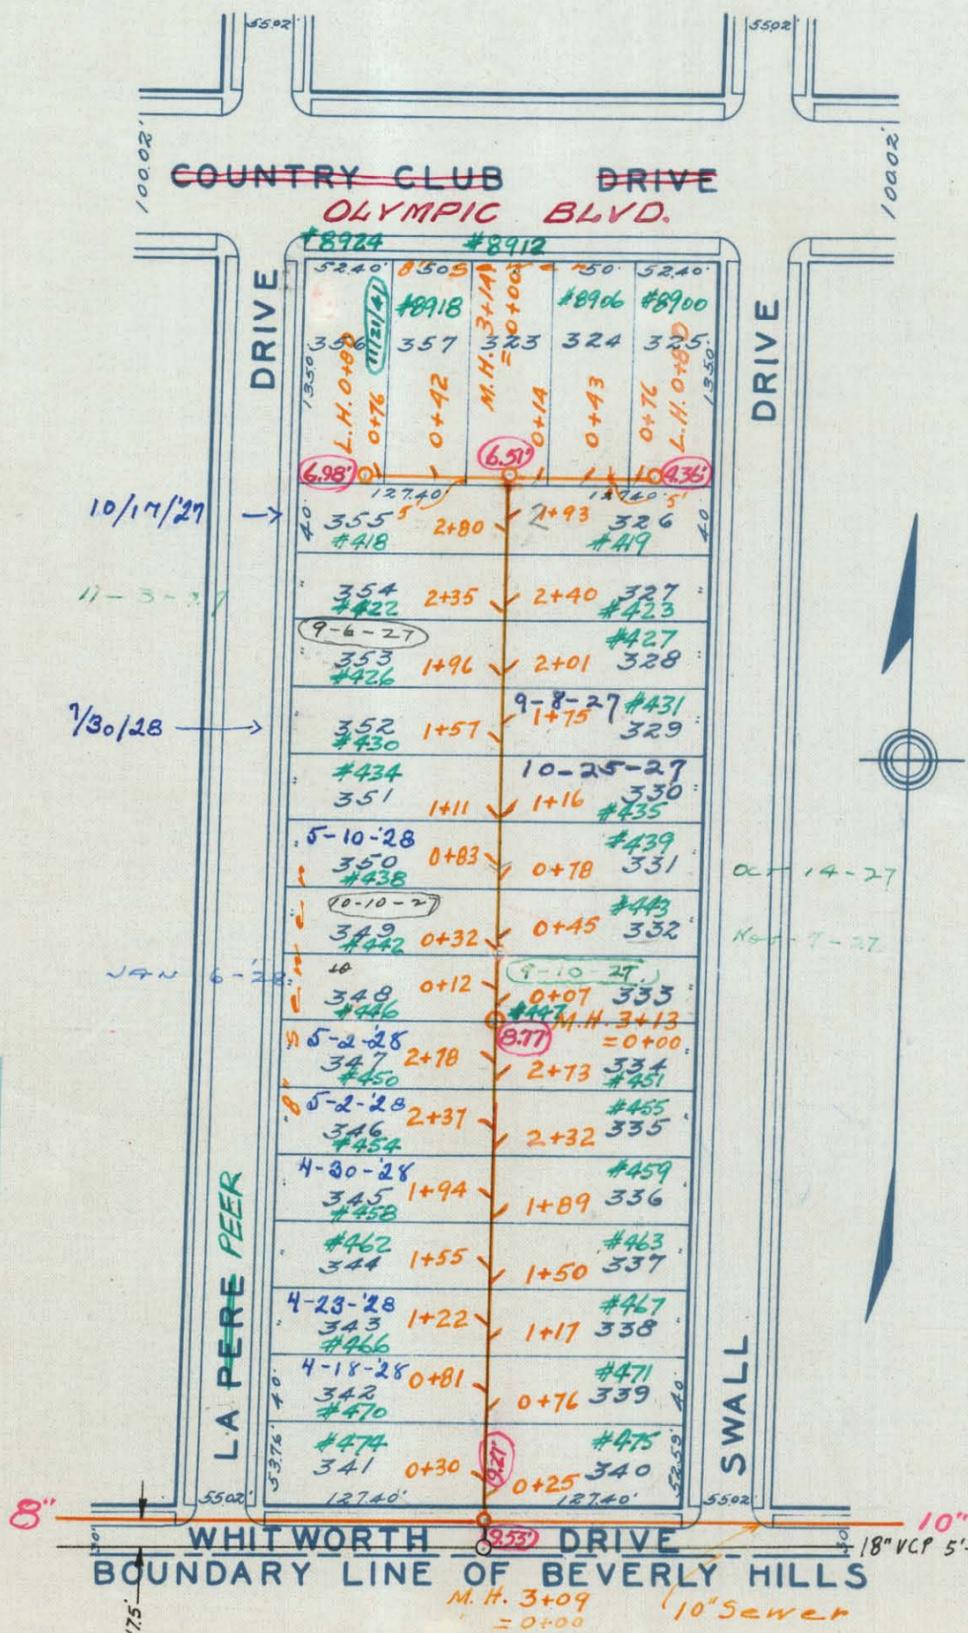

ENTER DATE OF PERMIT ON THIS STREET


Note: No Saddles on 10" and 8" lines along Whitworth

CITY OF BEVERLY HILLS  
 TRACT 6380.  
 M.B. 69-11-20.  
 SCALE 1"=100'

48





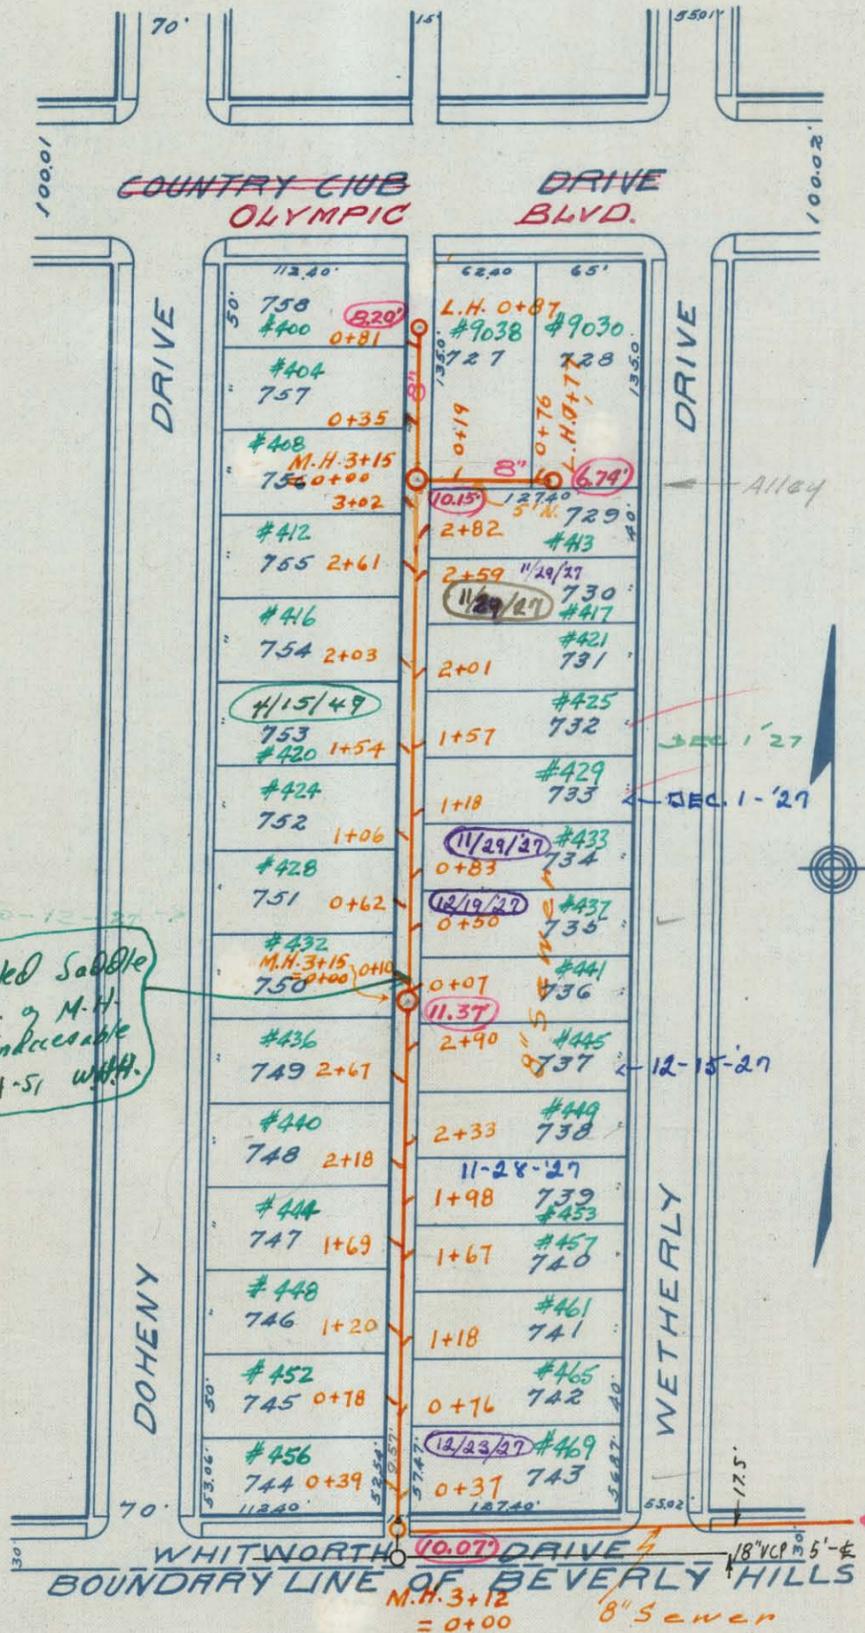


Mistaken saddle  
in no. of M.H.  
w/pe inaccessible  
p. 24-51 w/119.


ENTER DATE OF PERMIT ON  
THIS SHEET

Note: No Saddles  
on 8 inch line along  
Whitworth.

CITY OF BEVERLY HILLS  
TRACT 6380  
M.B. 69-11-20  
SCALE 1"=100'

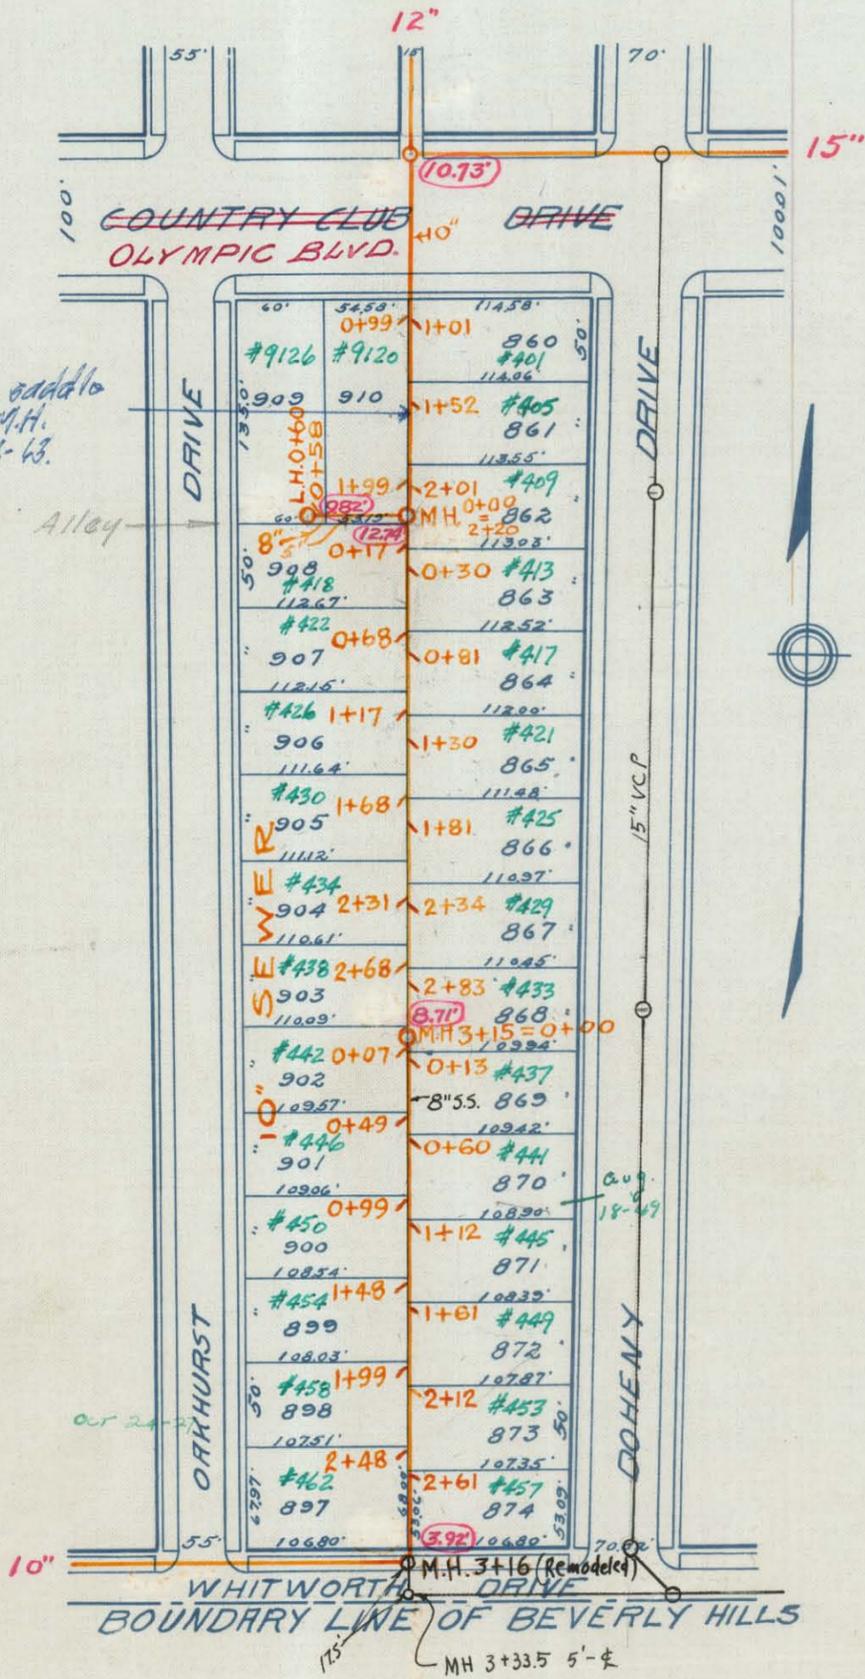

CITY OF BEVERLY HILLS  
 TRACT 6380  
 M.B. 69-11-20  
 SCALE 1"=100'  
 -1926-

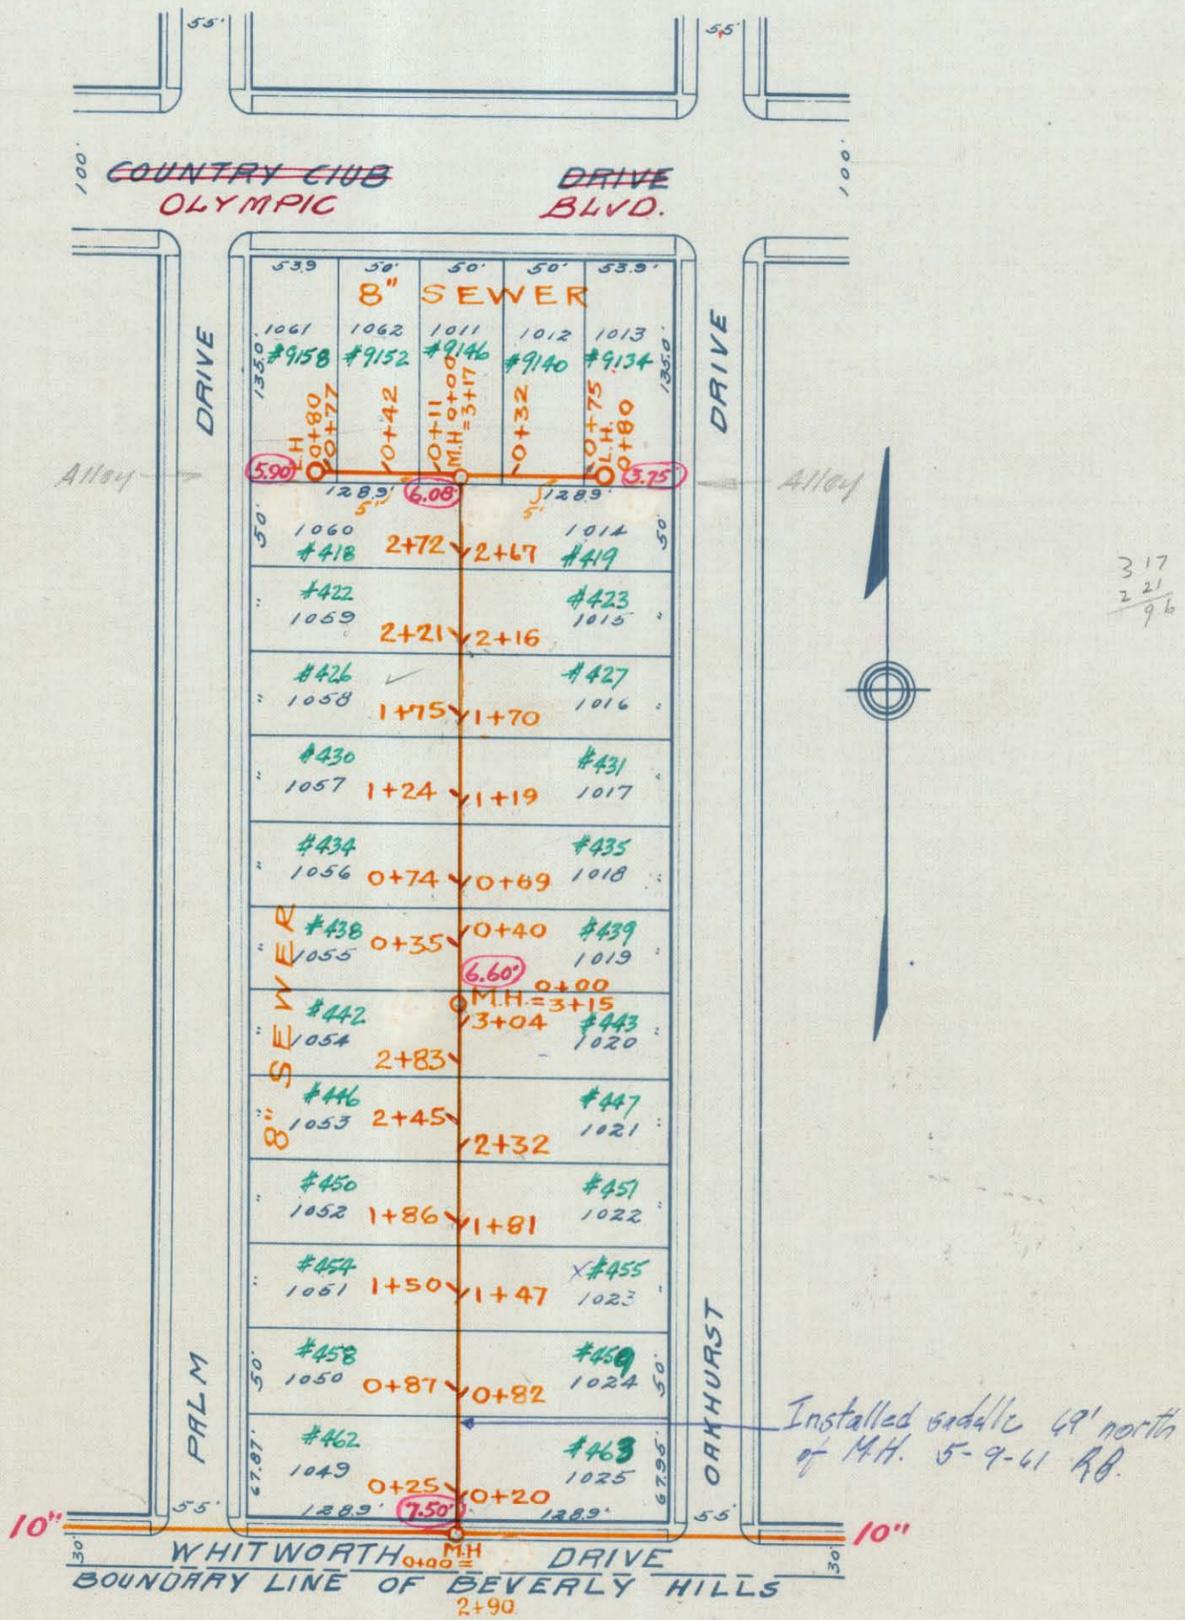

3 17  
 2 21  
 9 6  
 3 17  
 1 71  
 1 02


Installed saddle 49' north of M.H. 5-9-61 R.B.

CITY OF BEVERLY HILLS  
 TRACT 6380  
 M.B. 69-11-20  
 SCALE 1"=100'  
 -1926-

53






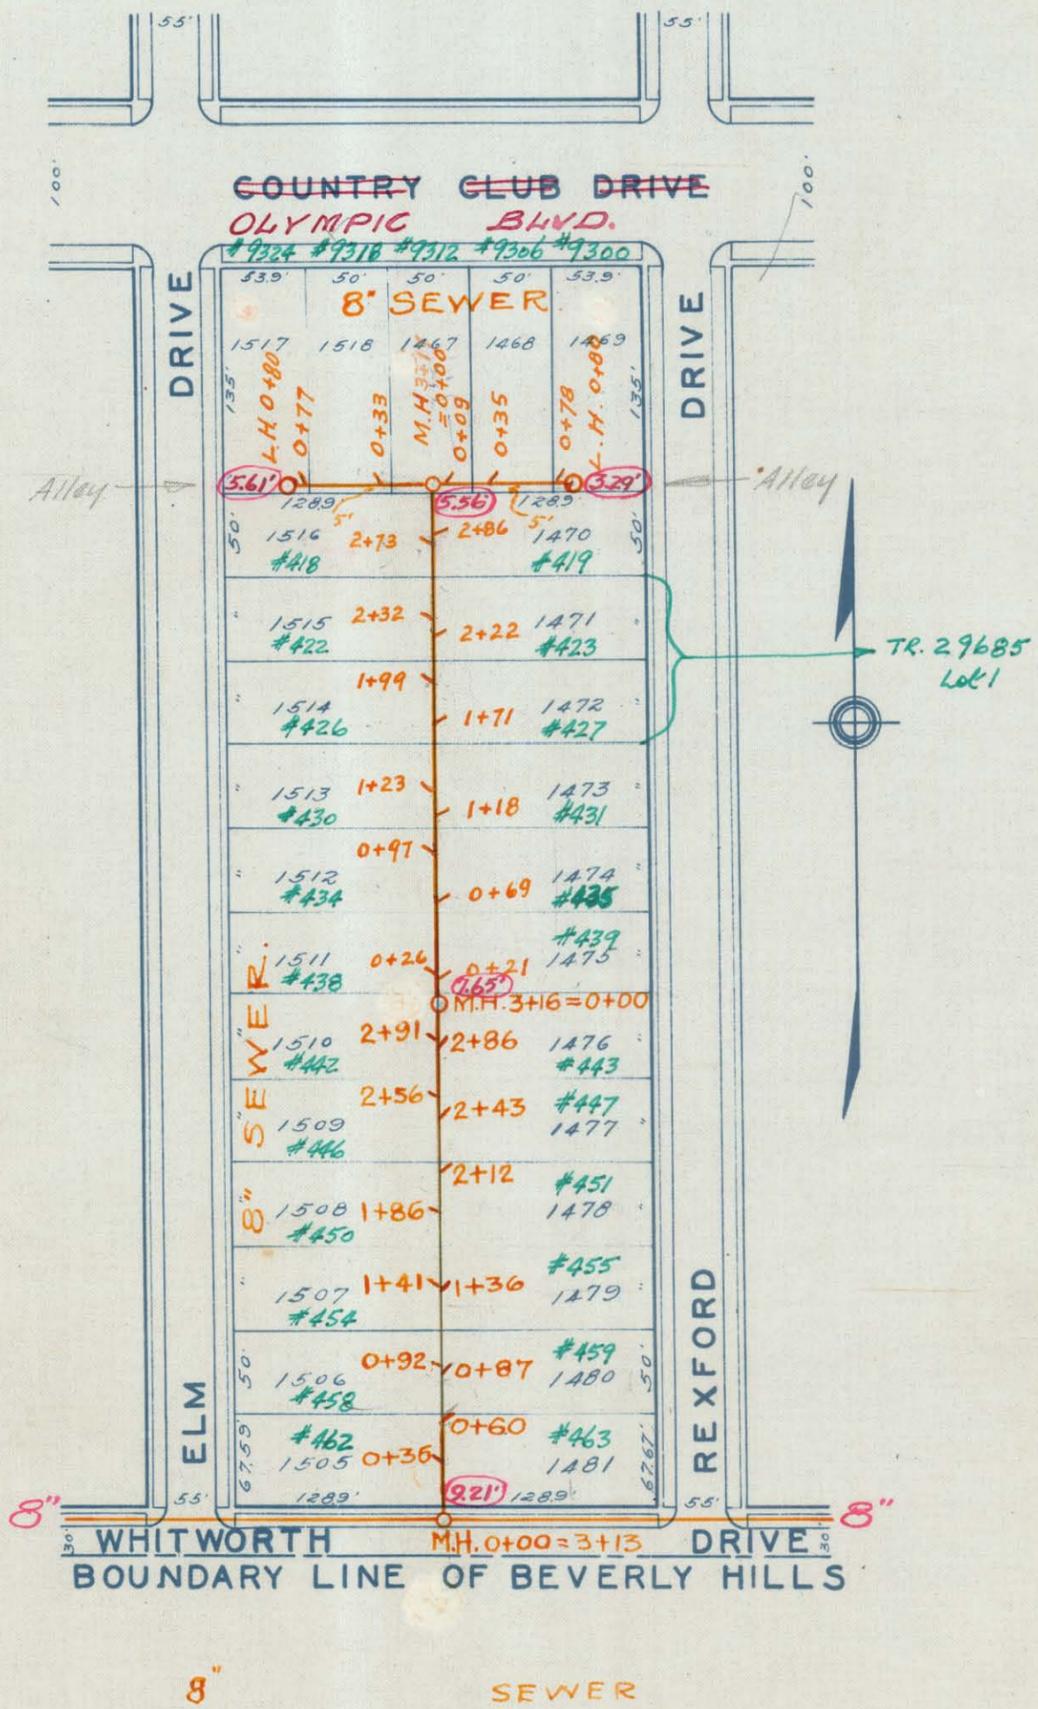

**CITY OF BEVERLY HILLS**  
 TRACT 6380  
 M. B. 69-11-20  
 SCALE 1"=100'  
 -1926-


56

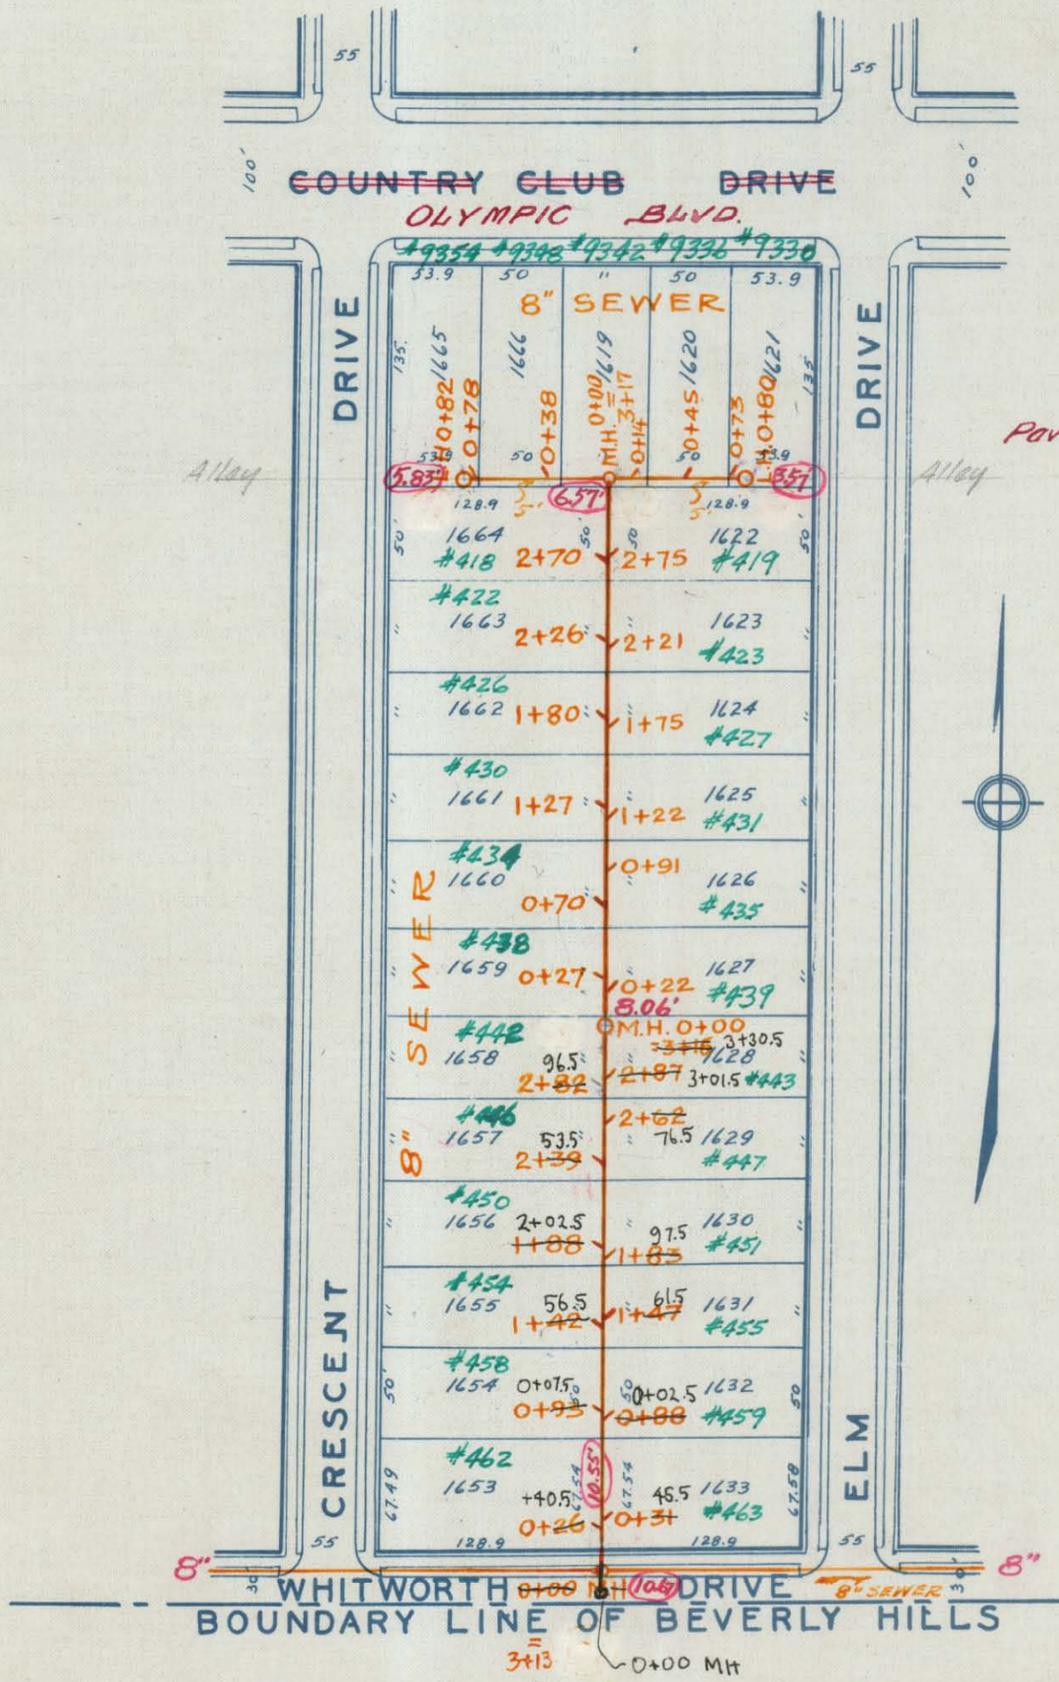

Pav.: Cross Alley only - 4"  
 Oil + Rock.  
 "Ys" only.

CITY OF BEVERLY HILLS  
 TRACT 6380  
 M.B. 69-11-20  
 SCALE 1"=100'

57

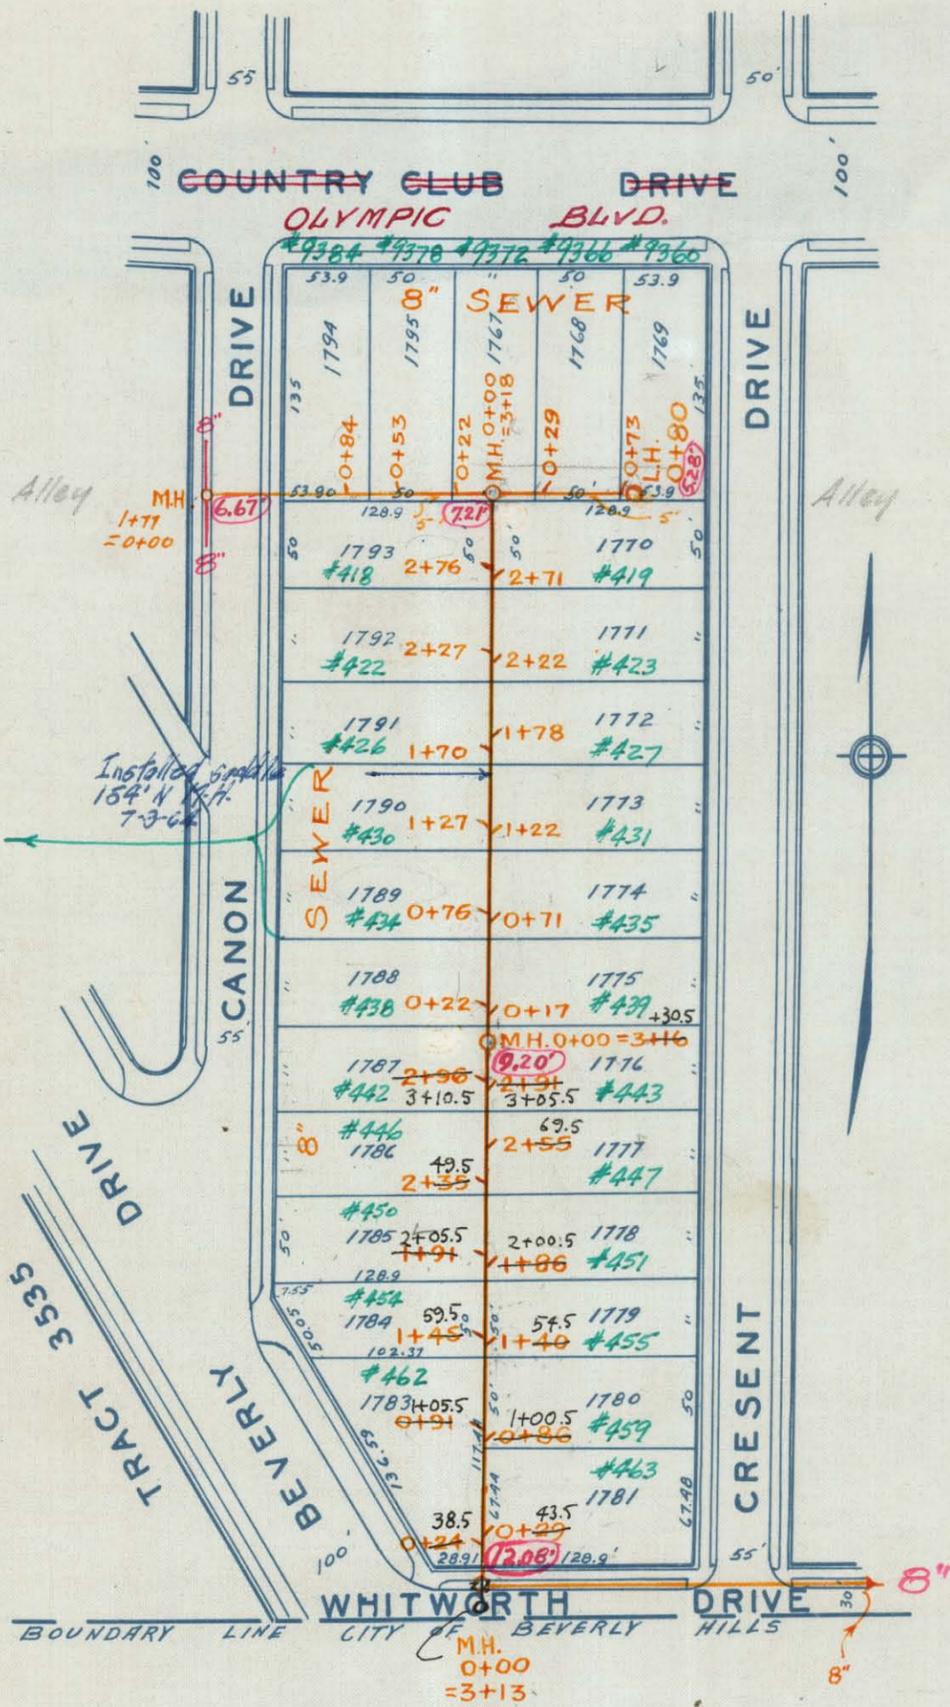


TR.  
#28207  
lot 1

CITY OF BEVERLY HILLS  
TRACT 6380  
M.B. 69-11-20  
SCALE 1"=100'  
-1926-

58





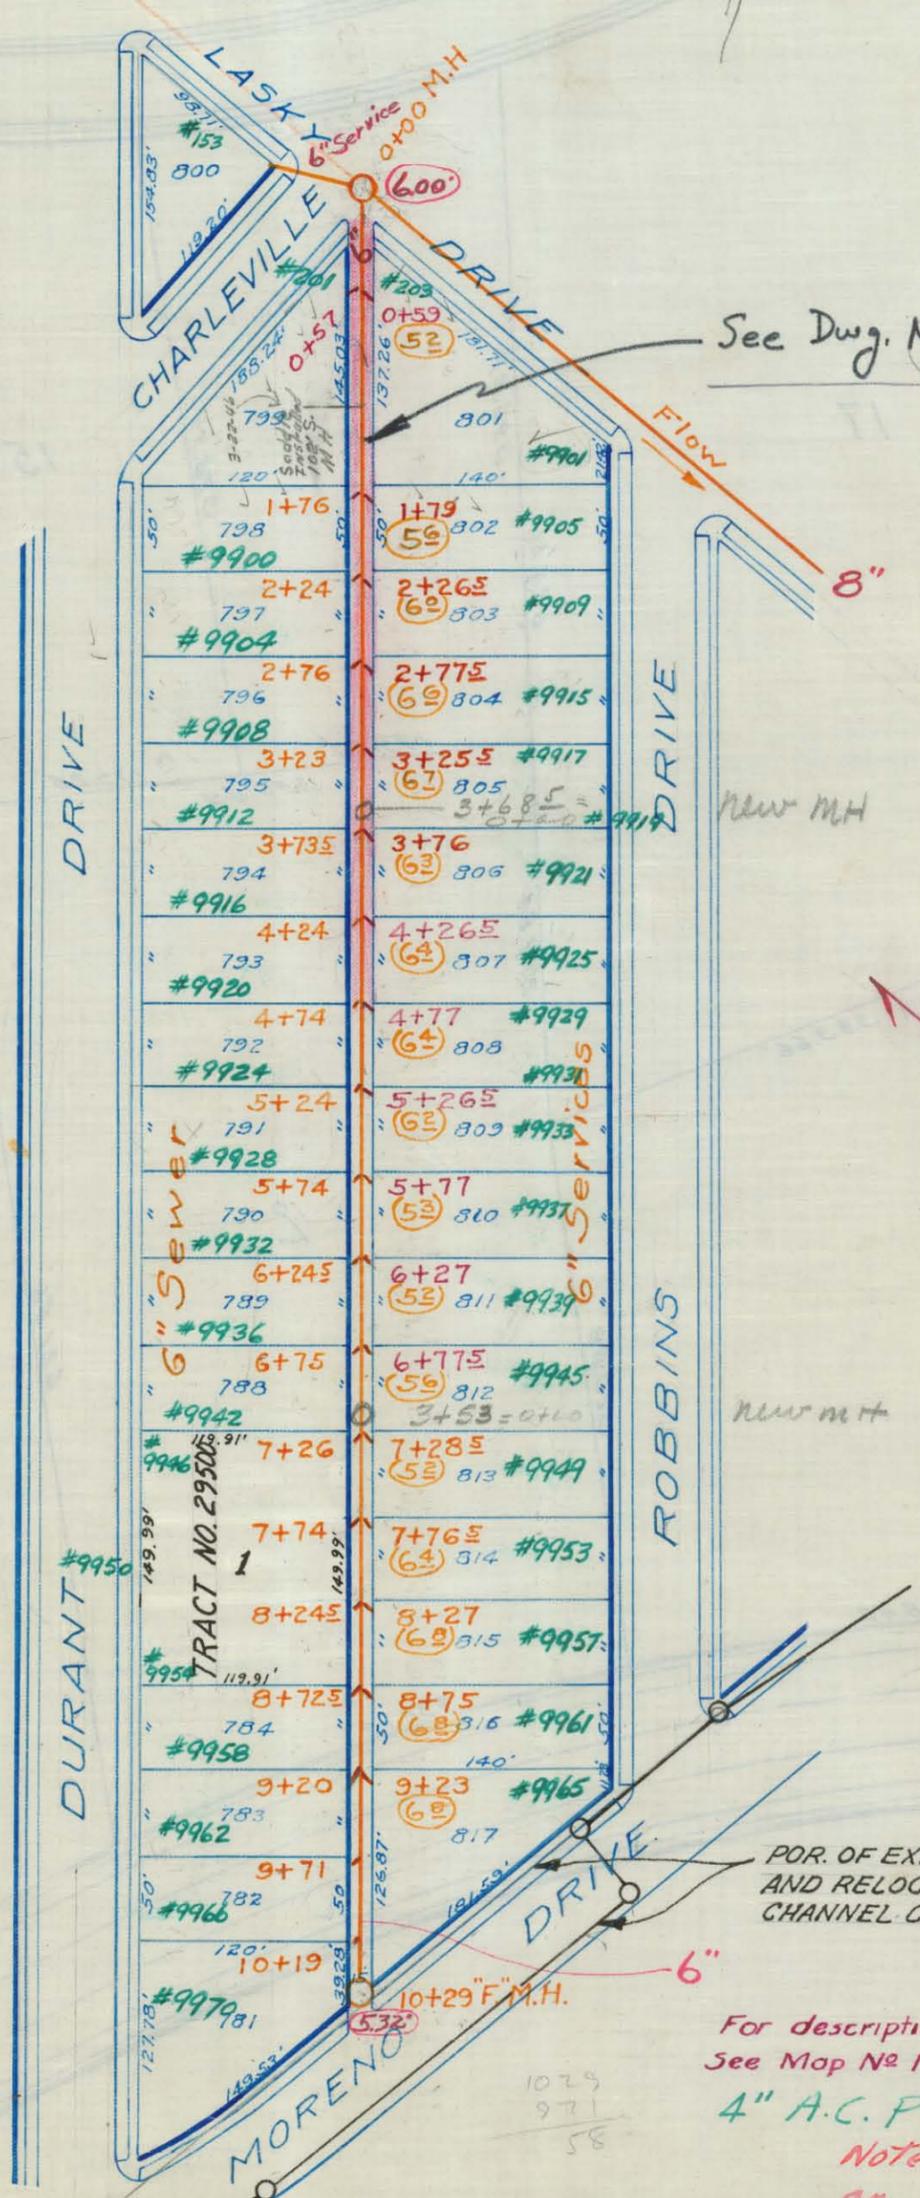

See Dwg. No. 7101.3

NEW SEWER  
IN ALLEY  
SEE DWG NO 7101  
SHT 3.

POR. OF EXIST. 10" SEWER ABANDONED  
AND RELOCATED PER BENEDICT CANYON  
CHANNEL CONST. IN 1963.

For description of Sewer in Moreno  
See Map No 1023 F-209

4" A.C. Pavement

Note: No Saddles  
on line in Moreno

# TRACT 7710


8" C.I. PIPE S.S. CONNECTION FROM  
B.H. HIGH SCHOOL.  
(1967)

M.B. 93 P. 94-95.

## CITY OF BEVERLY HILLS.

Scale. 1 inch = 100 ft.


(61)

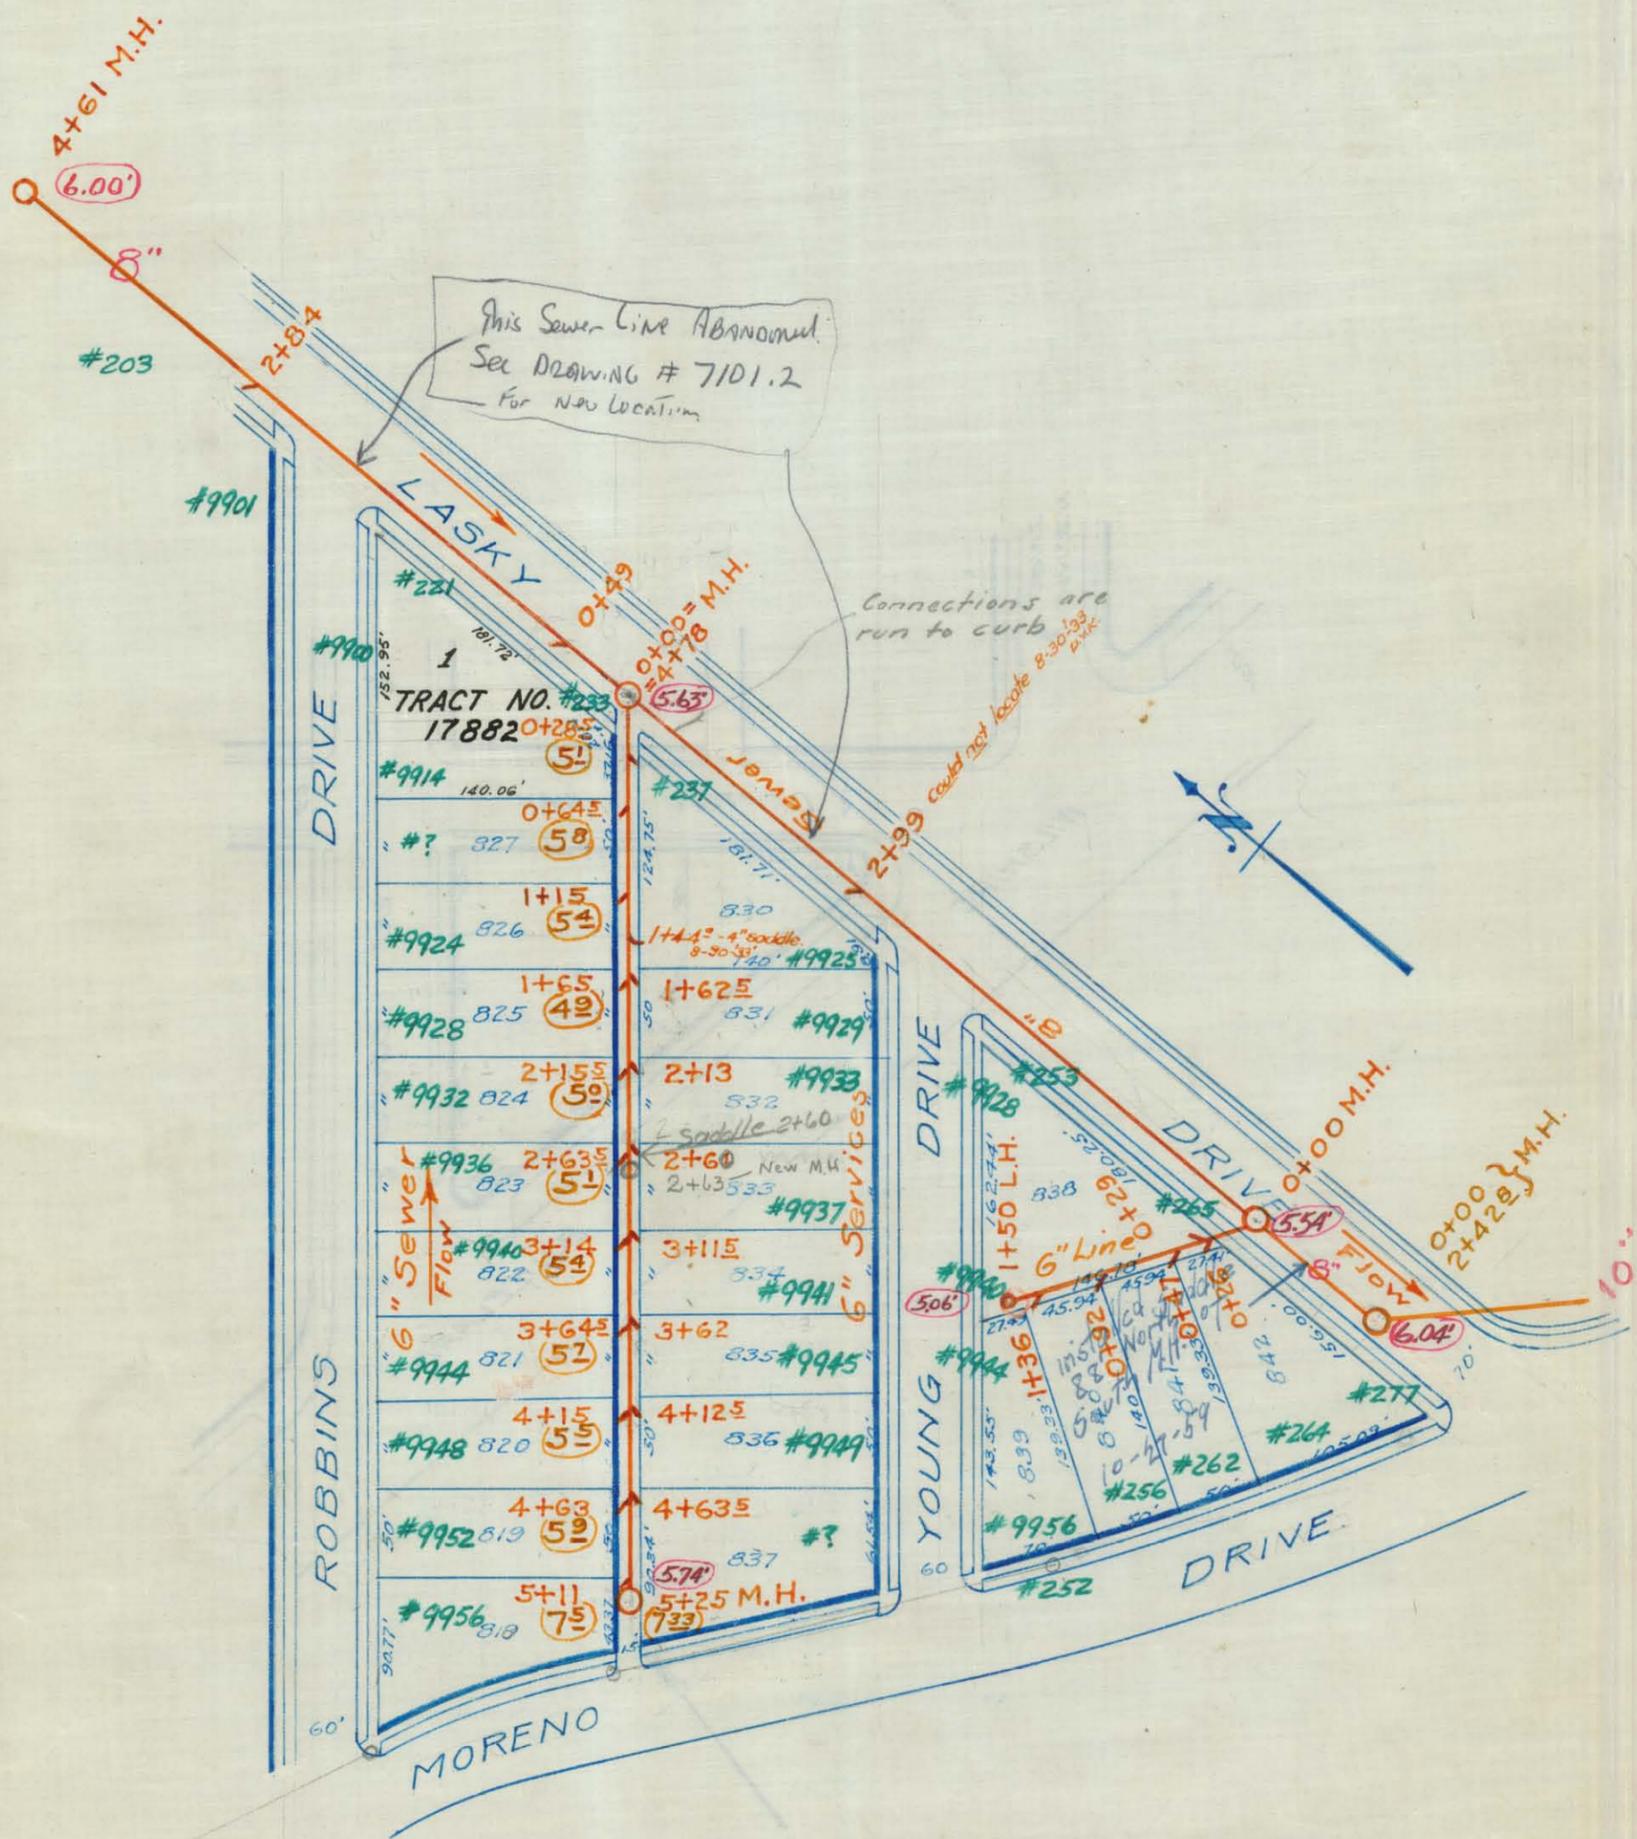

For Description of Sewer in Moreno See Map No 1023 F-209  
 Note: No Saddles on line in Moreno

**TRACT 7710.**  
 M. B. 93 P. 94-95.  
**CITY OF BEVERLY HILLS.**  
 Scale, 1 inch = 100 ft.



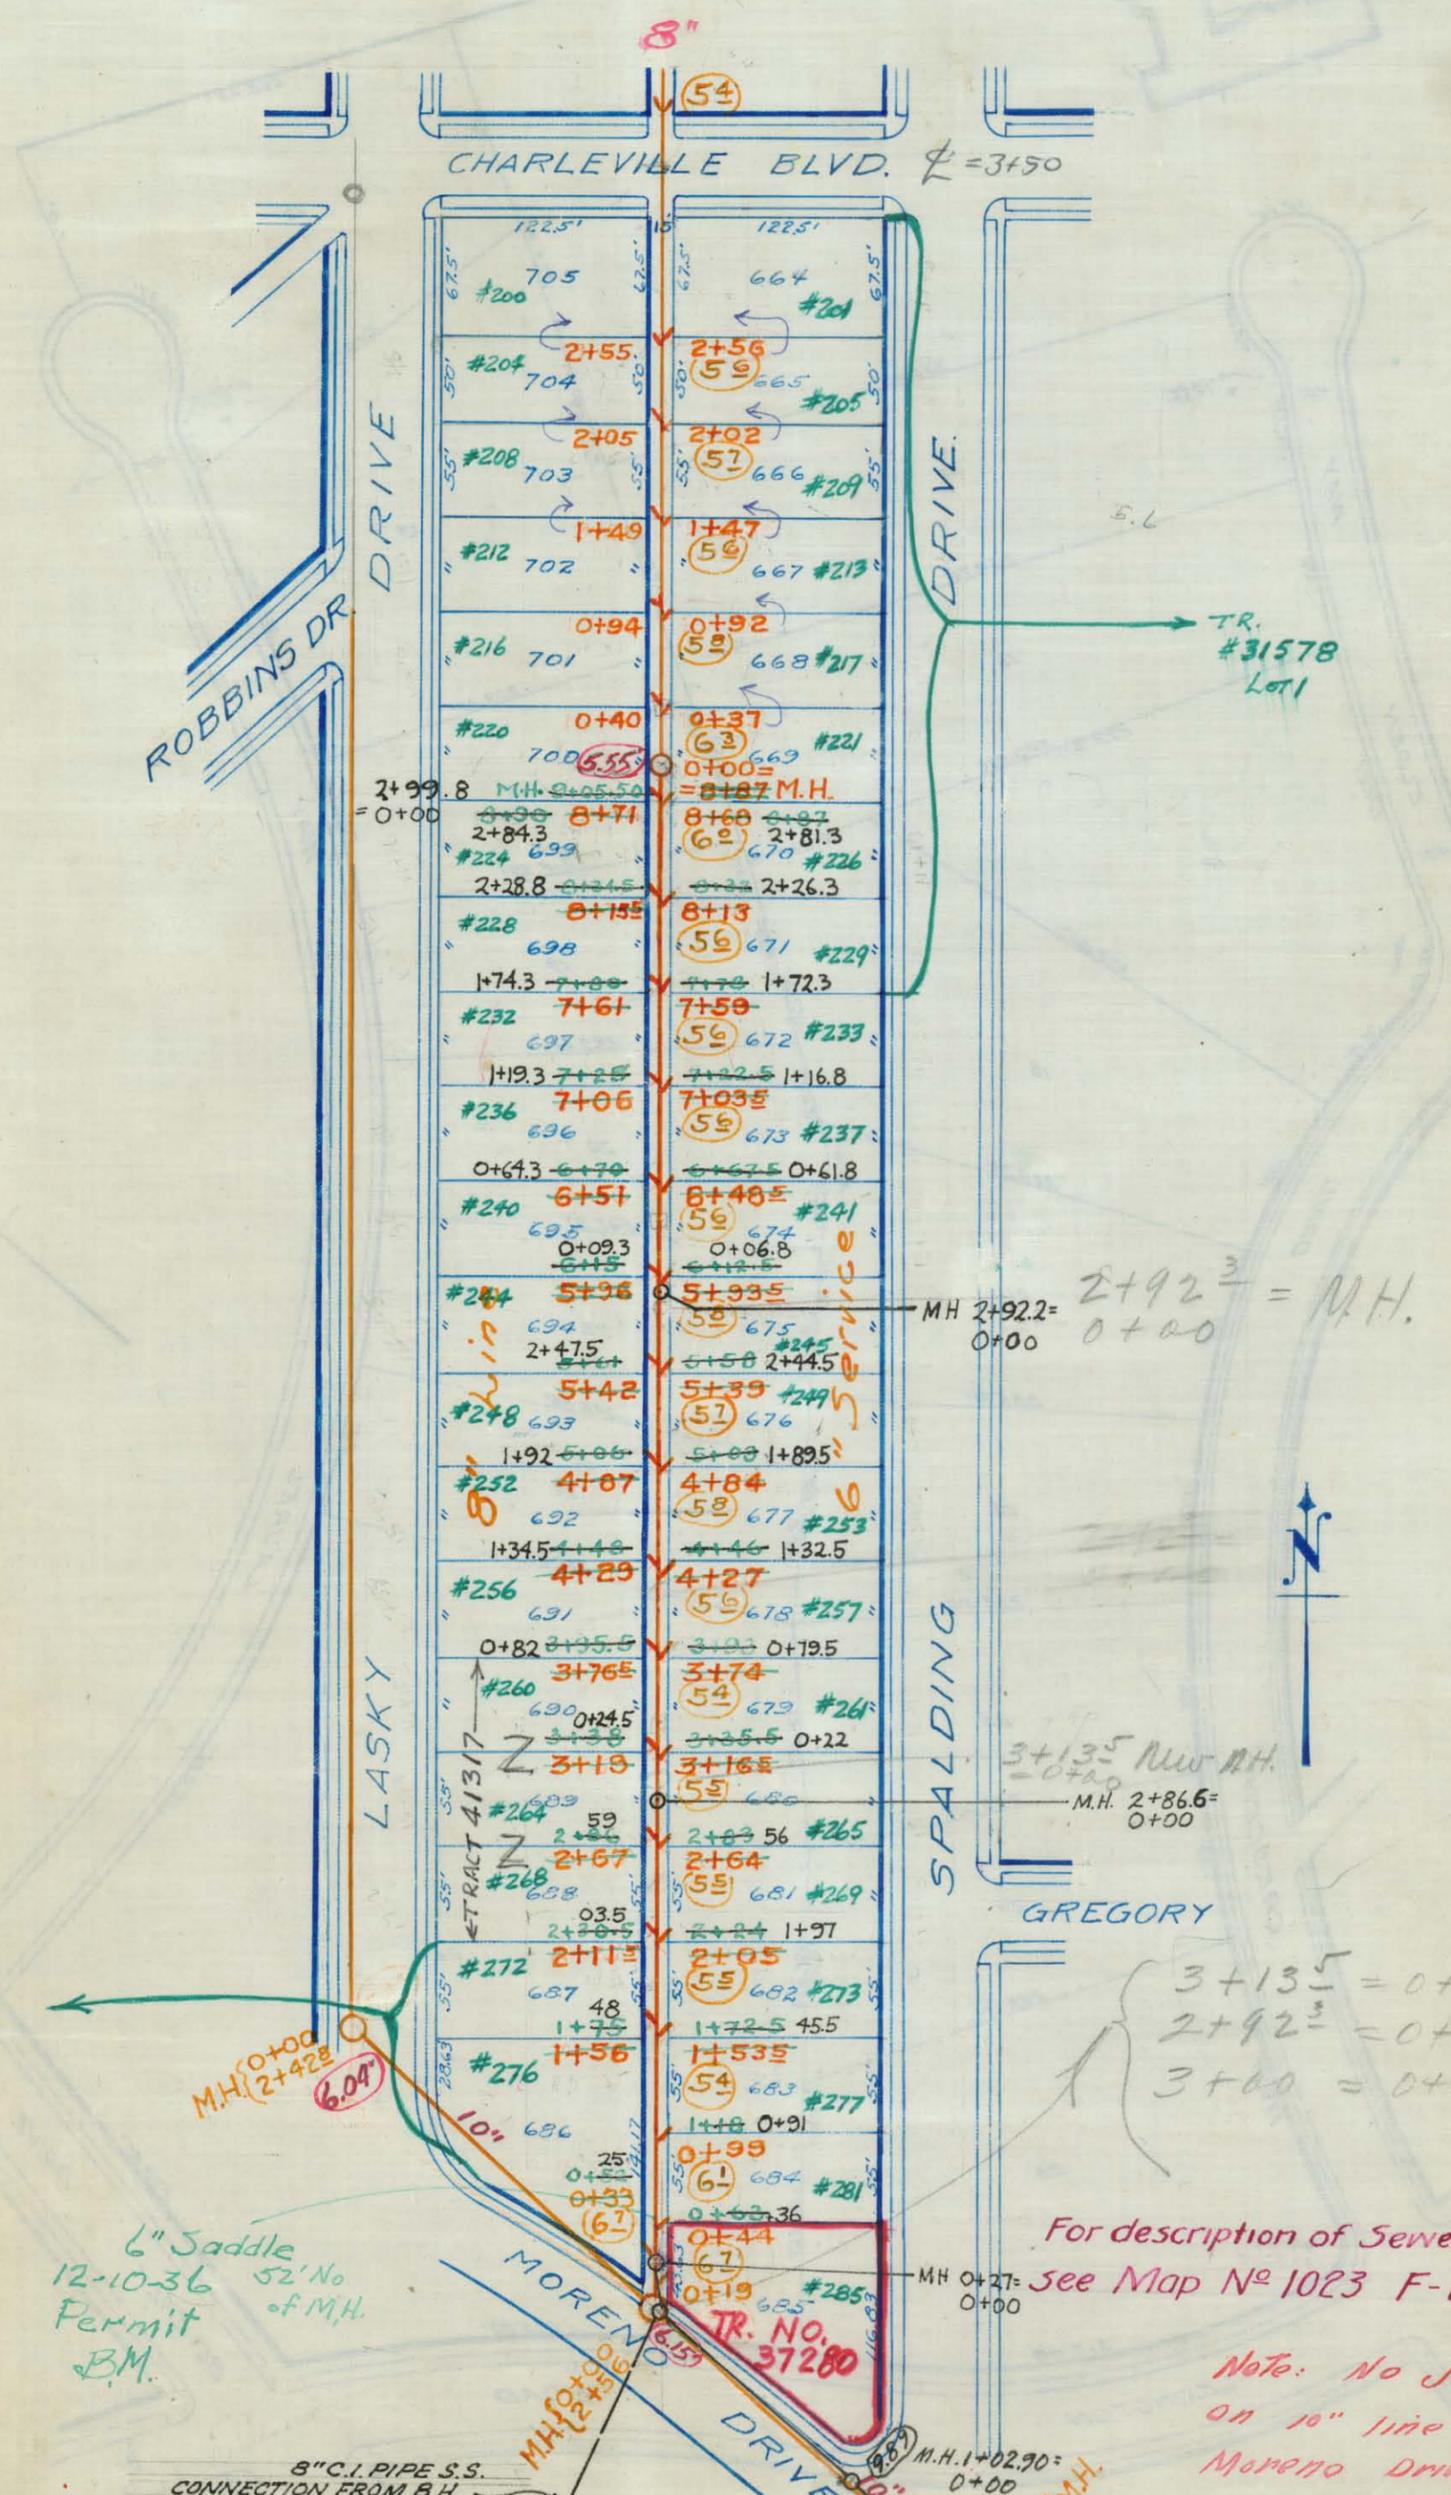

CHARLEVILLE BLVD.  $\phi = 3+50$

ROBBINS DR. DRIVE

DRIVE

TR. #31578 Lot 1

LASKY

SPALDING

GREGORY

TR. #31639 Lot 1

M.H. 0+00 (2+428) 6.04'

6" Saddle 12-10-36 52' No. of M.H. Permit B.M.

8" C.I. PIPE S.S. CONNECTION FROM B.H. HIGH SCHOOL (67)

**TRACT 7710**  
M.B. 93, P. 94-95.  
**CITY OF BEVERLY HILLS.**

Scale, 1 inch = 100 ft.

M.H. 2+92.2 = 0+00 = M.H.

M.H. 2+86.6 = 0+00


For description of Sewer in Moreno see Map No 1023 F-209

Note: No Saddles on 10" line in Moreno Drive.

Revised 6-5-73 P.K.

64

could not locate Y.  
placed saddle at  
0+50 - 6-Dec. 1939  
Ramm

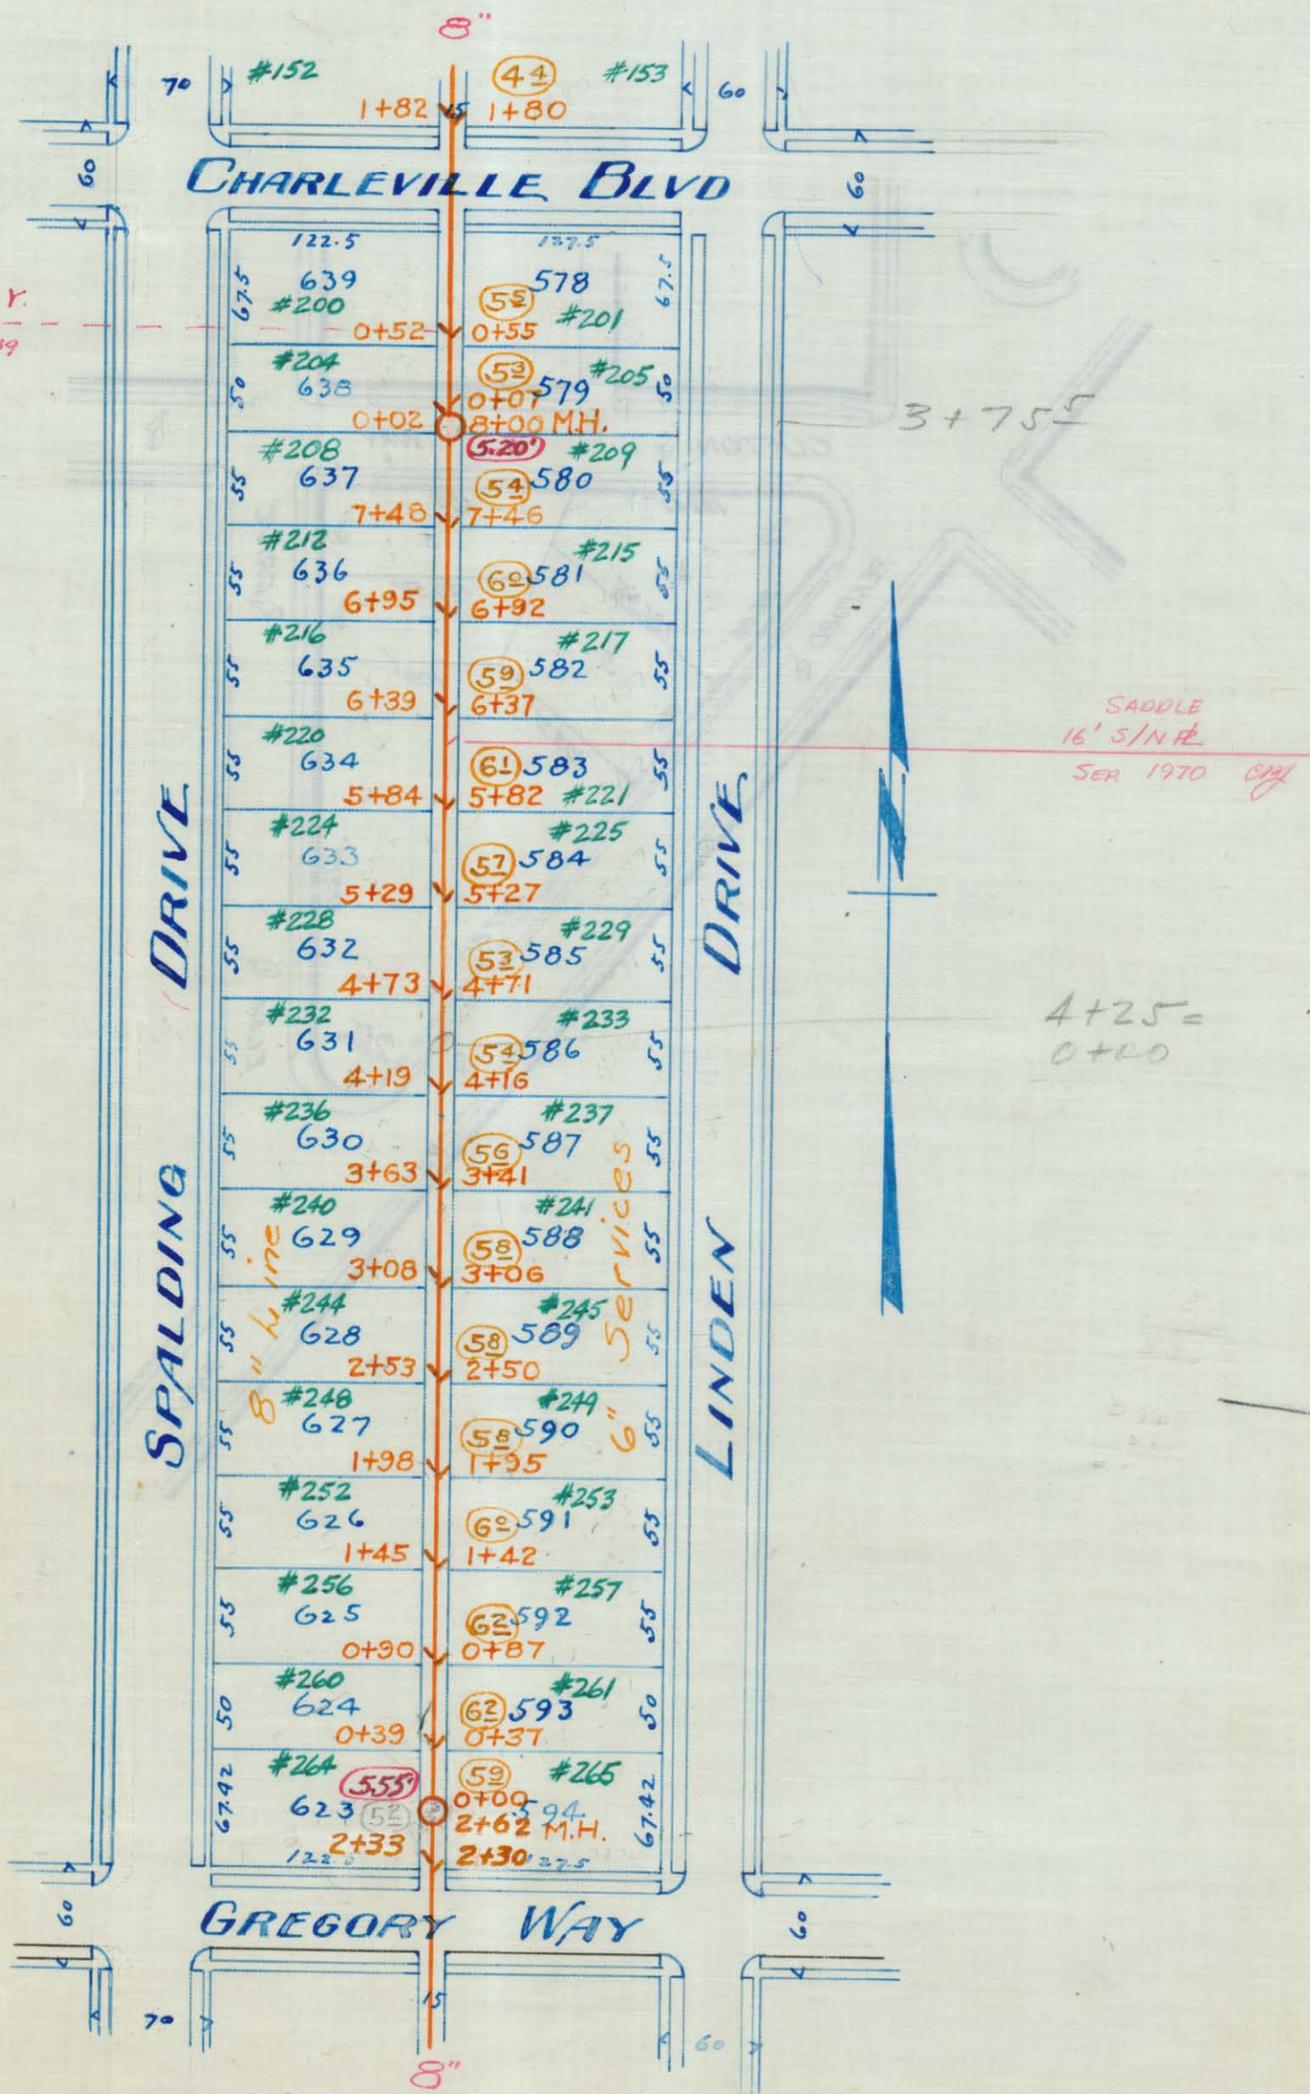

LOTS 623 TO 639  
578 TO 594

**TRACT 7710.**  
M.B. 93, P 94-95  
**CITY OF BEVERLY HILLS.**  
Scale. 1 inch = 100 ft.

65

10/30/80 SEE 2073.2+3 FOR DETAIL ANOTHER HOUSE CONNECTION EAST OF HEATH AVENUE (SEE ALSO 5026.71)

Installed Saddle 16" of W. City Limits to High Canyon Property See Dwg. No. 5026.71

Abandoned per Proj. III-A Dwg # 5803 Rev. 6-5-73 P.K.


Note Charge 32 1/2¢ per front foot for All connections to Olympic Blvd sewer credit sewer account Saddle fee and resurfacing Charges must also be collected 7/26/38

Installed saddle 156' south of North M.H. 11-13-69 R.B.

(Per Bill Moorhead 4/9/85) SEE DWG. 2055 FOR LATERAL TO ROXBURY PARK

Note: No Saddles on 10" line in alley North of Olympic, and 10" line in Spalding.

Abandoned 10" 15" S.S. per Dwg # 7110 Rev 6-7-73 JPK  
4" A.C. Pavement 6/1941  
New M.H.'s installed 6/1941  
Sewer Y's have been corrected.

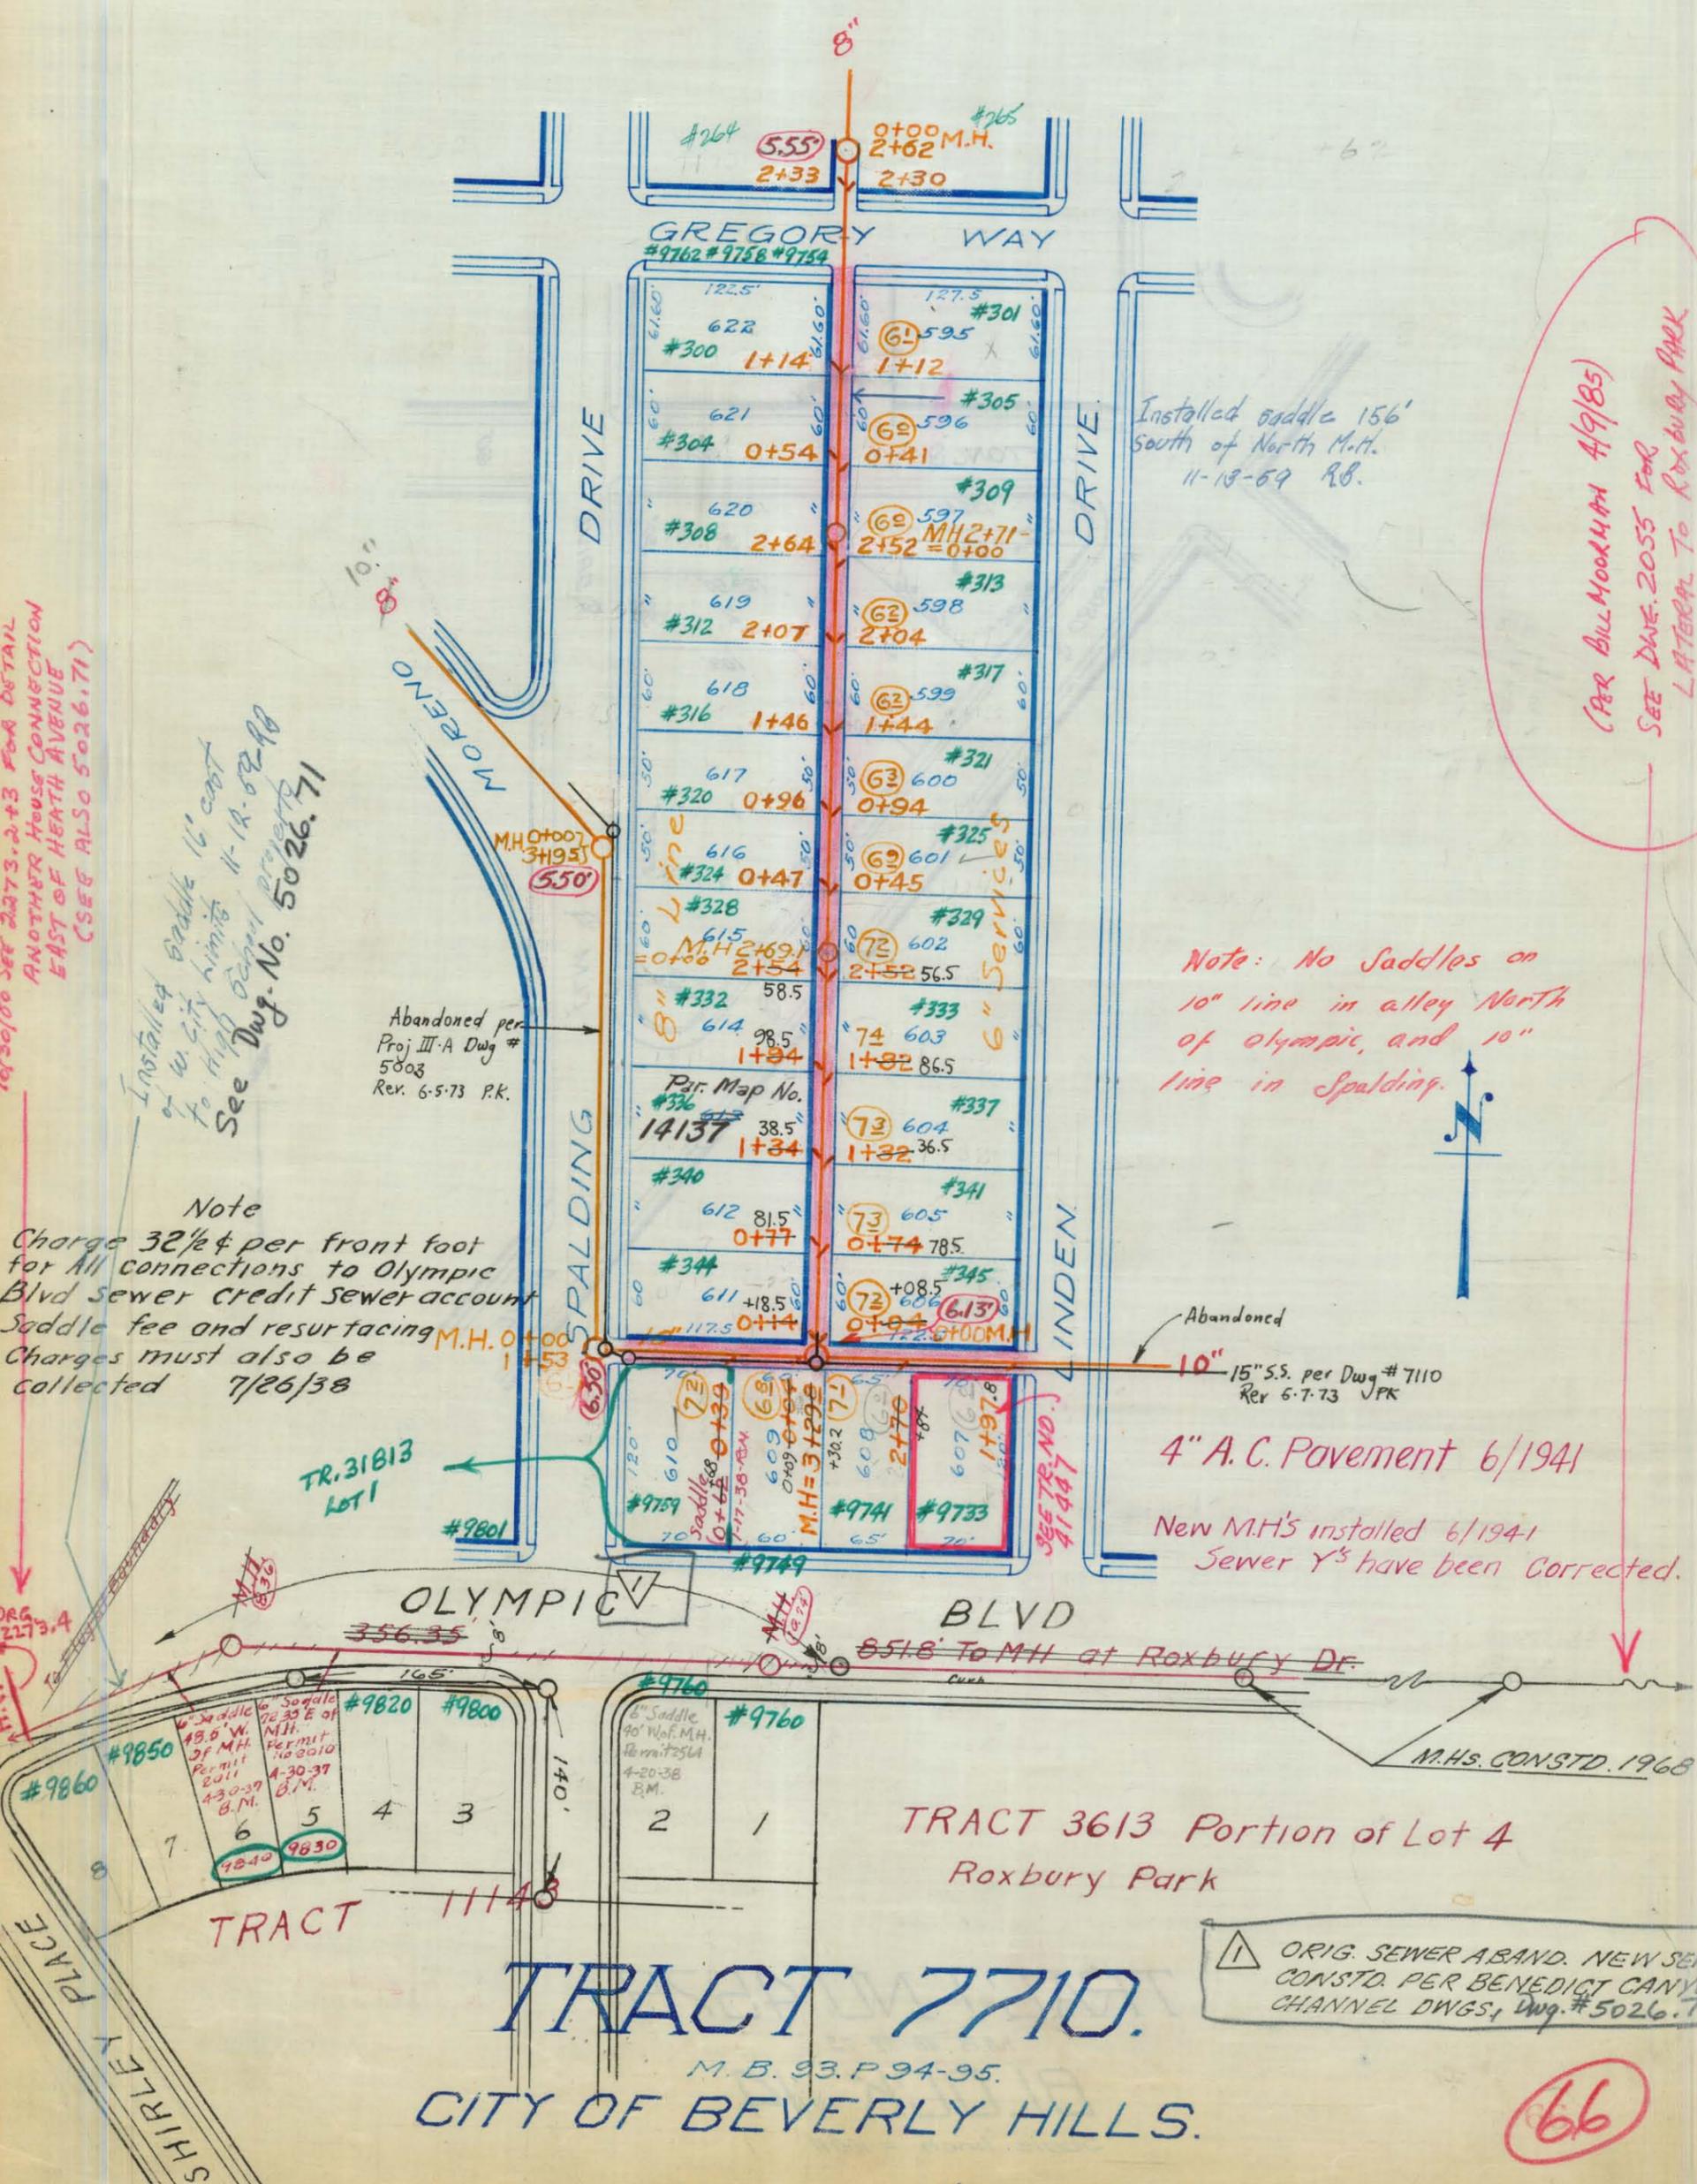


**TRACT 7710.**  
M. B. 93. P 94-95.  
**CITY OF BEVERLY HILLS.**

Scale, 1 inch = 100 ft.

SANTA MONICA BL. N.S.  
Electric R/W

WILSHIRE BOULEVARD

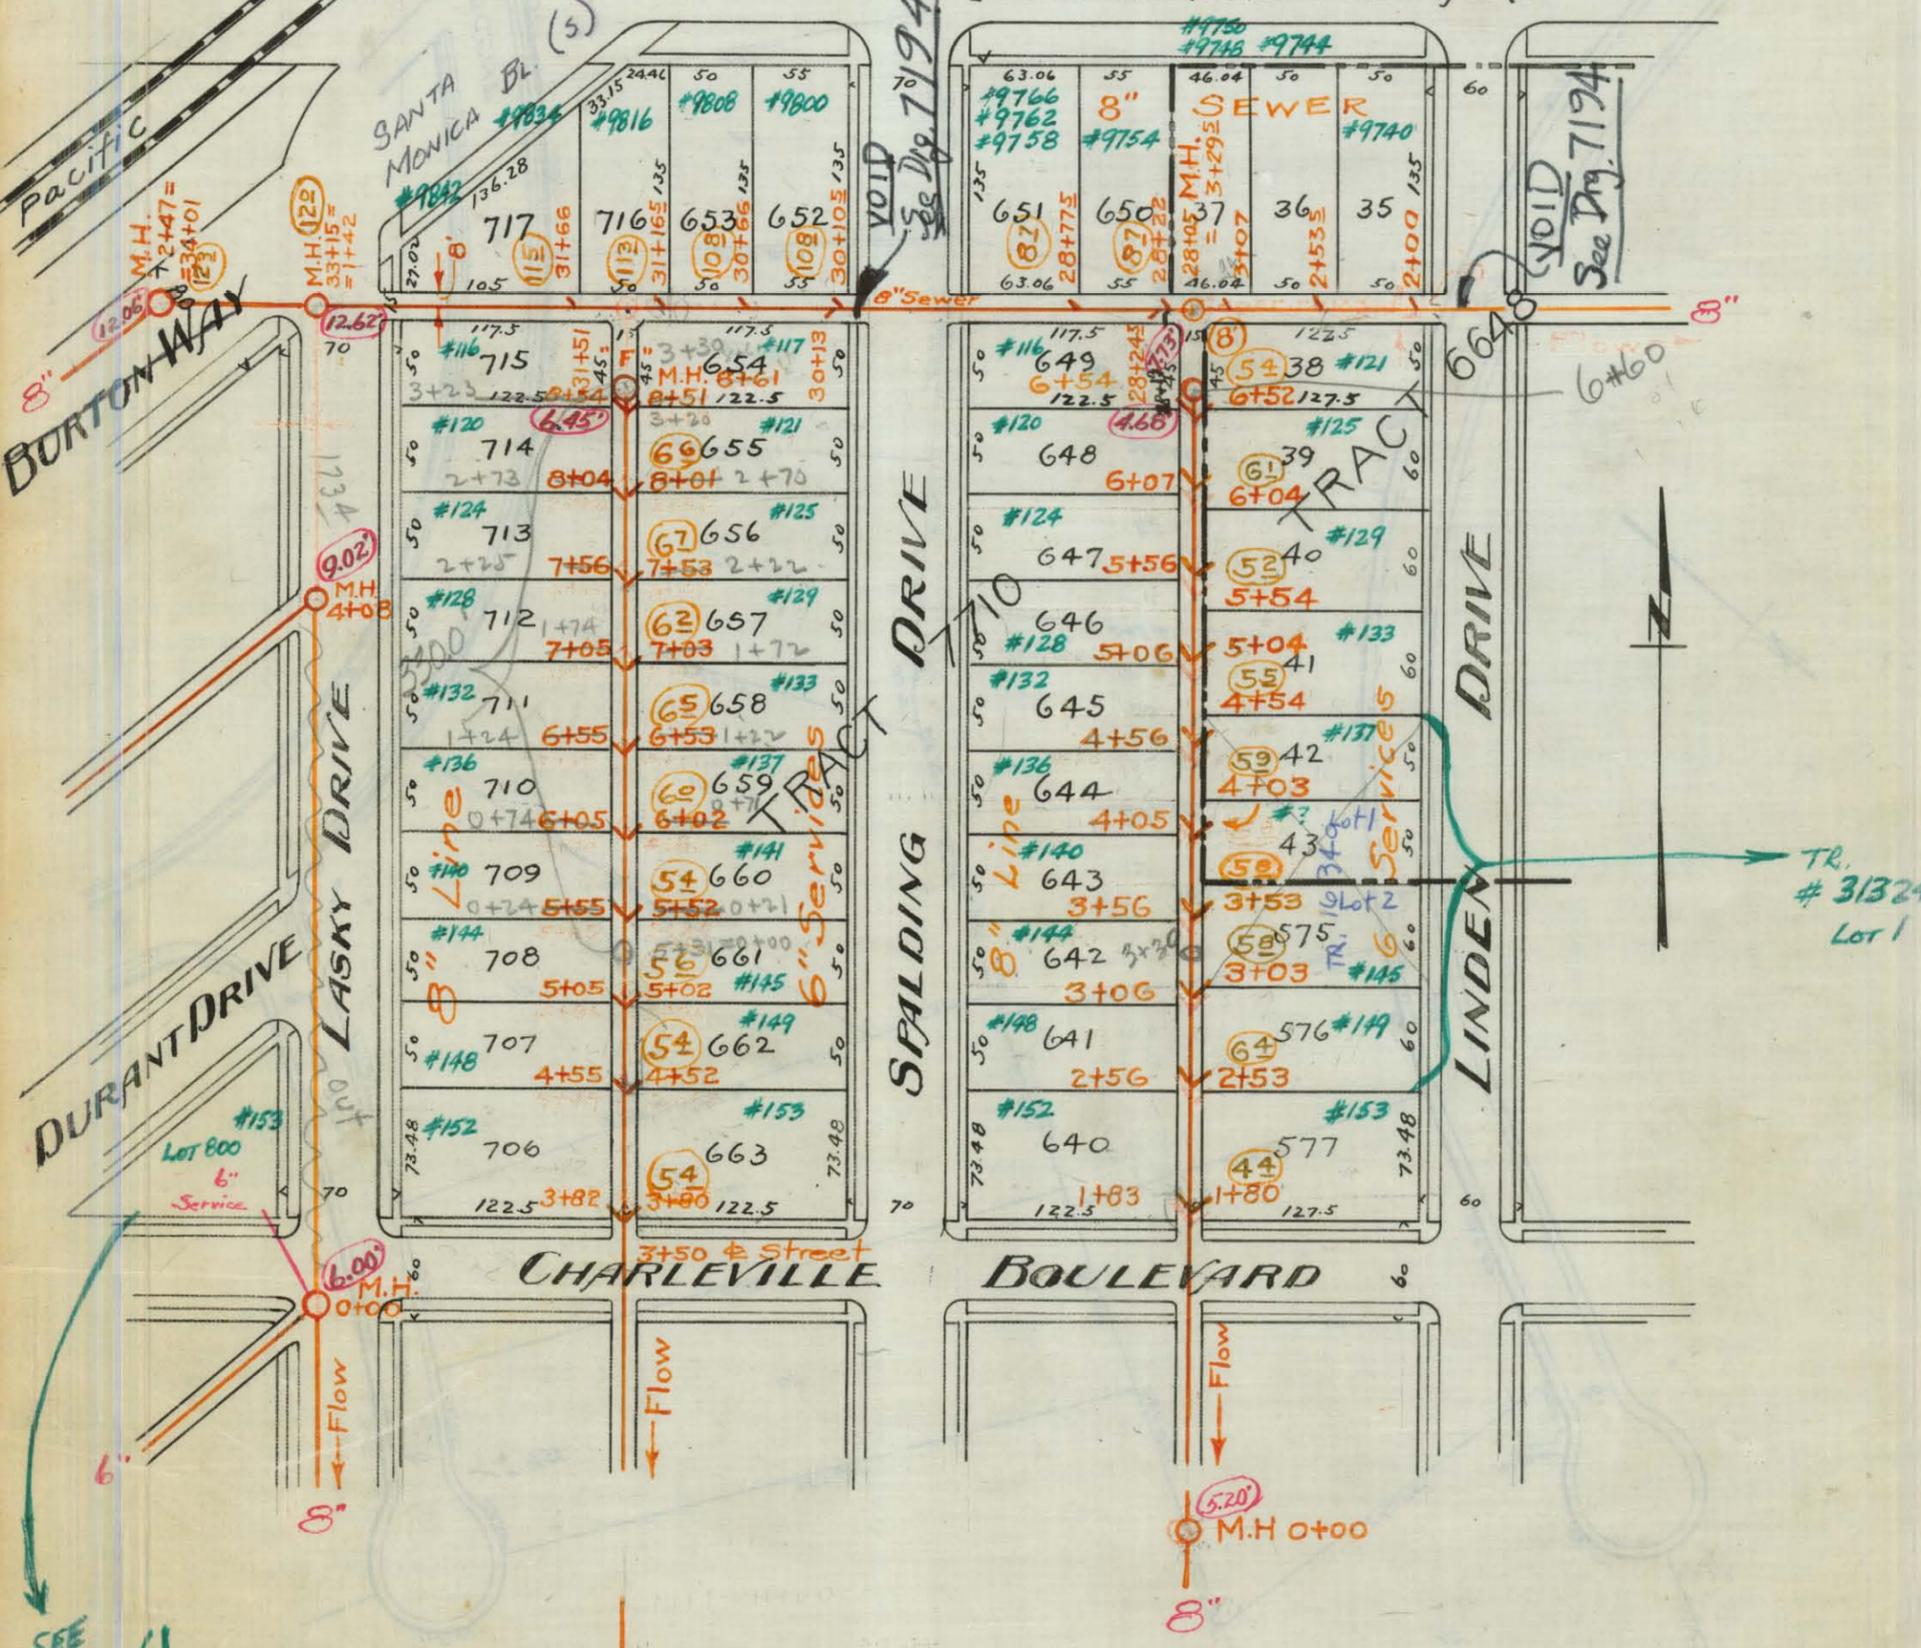

**LOTS**  
 35 To 43 TR. 6648  
 575 To 577  
 640 To 663 } TR. 7710  
 706 To 717


**TRACT 7710 & 6648.**

**CITY OF BEVERLY HILLS.**

Scale, 1 inch = 100 ft.

(67)

BLOCK 13  
 BEVERLY

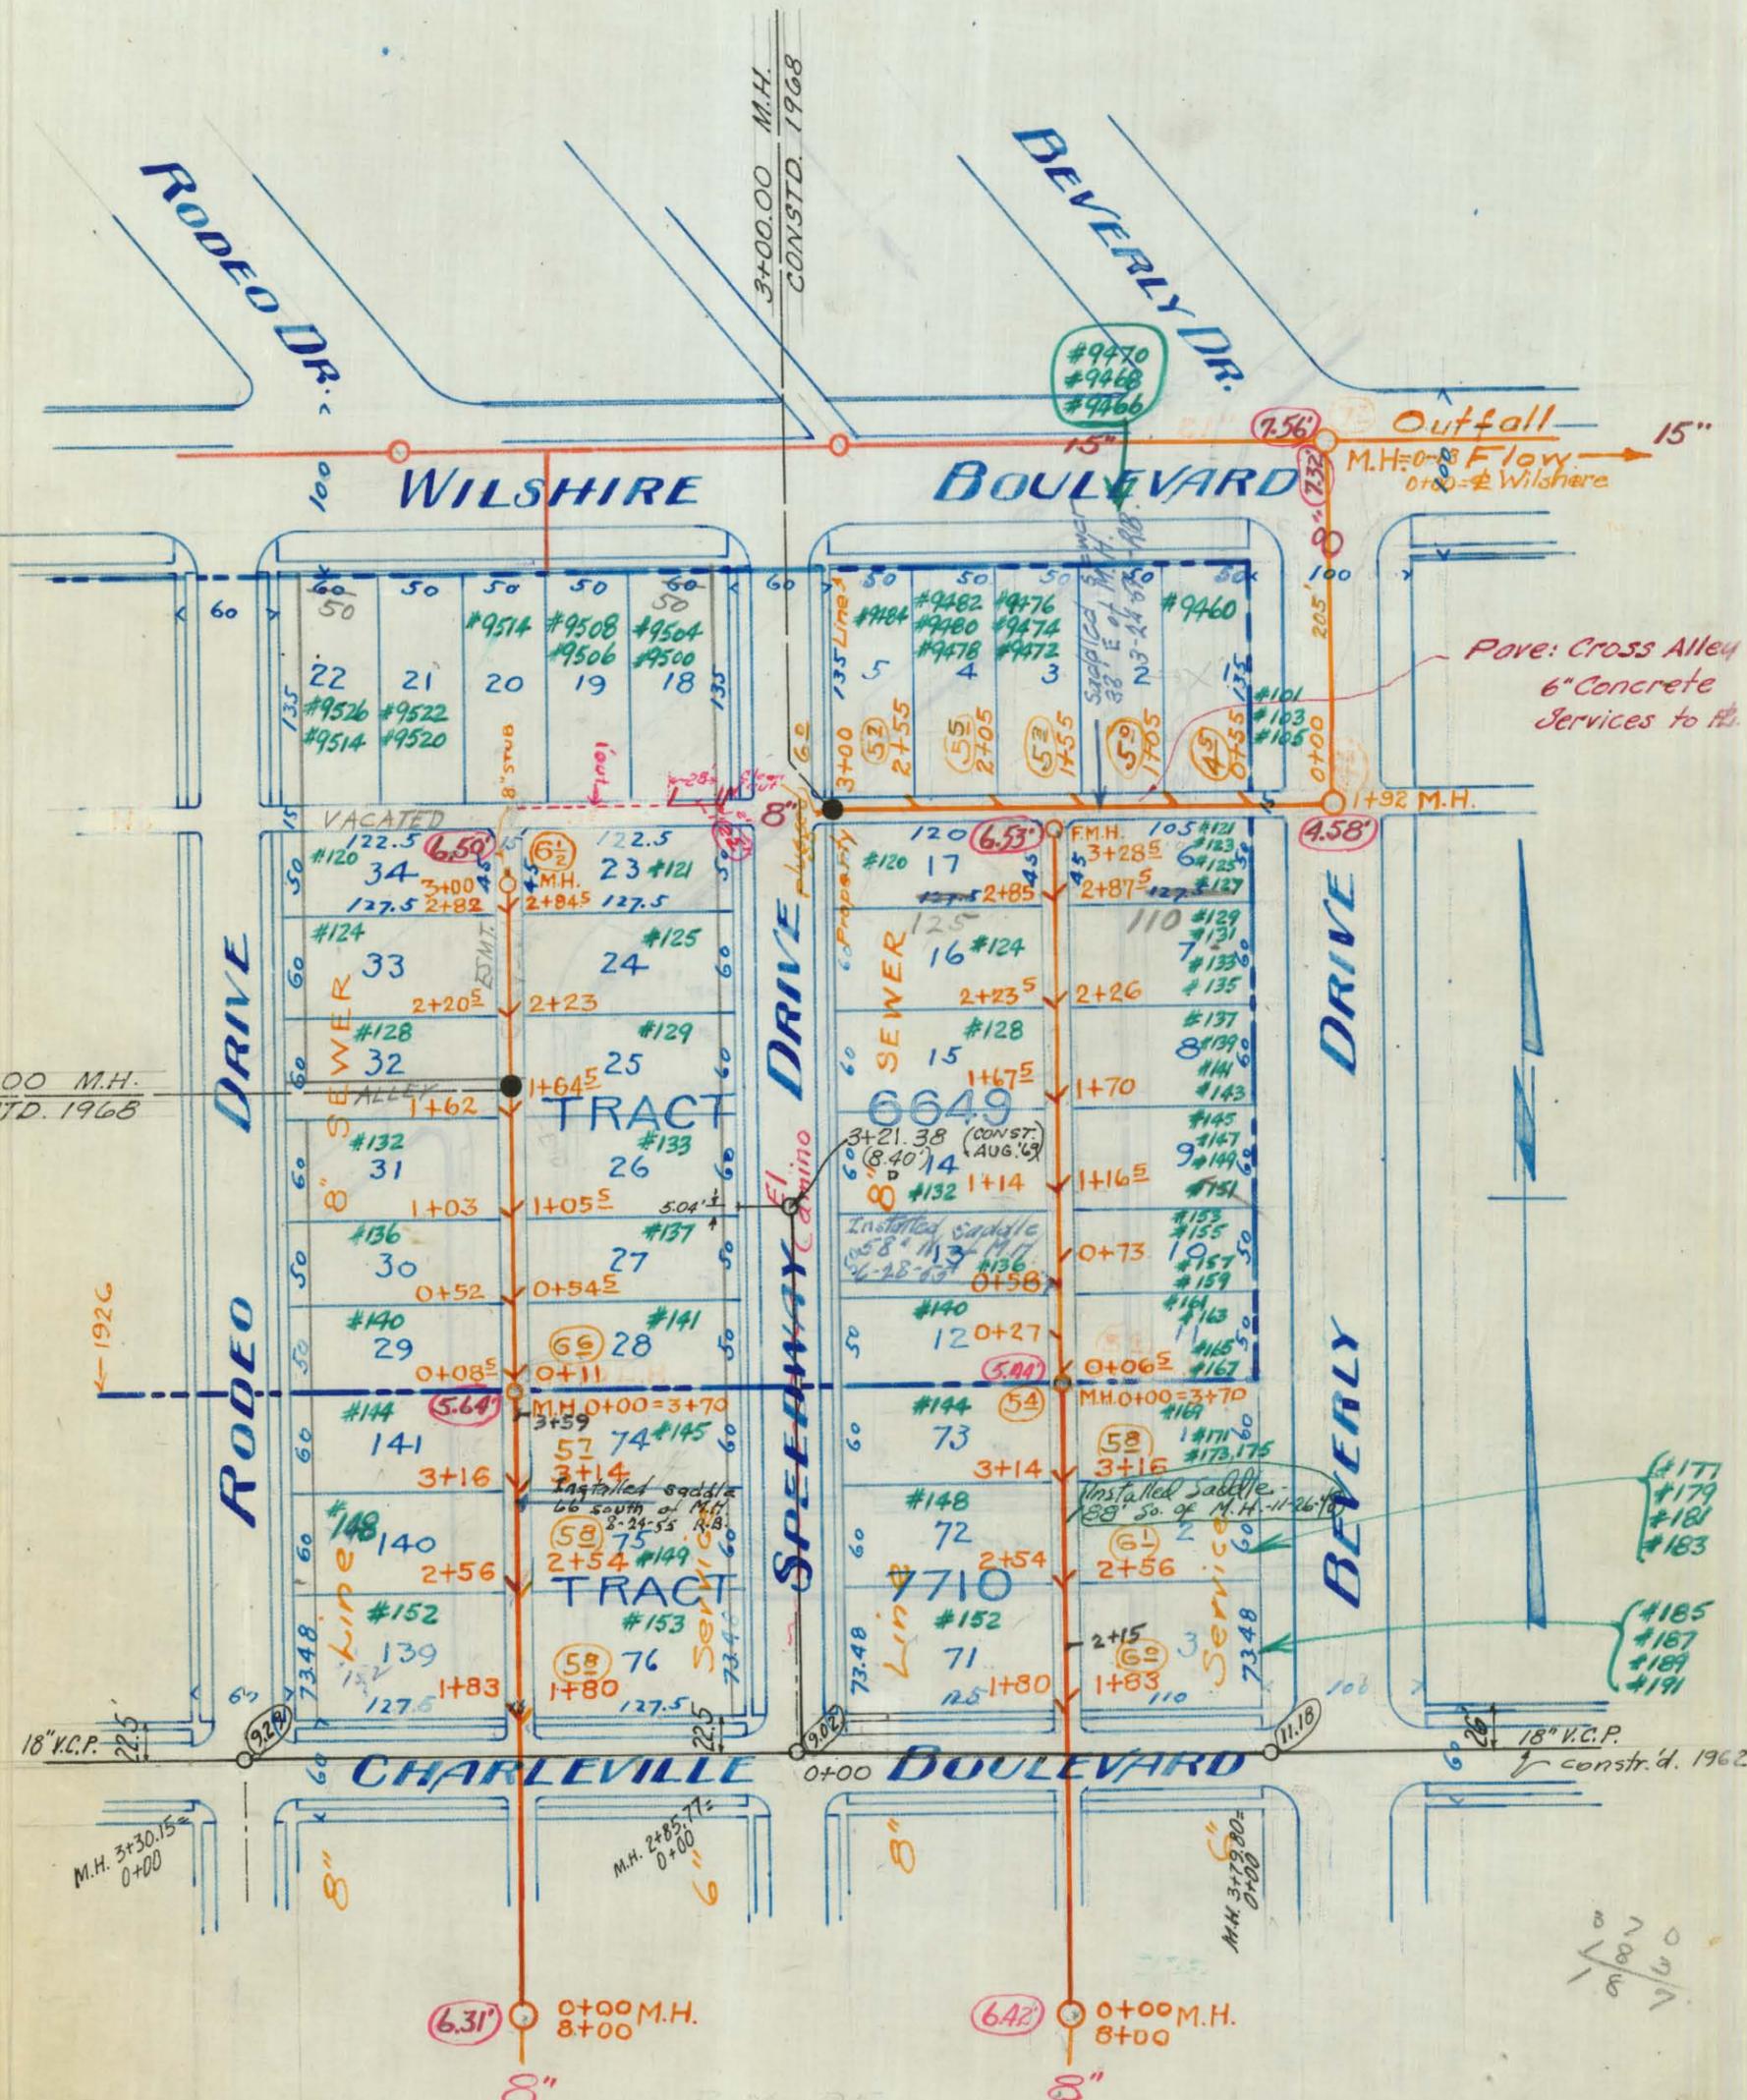

1+86.00 M.H.  
 CONSTD. 1968

M.H. 3+30.15  
 0+00

M.H. 2+85.77  
 0+00

M.H. 3+70.00  
 0+00

1/100  
 1/100  
 1/100

LOTS  
 1 to 3 } TR. 7710  
 71 to 76 }  
 139 to 141 }  
 1 to 34 } T.R. 6649


# TRACT 7710 Pub 6649.

M.B. 93 P94-95, M.B. 70 P54

## CITY OF BEVERLY HILLS

Scale, 1 inch = 100 ft.


68

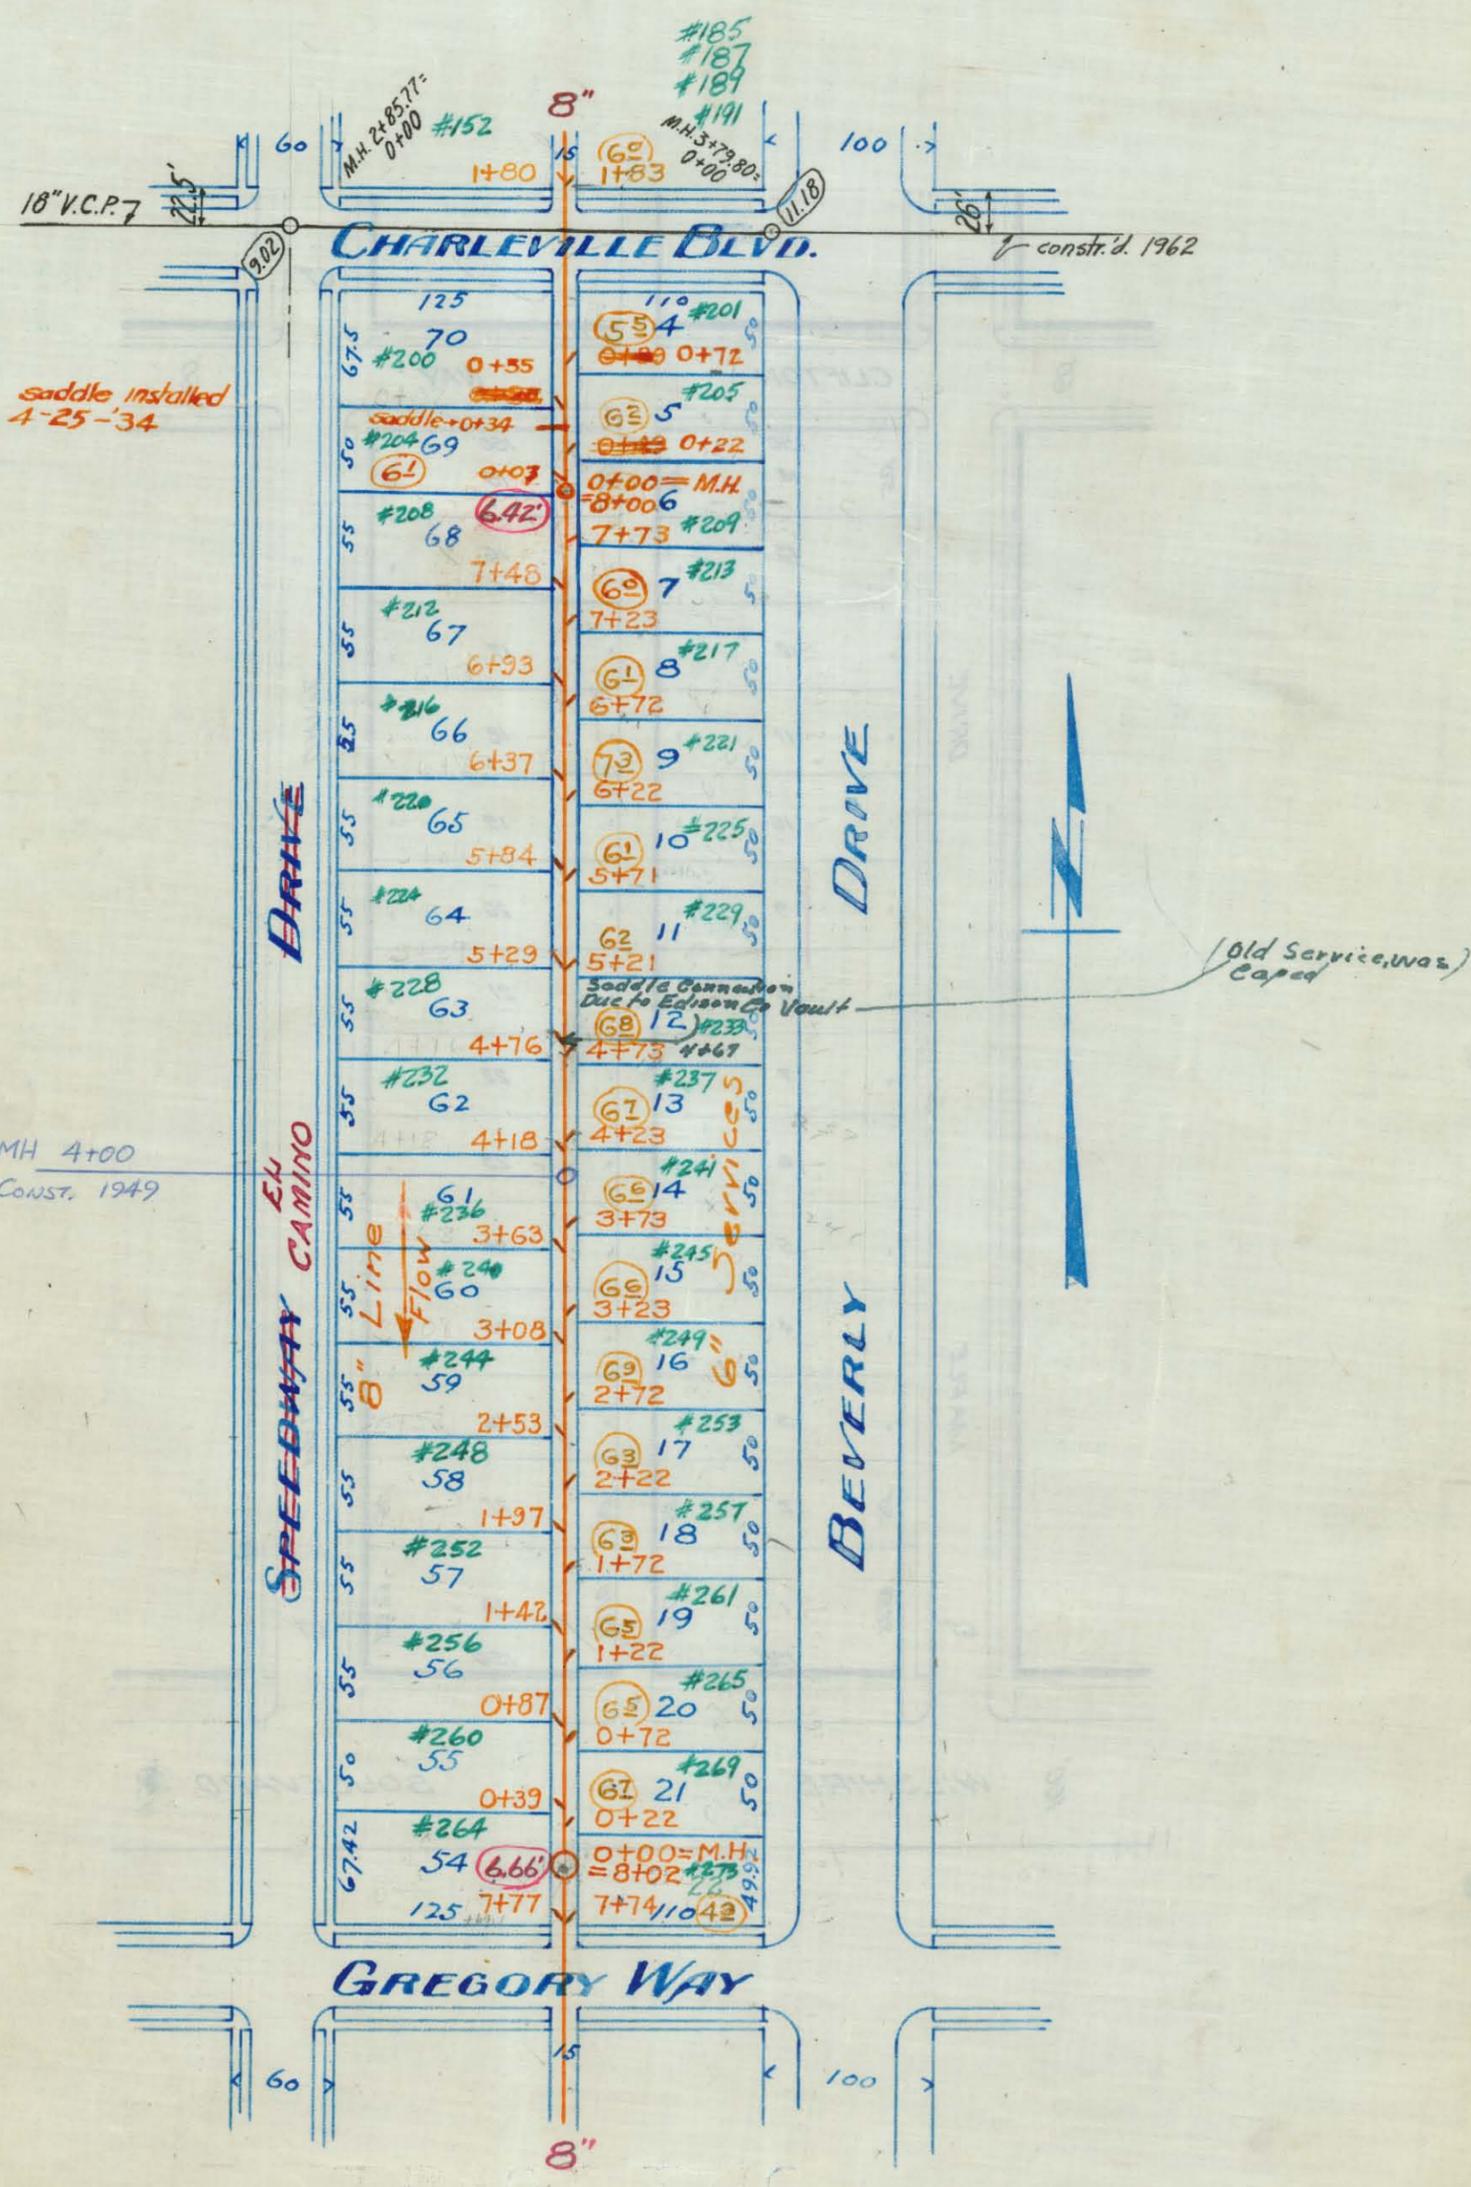

LOTS 4 to 22  
54 to 70

**TRACT 7710.**  
M.B. 93, P. 94-95  
**CITY OF BEVERLY HILLS.**  
Scale, 1 inch = 100 ft.

69

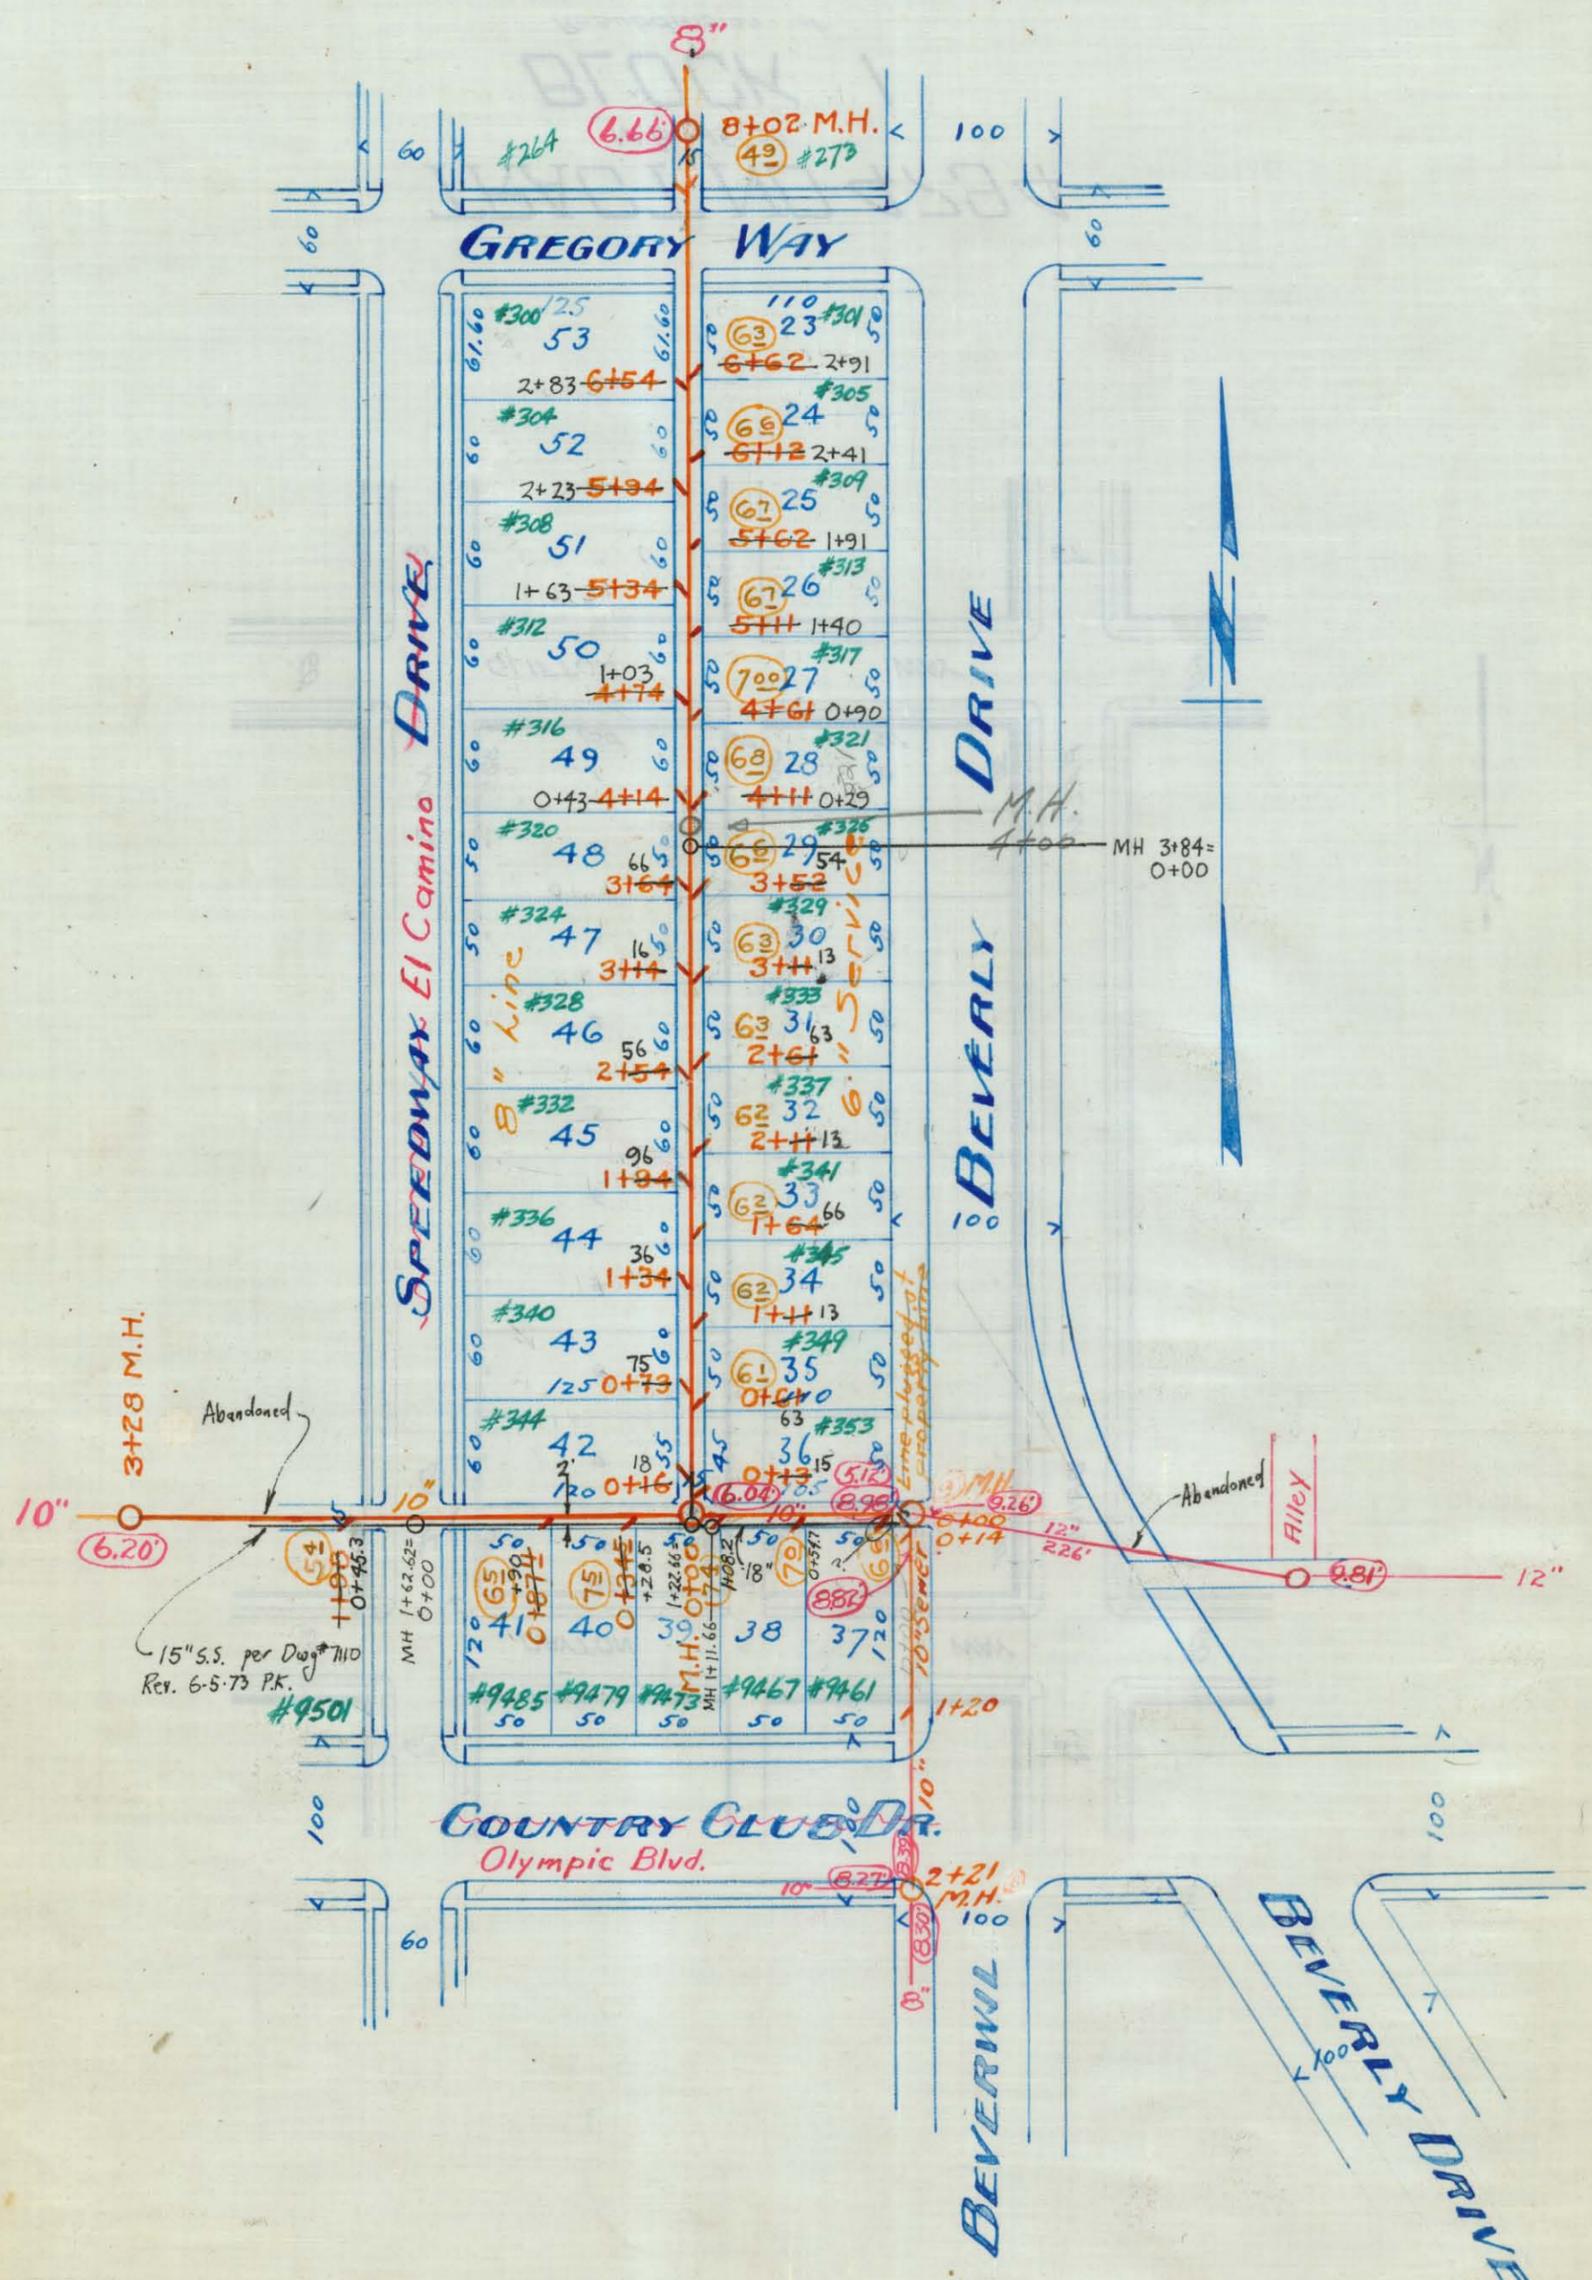


LOTS 23 TO 53

**TRACT 7710.**  
 M.B. 93. P 94-95.  
**CITY OF BEVERLY HILLS.**  
 Scale, 1 inch = 100 ft.

Note: No Saddles on 10" line in alley North of Olympic.

70

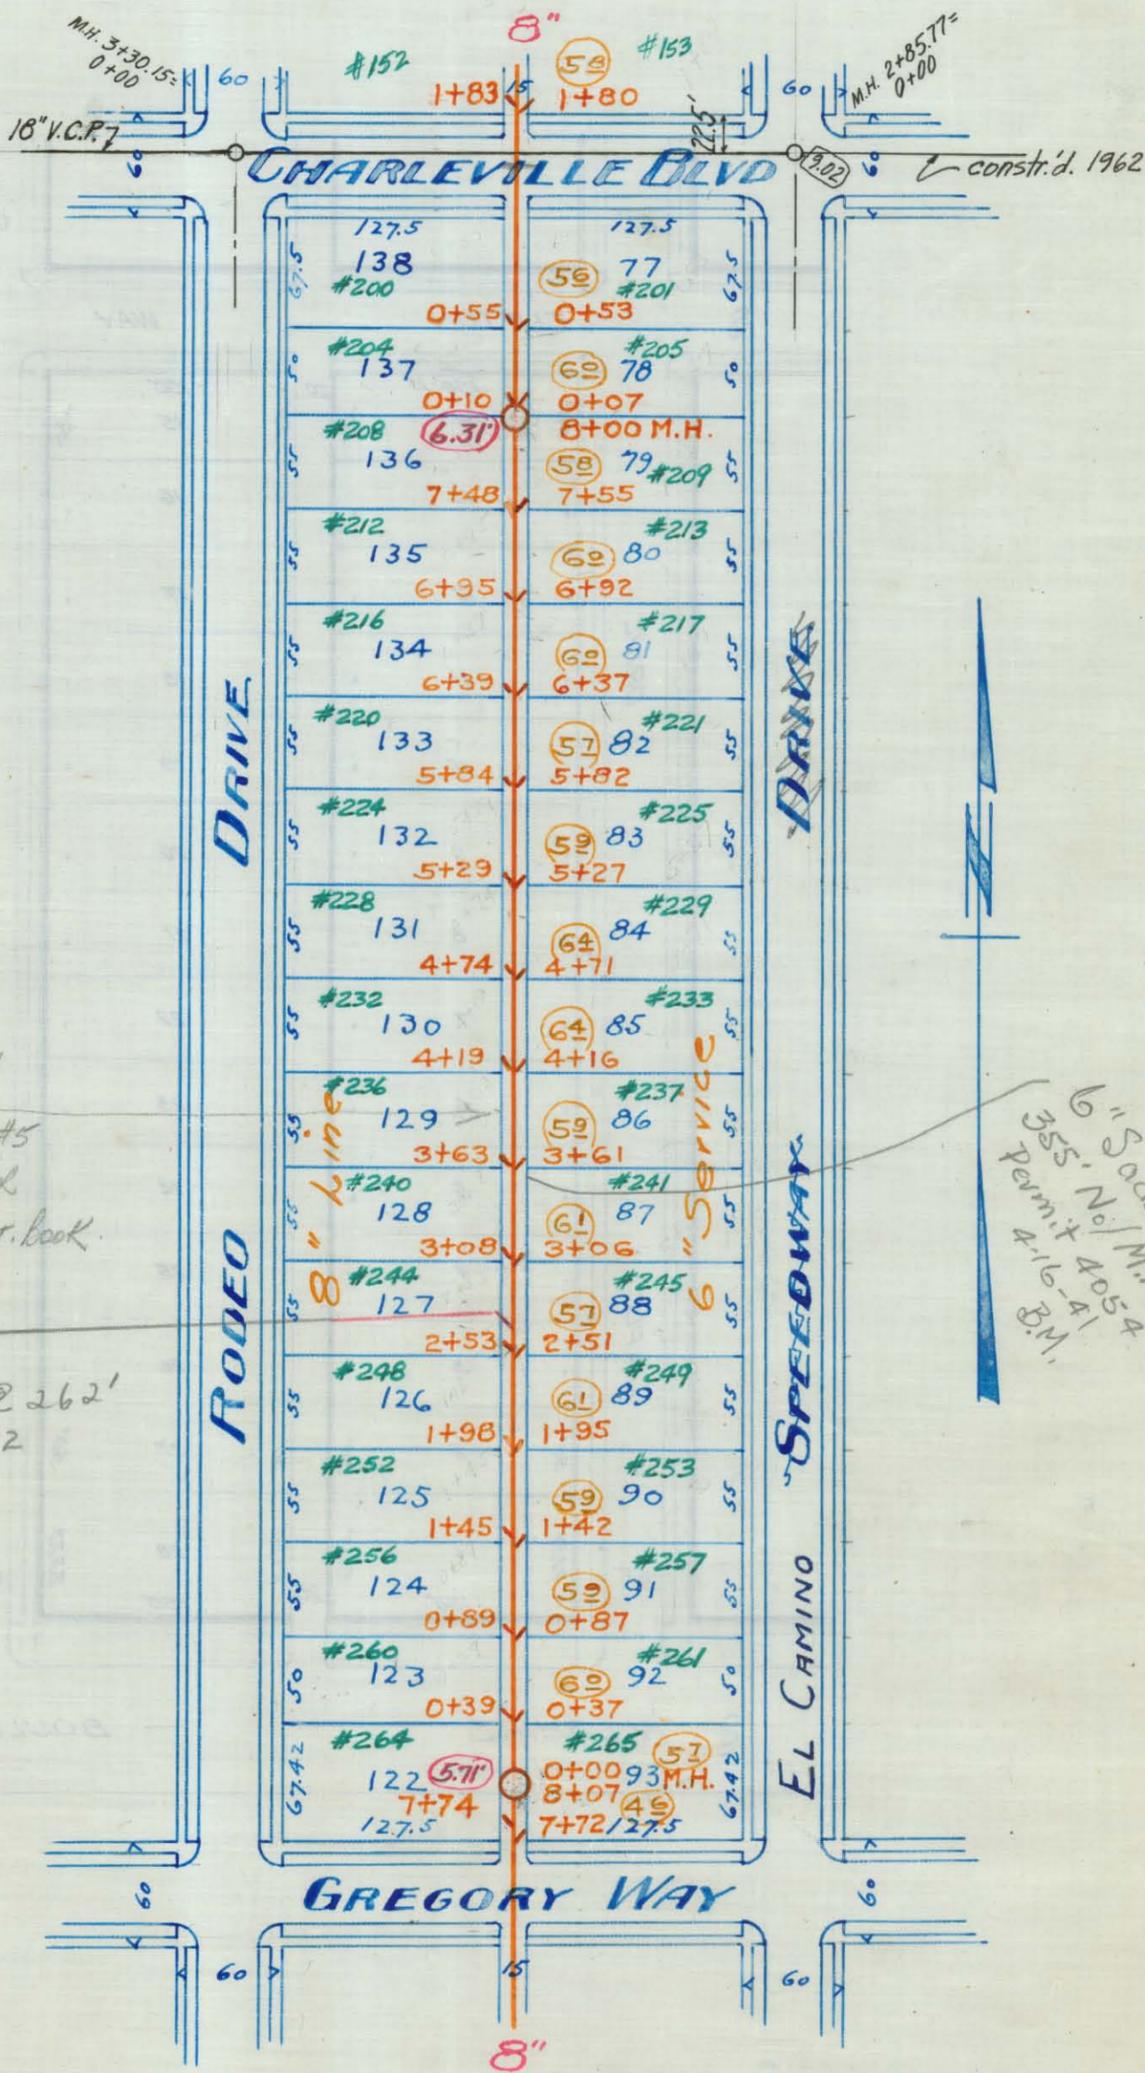

M/H @ 403'  
SEE DIST. #5  
IN SEWER  
MAINT. BOOK

NEW SADDLE @ 262'  
INSTALLED 7/30/02  
CAPED EXISTING

6" Saddle  
355' No. / M.H.  
Permit 4-16-41  
B.M.

LOTS 77 to 93  
122 to 138

**TRACT 7710**  
M.B. 93 P. 94-95.  
**CITY OF BEVERLY HILLS.**  
Scale, 1 inch = 100 ft.

711

CAMDEN DRIVE  
 DAYTON WAY  
 RODEO DR.

WILSHIRE BOULEVARD



Storm Drain  
 Manhole.

36"  
 Unused  
 Corr Iron  
 Storm Drain

Revised to show as built  
 6-5-73 P.K.  
 Ref. Dwg # 2034

MH 2+96.8  
 = 0+00

Stations Corrected Alley  
 West of Rodeo Feb, 1938.  
 W.J.

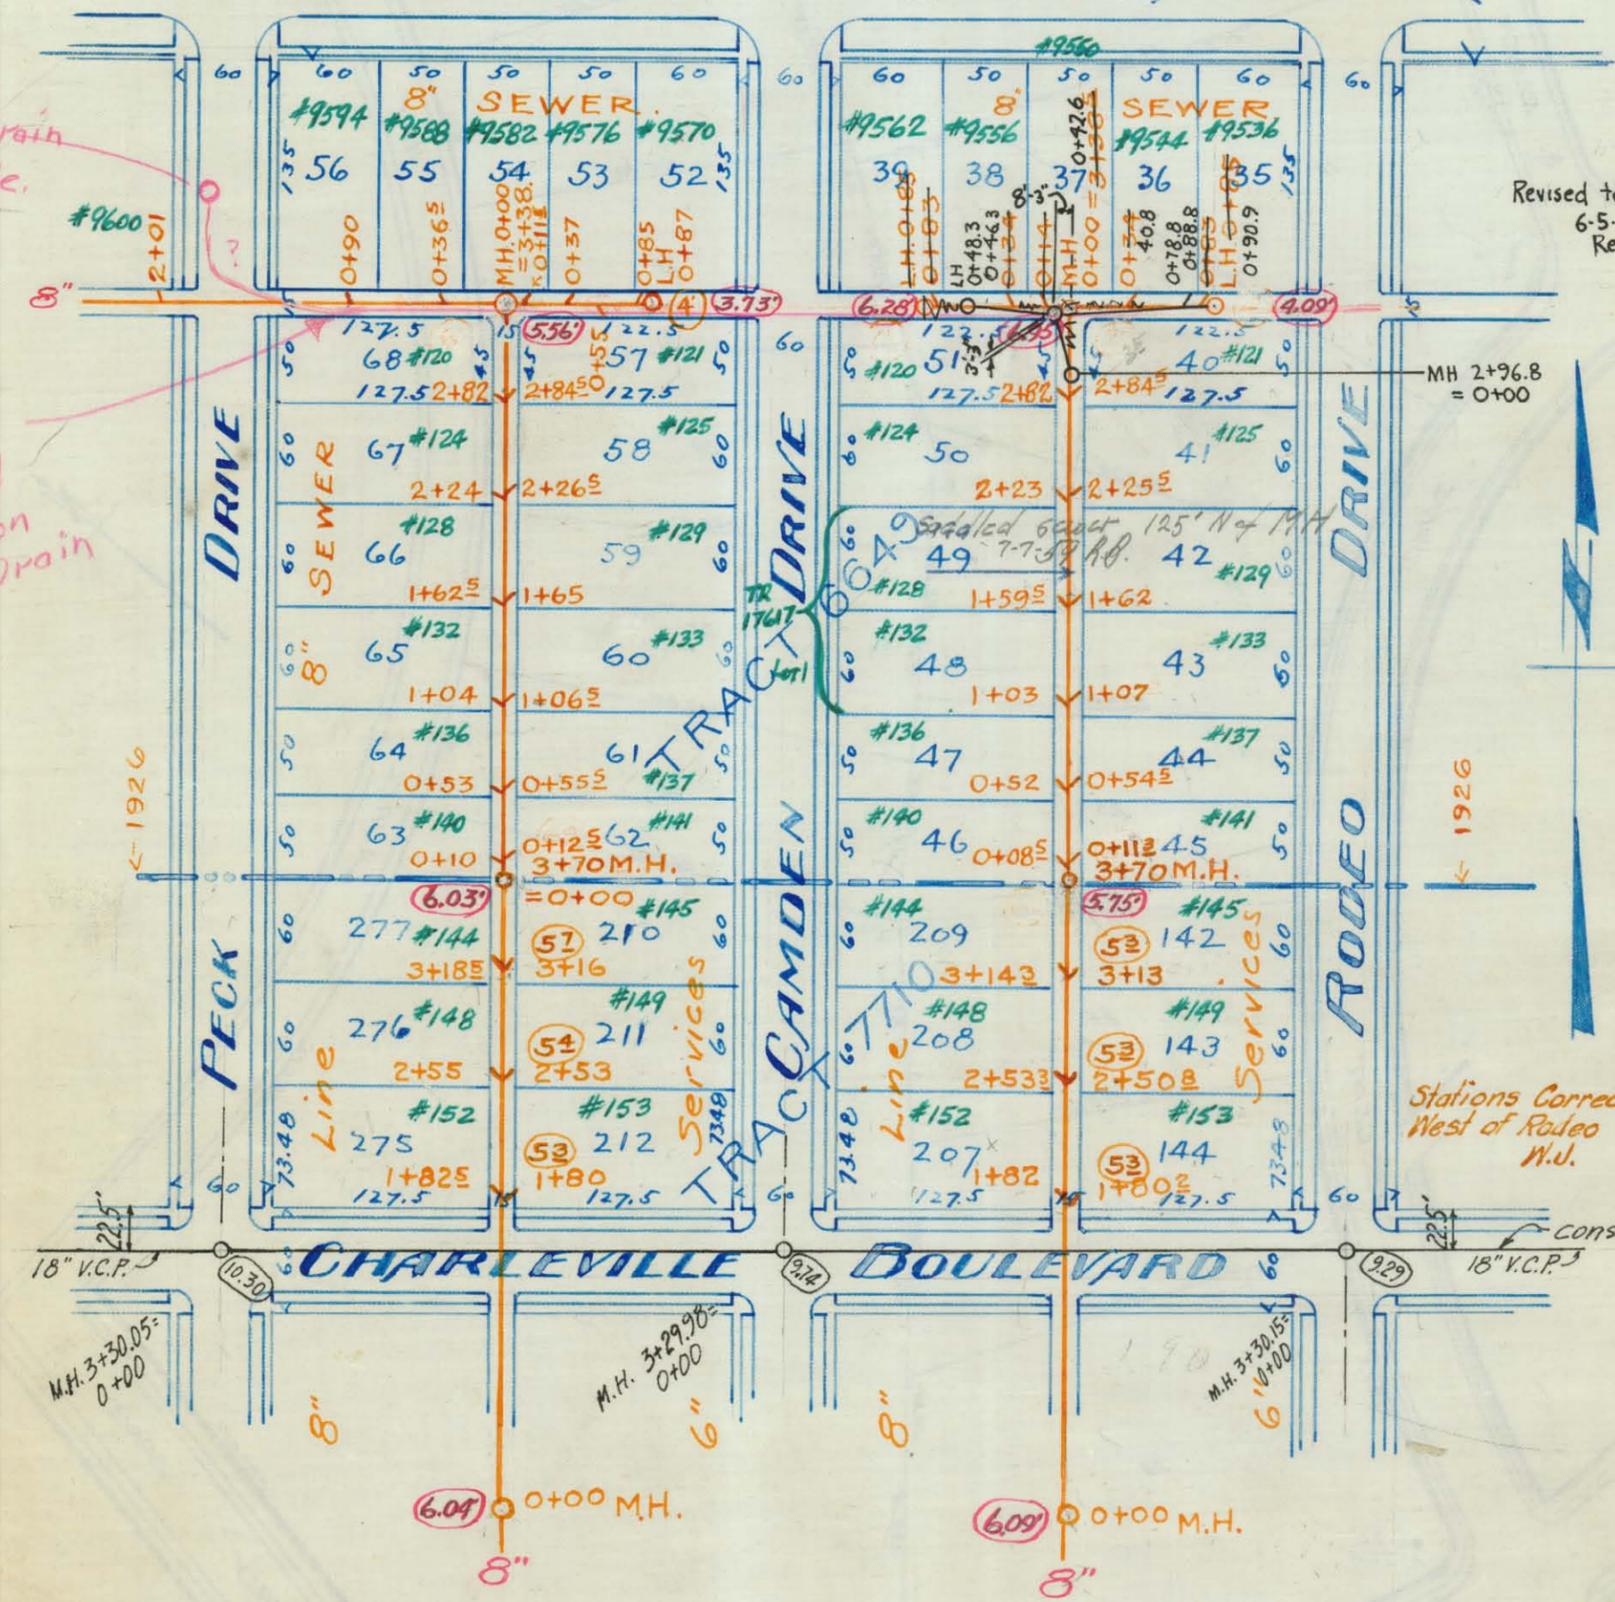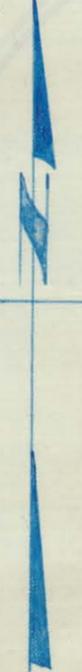


Pave: Both Alleys - 5" A.C. (including  
 Cross Alleys).  
 Services to R.

LOTS  
 45 TO 68 TR. 6649  
 142 TO 144 }  
 207 TO 212 } TR. 7710  
 275 TO 277 }

**TRACT 7710 & 6649.**  
 M.B. 93 P 94-95 M.B. 70 P 54.  
**CITY OF BEVERLY HILLS.**  
 Scale, 1 inch = 100 ft.

72

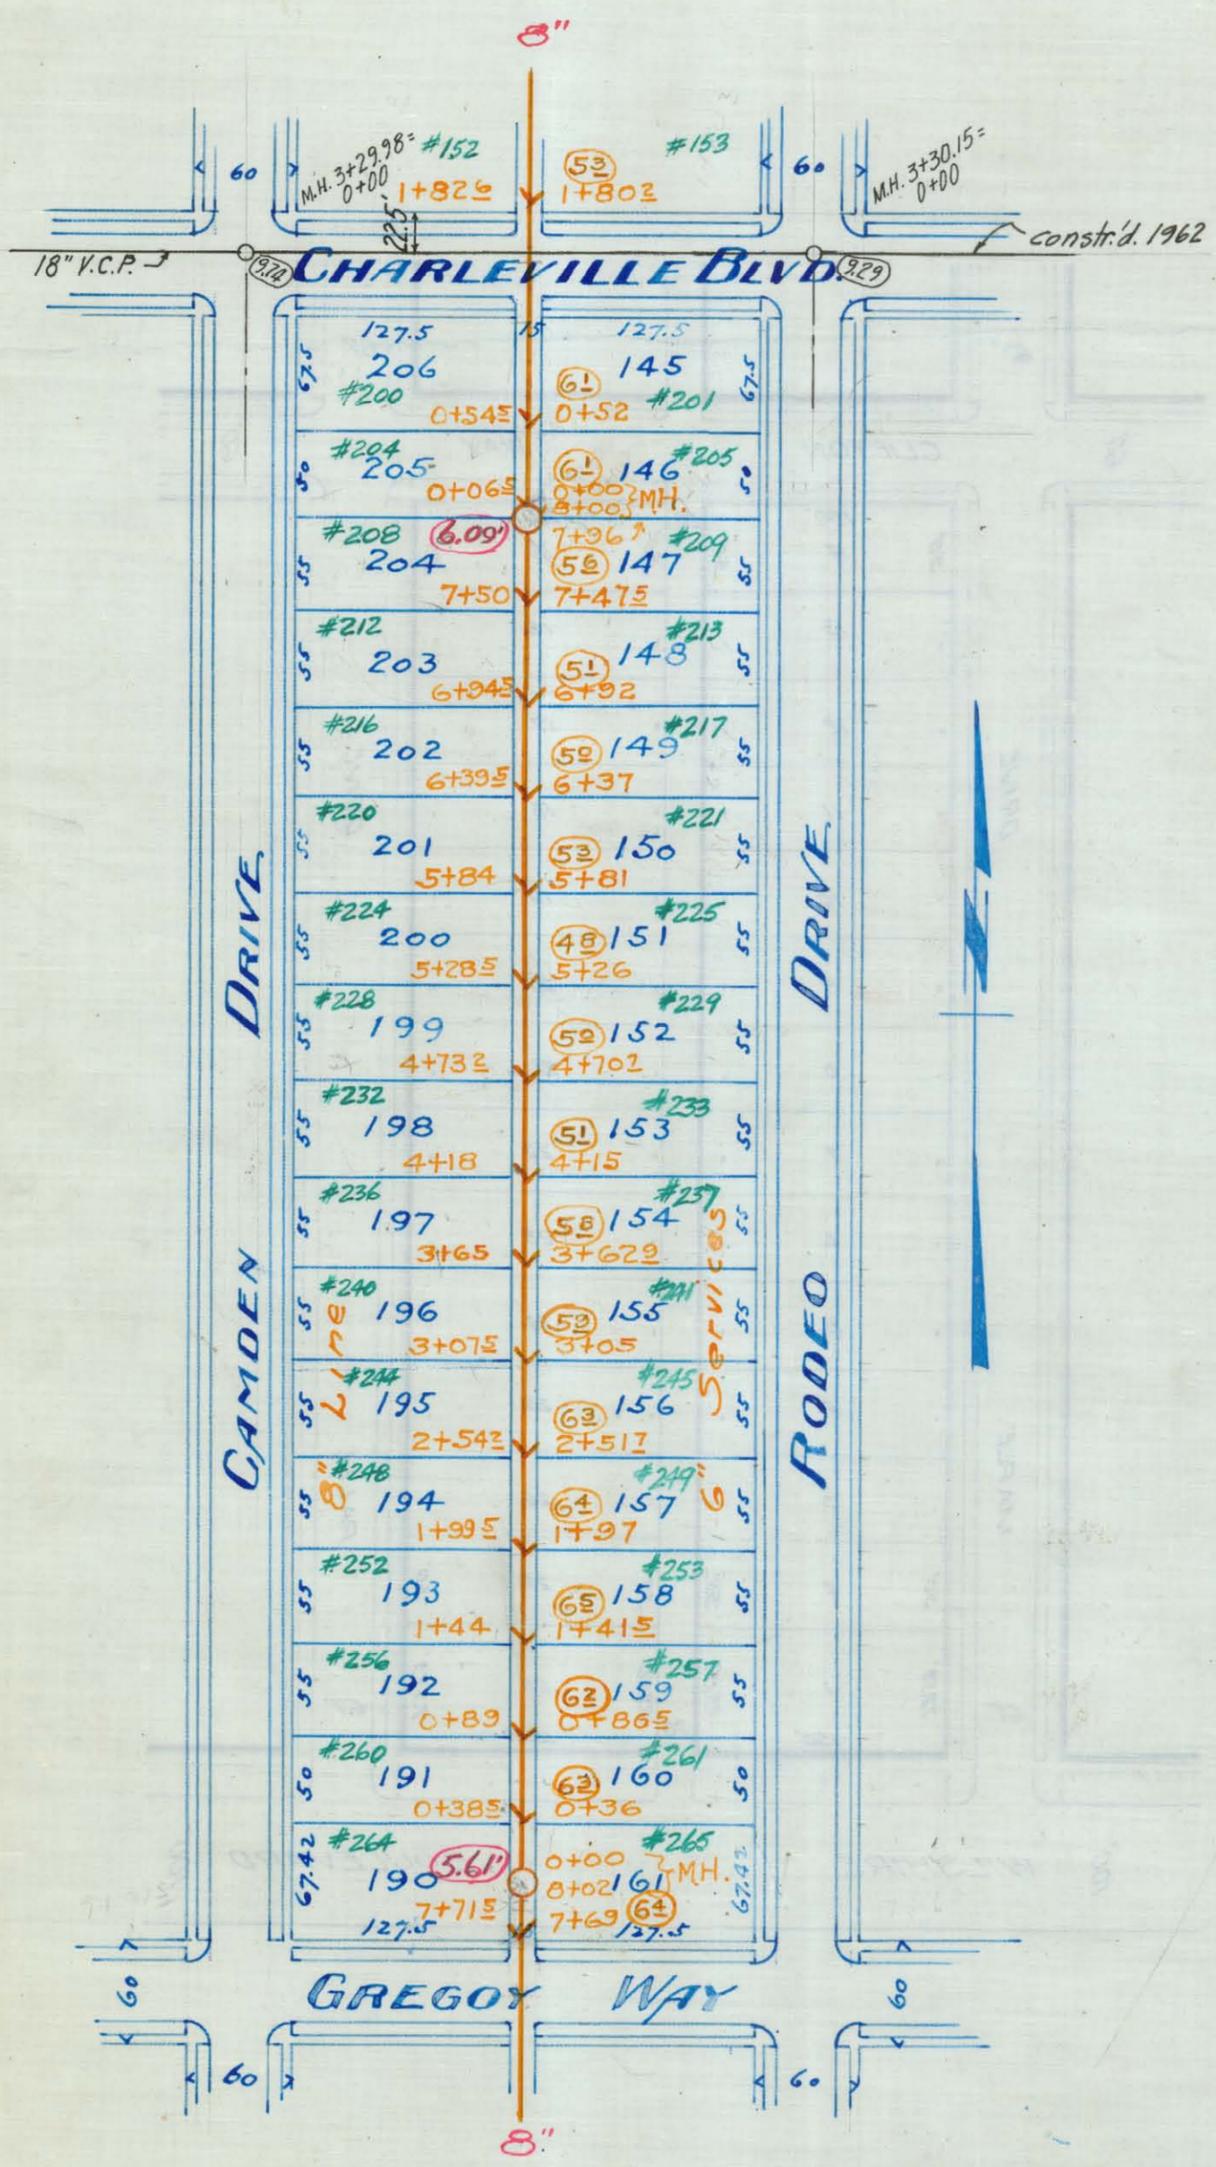


LOTS 145 to 161  
190 to 206

**TRACT 7710**  
M.B. 93 P. 94-95  
CITY OF BEVERLY HILLS.  
Scale, 1 inch = 100 ft.

73


BLOCK II  
 BEVERLY HILLS

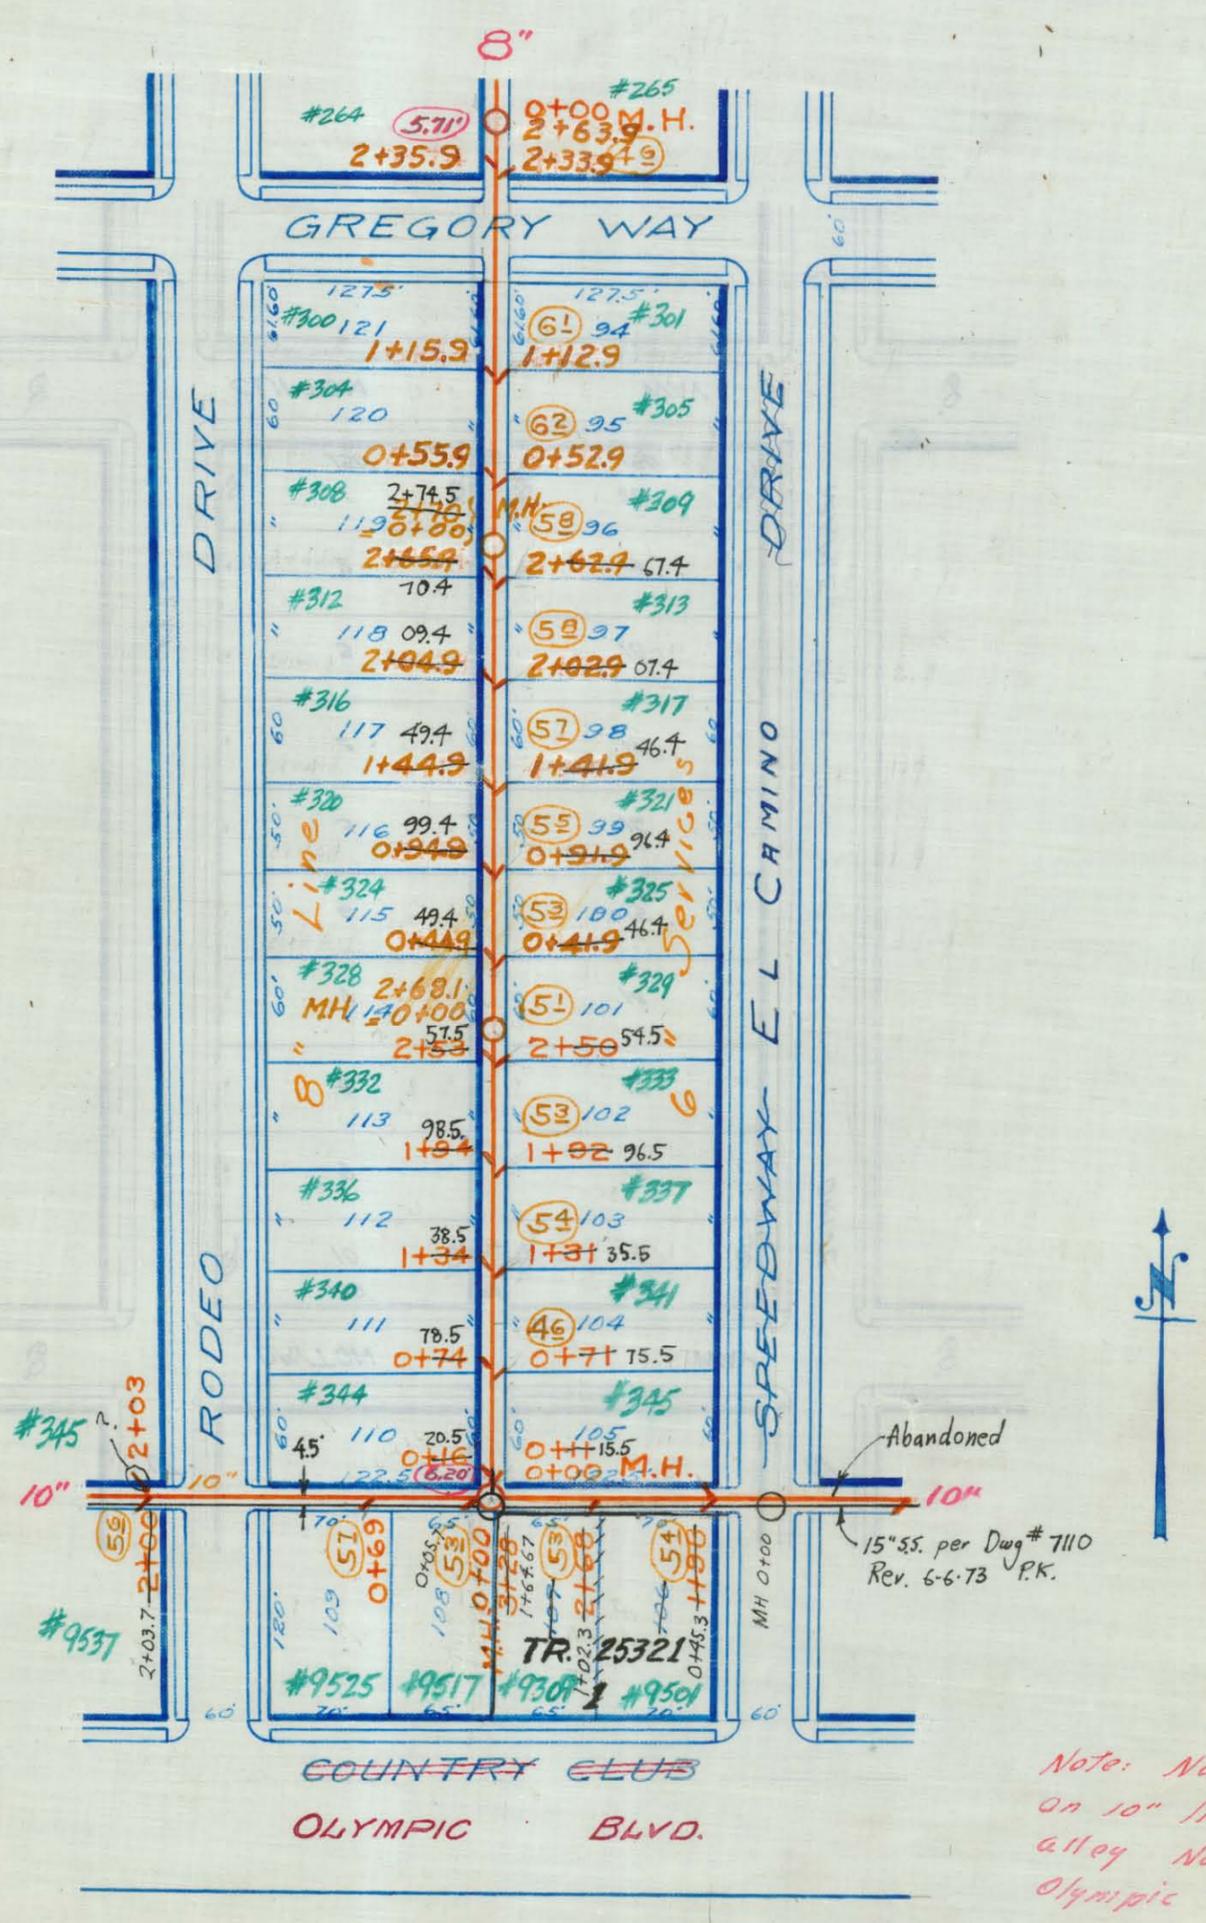

**TRACT 7710.**  
 M. B. 93 P. 94-95.  
 CITY OF BEVERLY HILLS.  
 Scale, 1 inch = 100 ft.

74



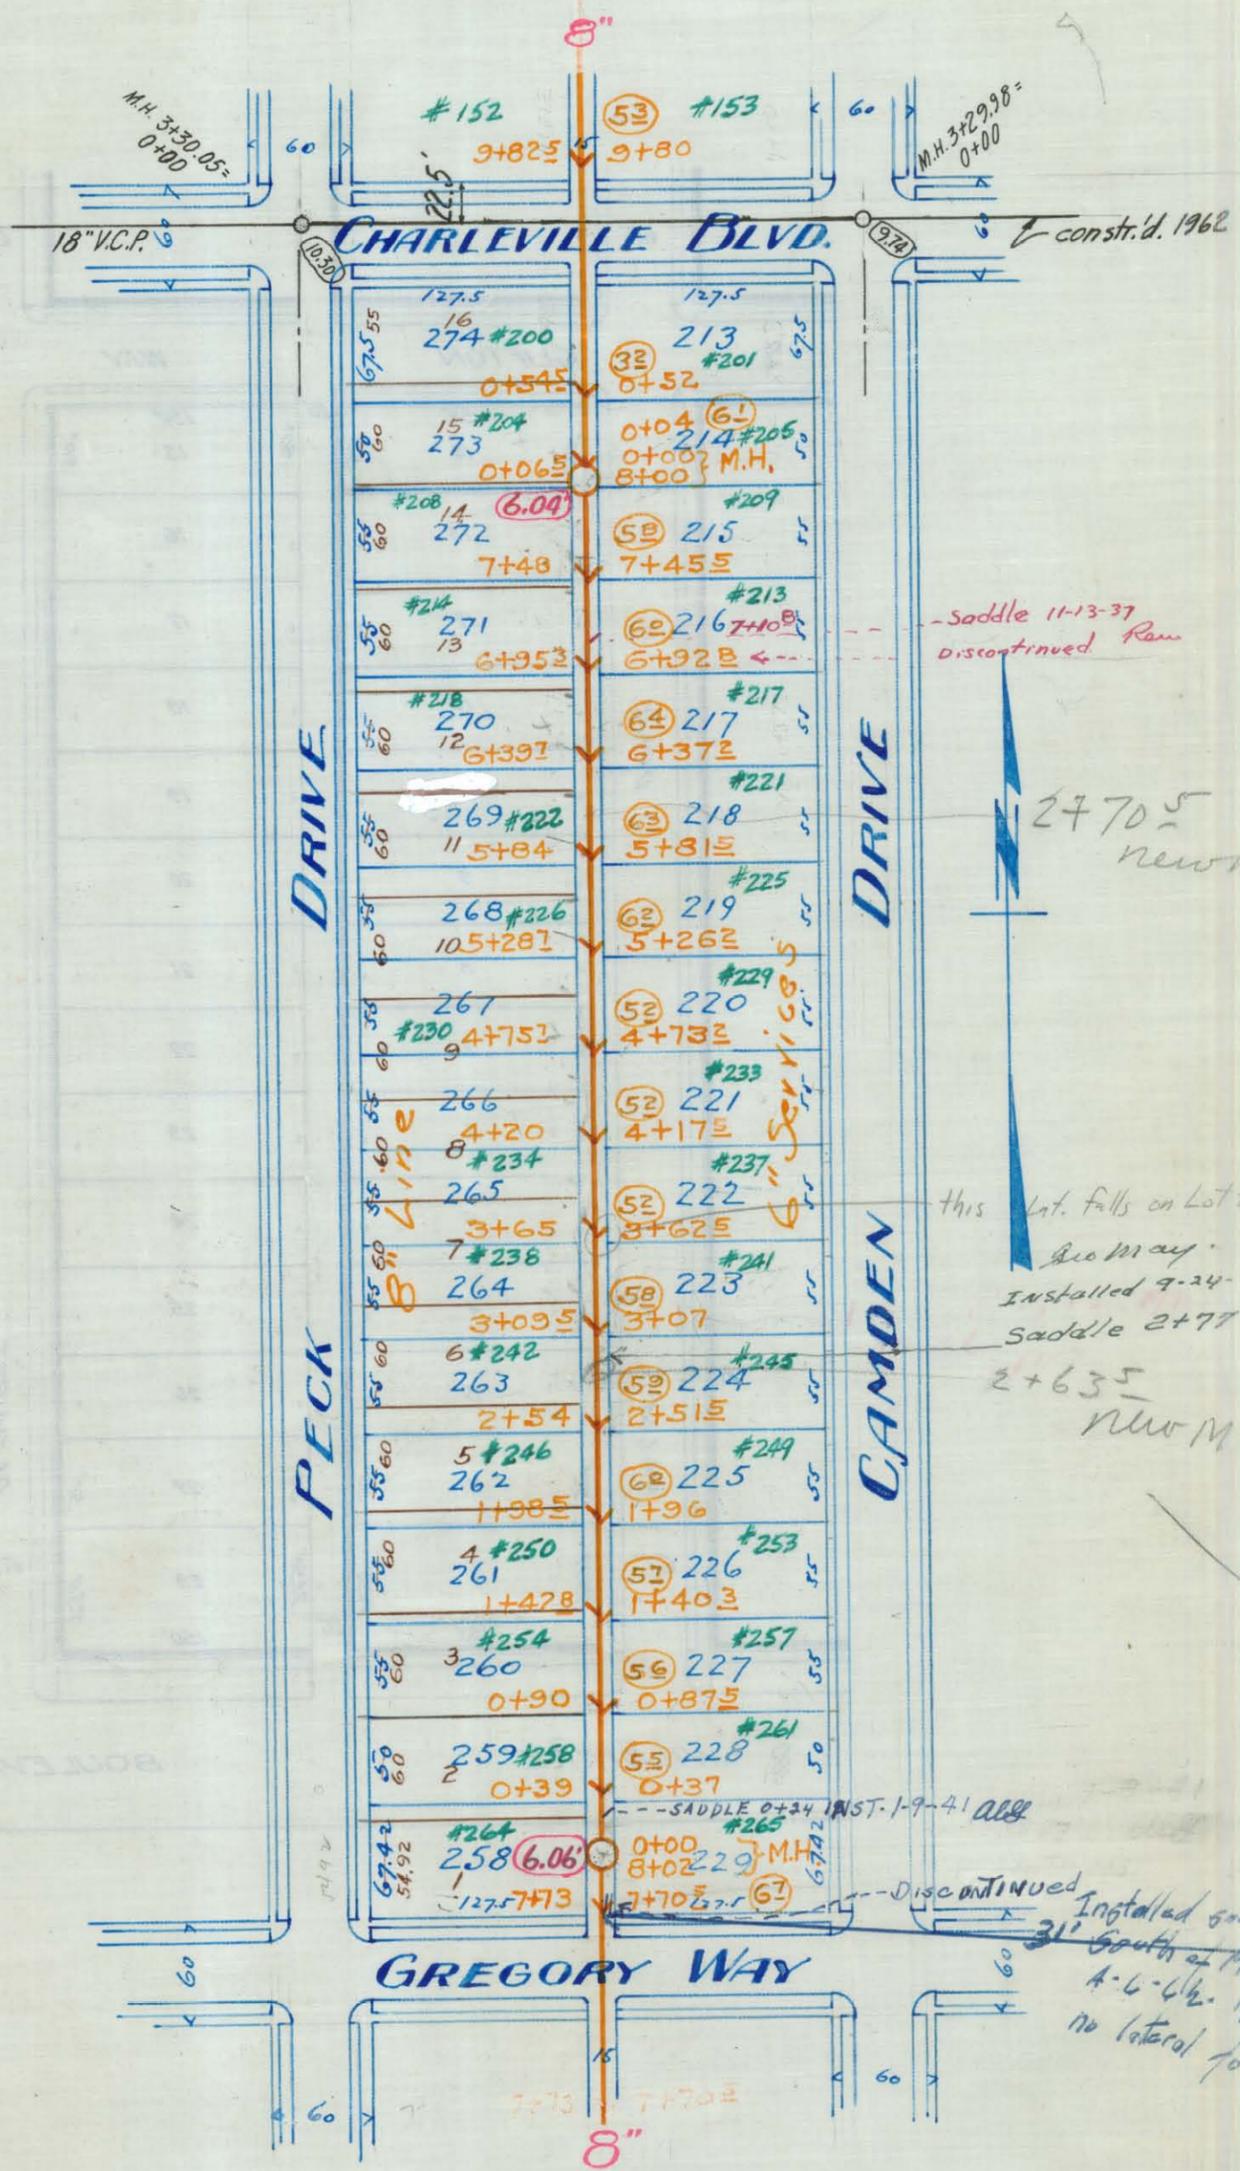

Saddle 11-13-37  
Discontinued Ram


27705  
New M.H.

this lot falls on Lot 223  
See Map  
Installed 9-24-47  
Saddle 2+77  
2+635  
New M.H.

LOTS 213 To 229  
258 To 274

TRACT 7710.  
M.B. 93 P. 94-95  
CITY OF BEVERLY HILLS.  
Scale, 1 inch = 100 ft.

76

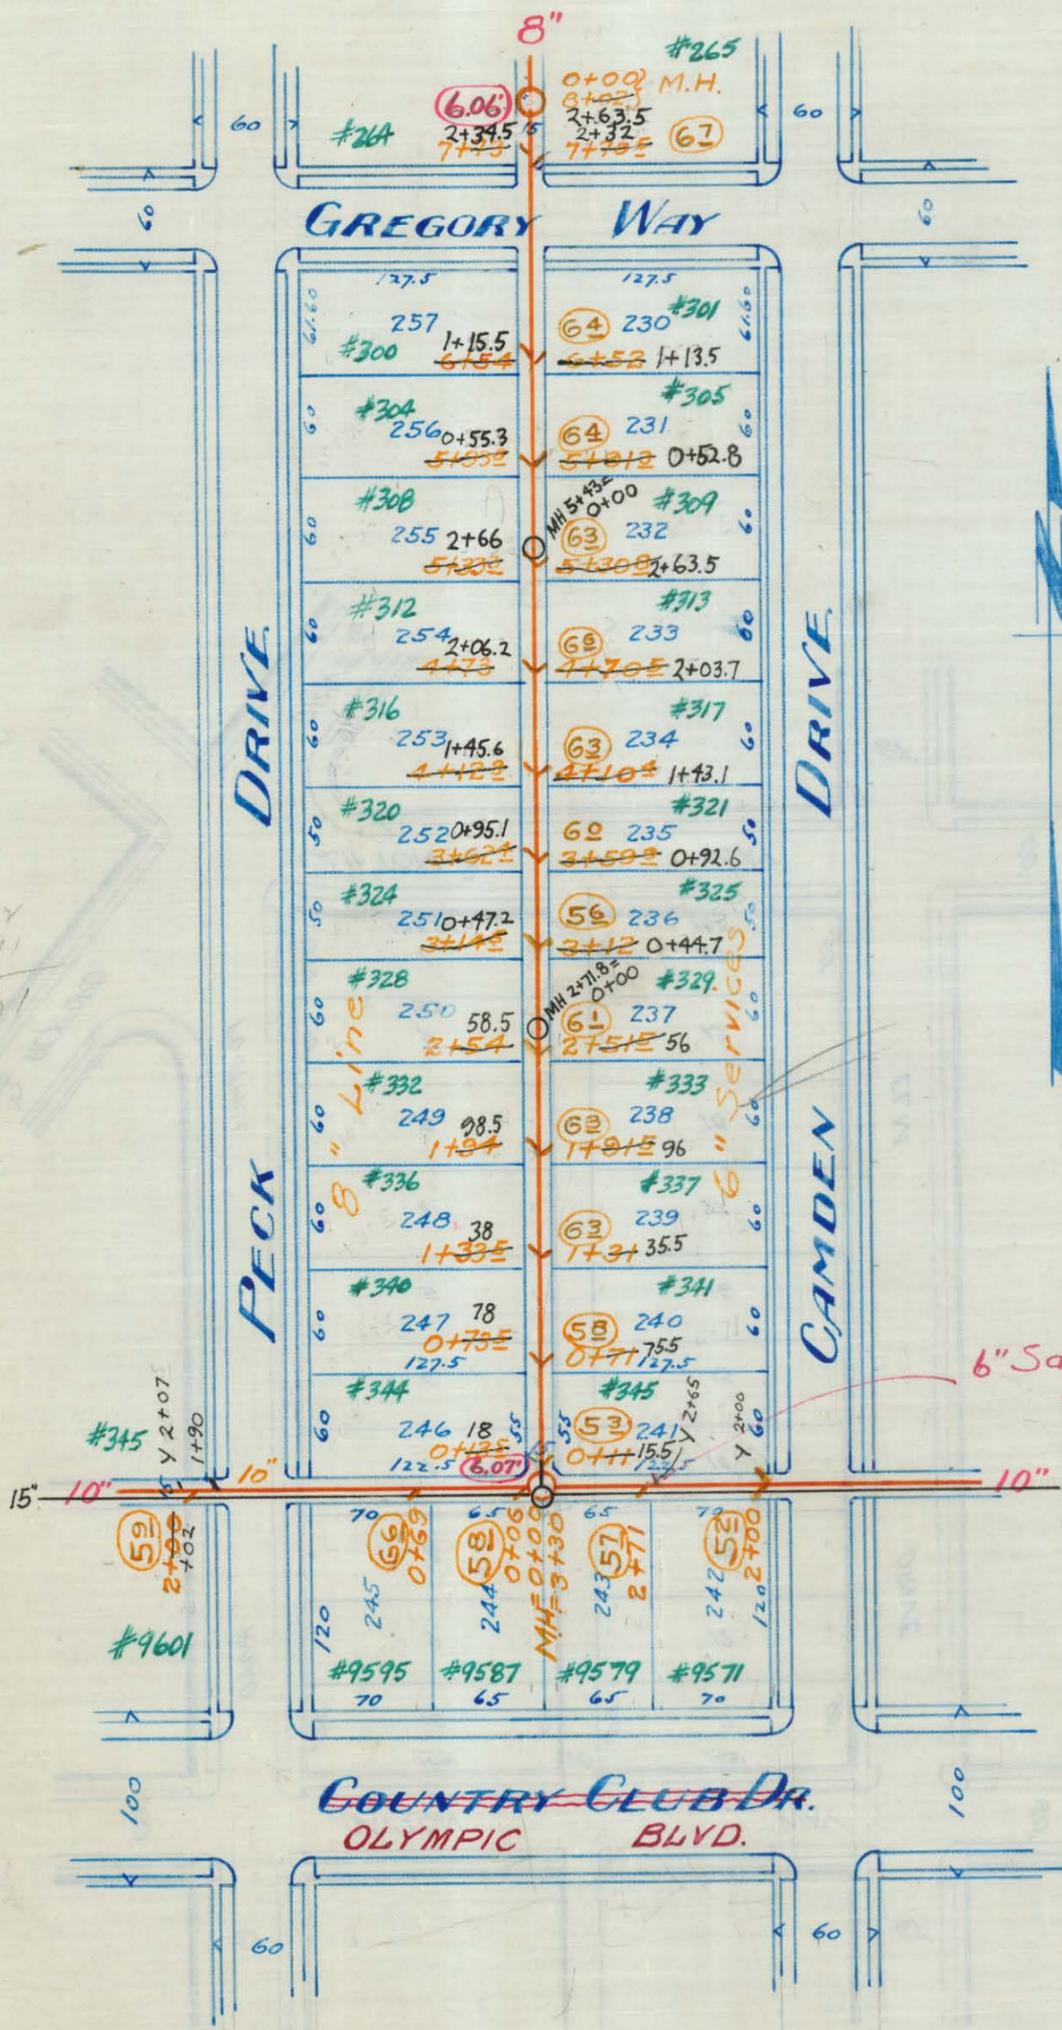

$$\begin{array}{r} 5+31 \\ 4 \quad 13 \\ \hline 1 \quad 18 \end{array}$$
  
 804  
 271  

$$\hline 531$$

$$\begin{array}{r} 4 \quad 13 \\ \hline 1 \quad 46 \end{array}$$

6" Saddle 66' East of M.H.  
3-13-36 B.M.


15" S.S. per Diag. 7110  
Rev. 6-6-73

Note: No Saddles  
on 10" line in alley  
North of Olympic.



LOTS 230 to 257

**TRACT 7710.**  
 M.B. 93 P 94-95.  
**CITY OF BEVERLY HILLS.**  
 Scale, 1 inch = 100 ft.

77

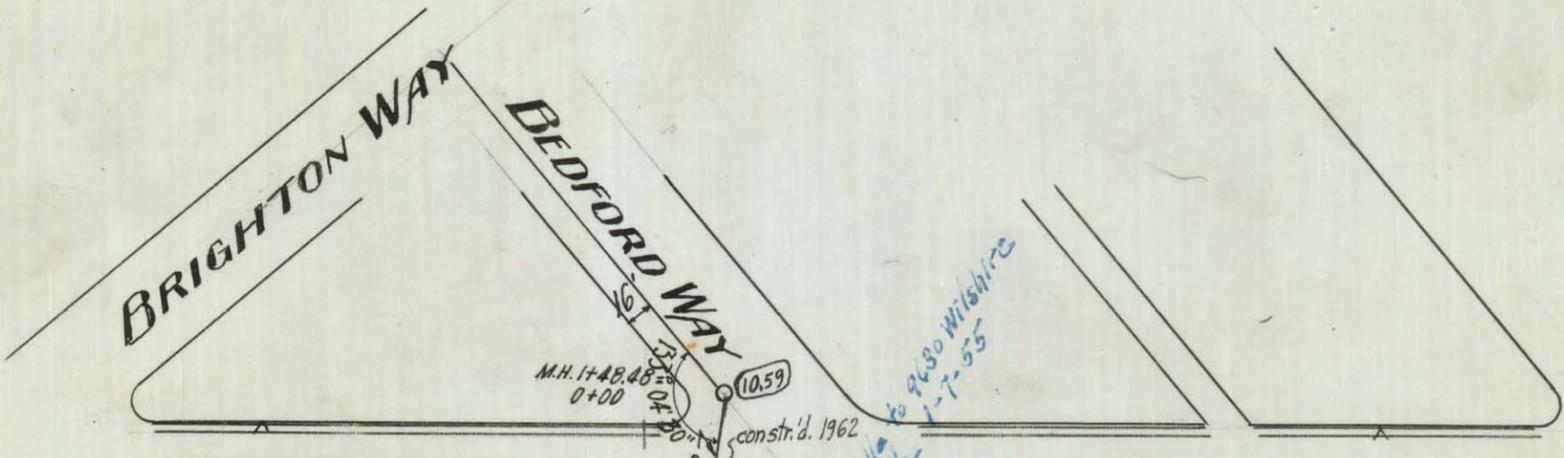

100 WILSHIRE BOULEVARD 100

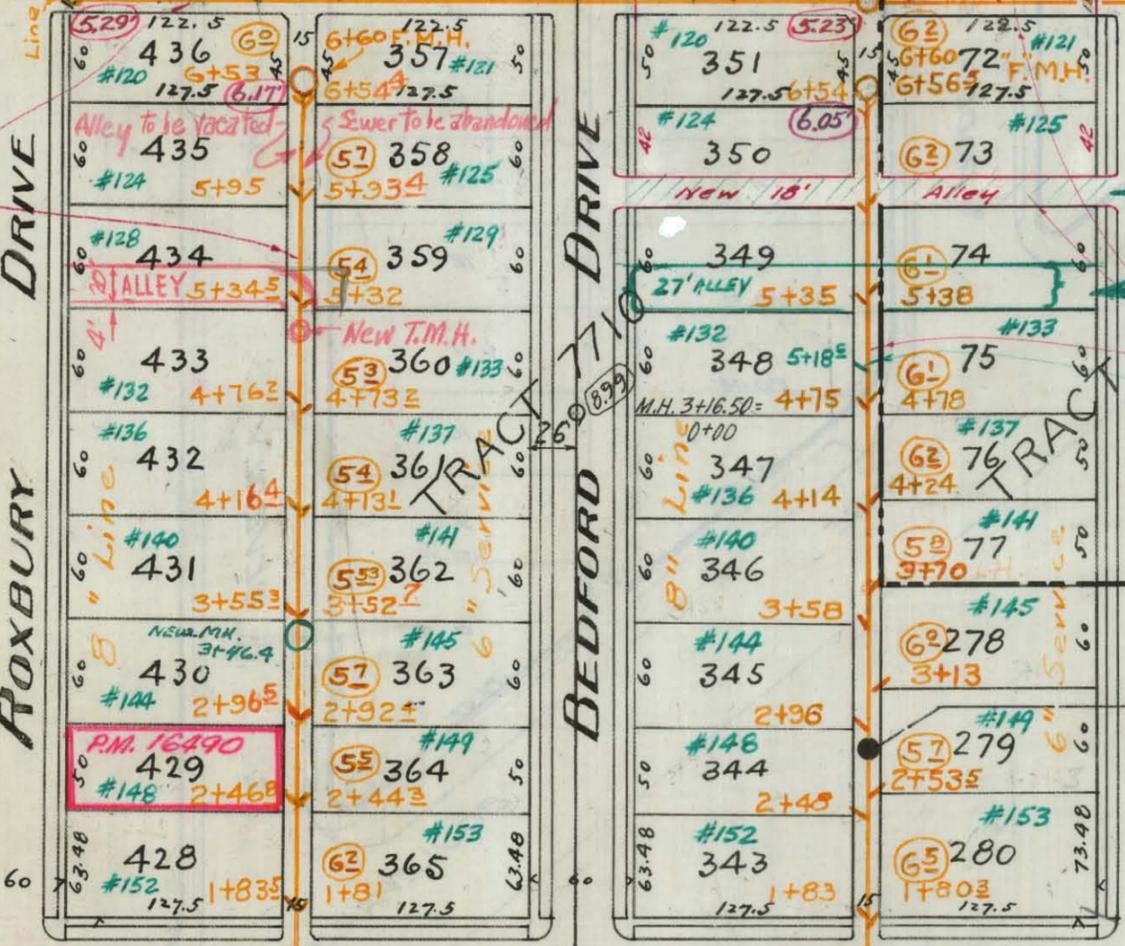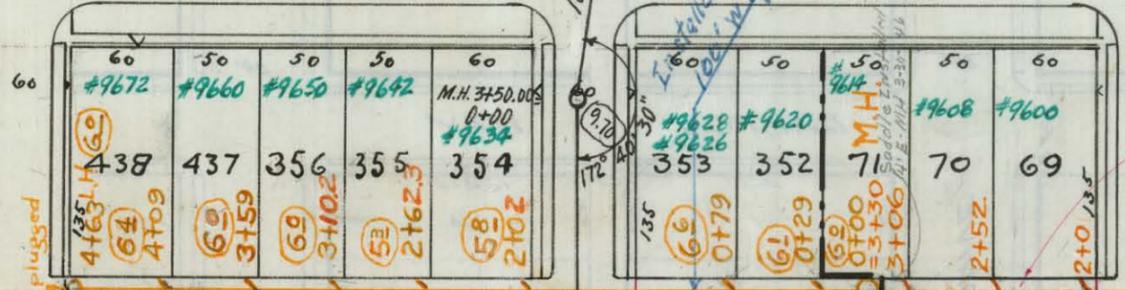

Pave: 5" A.C. Services to B.

VACATED - SEE MAP PANEL NEW ALLEY

Pave: 5" A.C. Serv. to B. H.C. @ 231.5' N/O S. M.H. 12-14-04

2+87.00 M.H. CONSTD. 1968

Stations Corrected Alley West of Peck Feb, 1936. W.D.

constr. d. 1962

Stationing Corrected Alley West of Bedford Aug, 1939 L.V.M.

**TRACT 7710 and 6649**  
 M.B. 93 P. 94-95, M.B. 70 P. 54.  
**CITY OF BEVERLY HILLS.**

Scale, 1 inch = 100 ft.

- LOTS**  
 69 TO 77 T.R. 6649  
 278 TO 280 }  
 343 TO 365 } TR 7710  
 428 TO 438 }

182  
225

4" A.C. Pavement

Sewer Y Stationing has been corrected LVM 7/15/41


New MH's Built by the City June 1941.



TRACT 7710 - 2982  
M.B. 93 P. 94-95  
CITY OF BEVERLY HILLS.  
Scale: 1 inch = 100 ft.

79

20016 INCH = 100 FT  
 BLOCK 15  
 WEST ON TOWERS

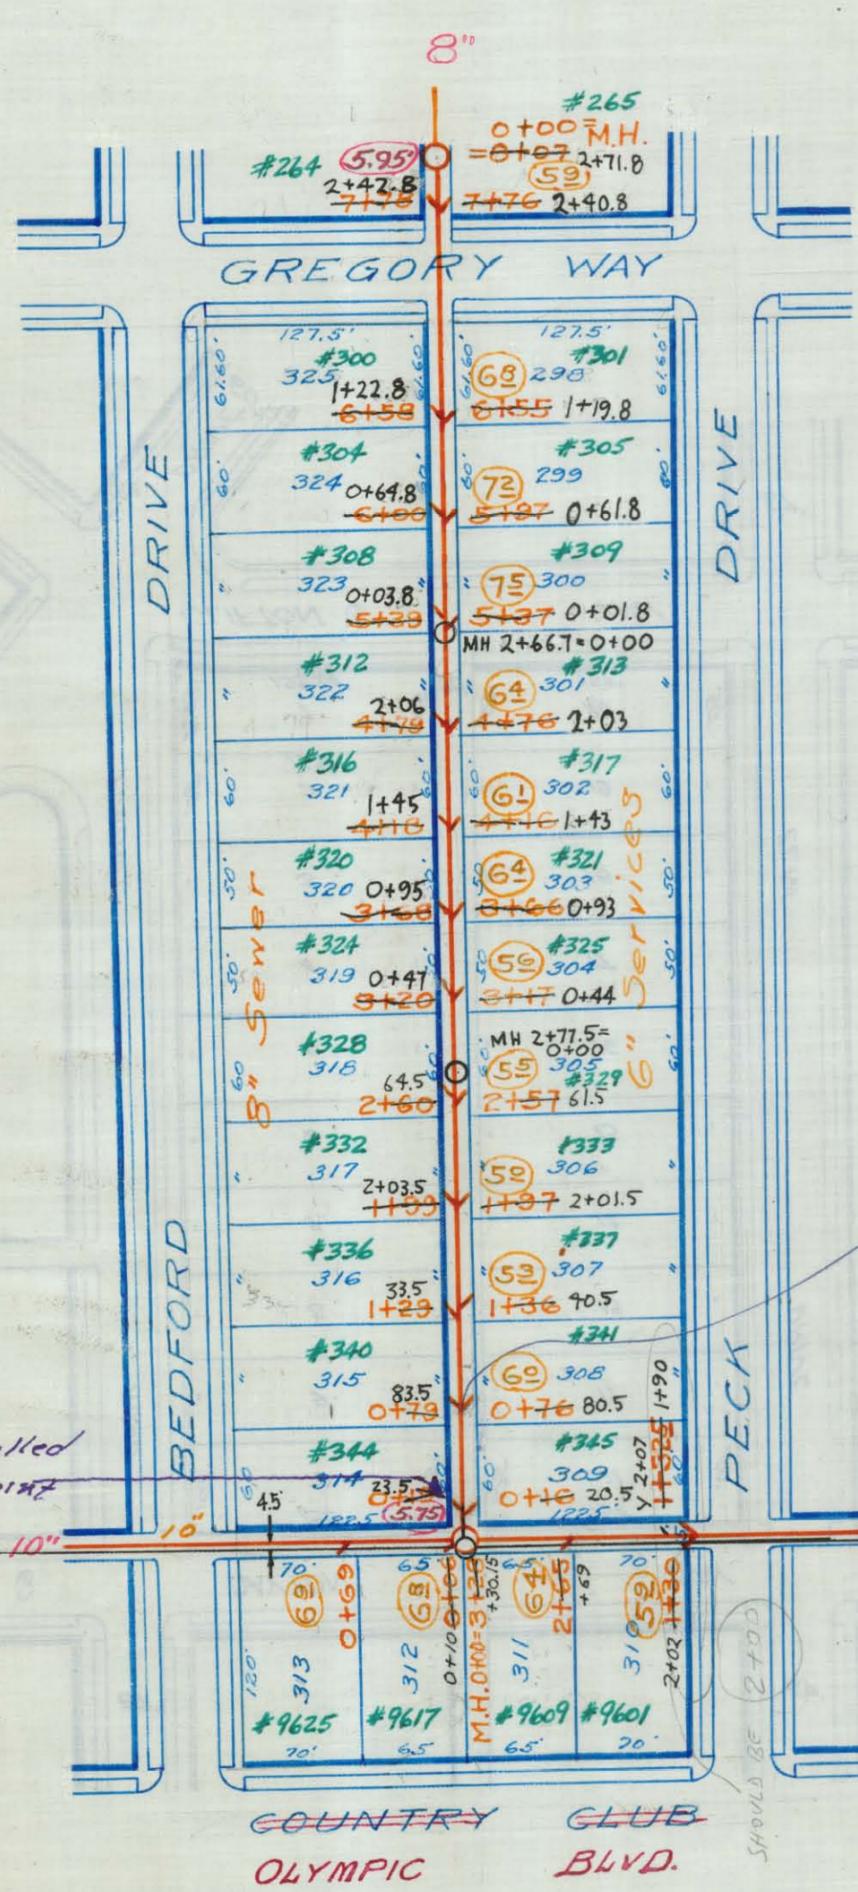

N. M.H. 7-17-47  
 19' 3" Saddle Installed  
 No 'Y' at this point  
 Permit # 7530

No 'Y' at this point  
 6" Saddle installed  
 76' No. of M.H. 7-29-36  
 Permit #

Abandoned  
 15" S.S. per Day #7110  
 Rev. 6-6-73 P.R.

Note: No Saddles  
 on 10" line in  
 alley North of  
 Olympic.


# TRACT 7710.

M.B. 93. P.94-95.

CITY OF BEVERLY HILLS.

Scale, 1 inch = 100 ft.

2016 1/4" = 100'  
 BLOCK 13  
 REAR ONTRACT

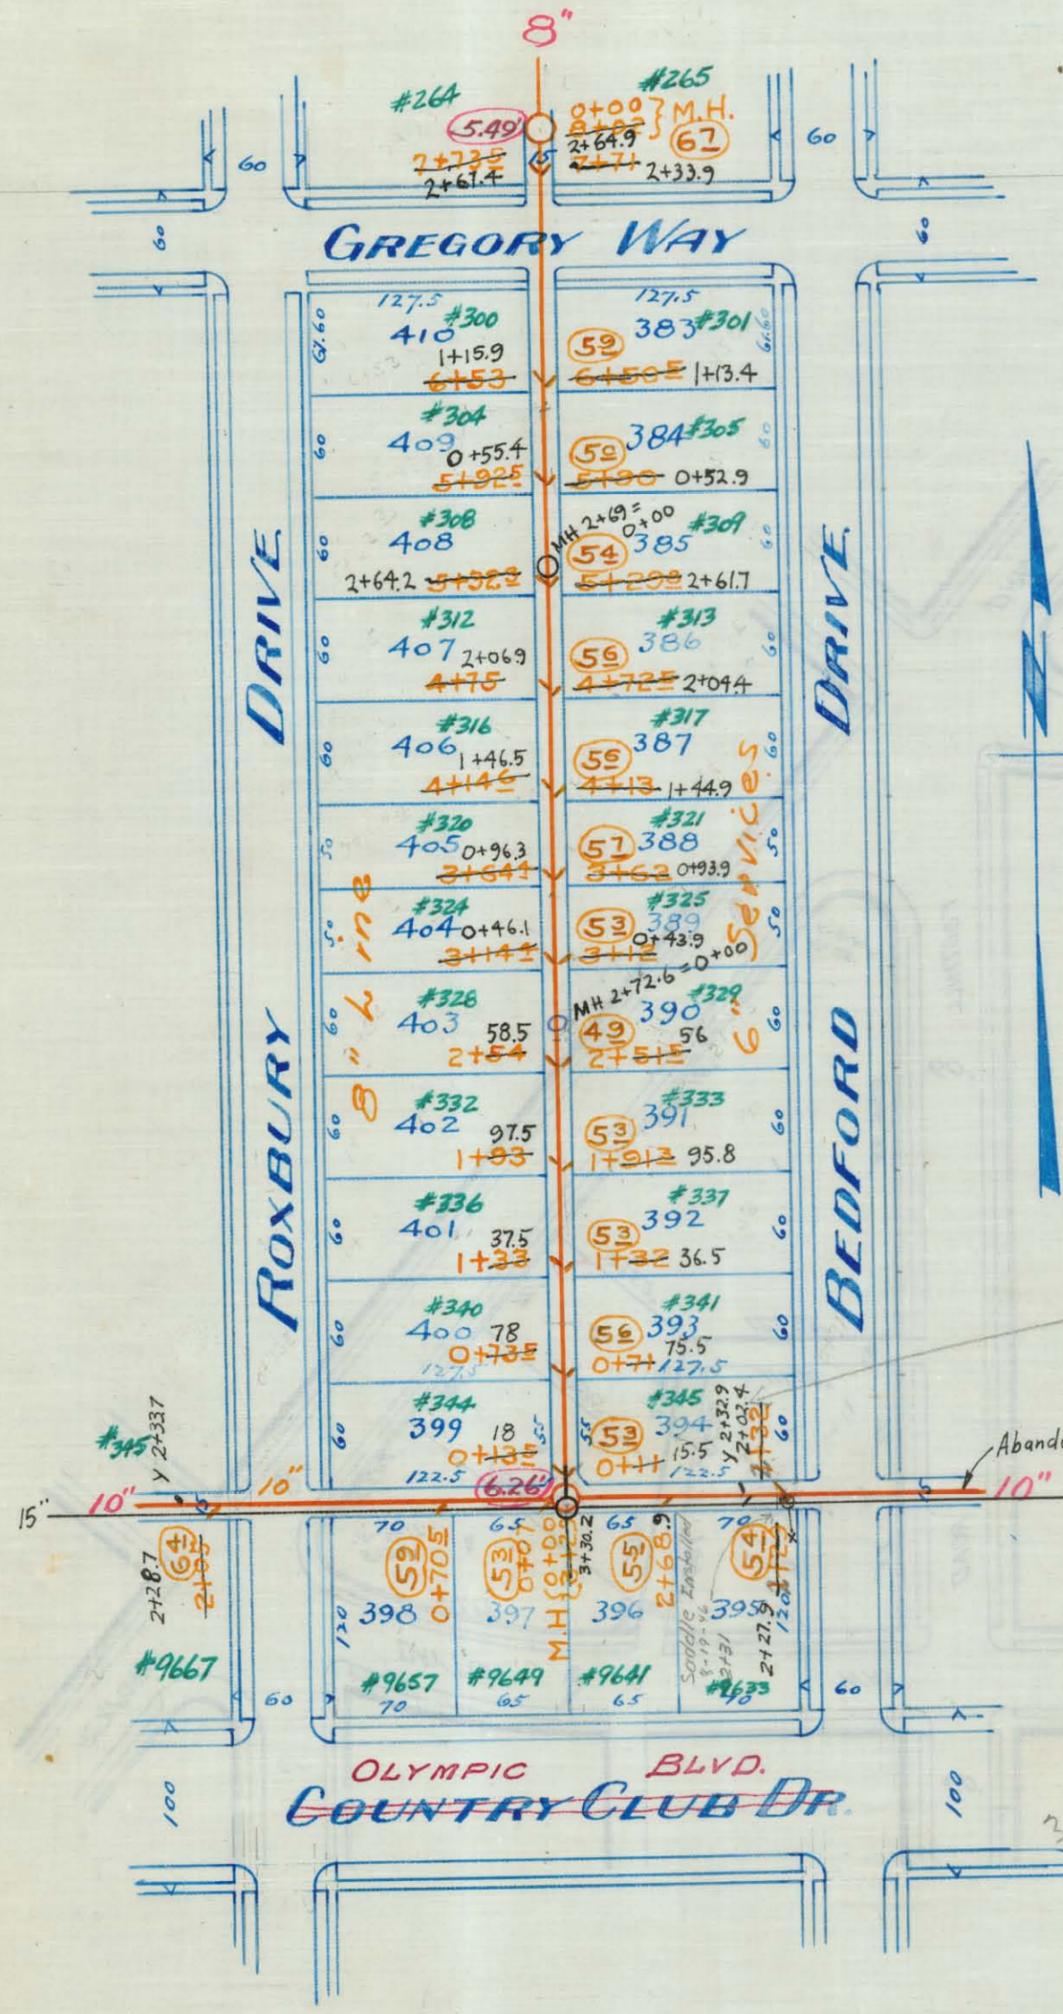

SEE 7110 SHEET 4  
 RE. THESE MEASUREMENTS.

Abandoned  
 15" S.S. per Dwg. No. 7110  
 Rev 6.7.73 P.K.

Note: No Saddles  
 on 10" line in  
 alley North of  
 Olympic.

LOTS 383 to 410

**TRACT 7710**  
 M.B. 93 P.94-95  
**CITY OF BEVERLY HILLS.**  
 Scale, 1 inch = 100 ft.

LINDEN DRIVE

ROXBURY DRIVE

BRIGHTON WAY


WILSHIRE BOULEVARD

CHARLEVILLE BOULEVARD

LINDEN DRIVE

McCARTY DRIVE

ROXBURY DRIVE

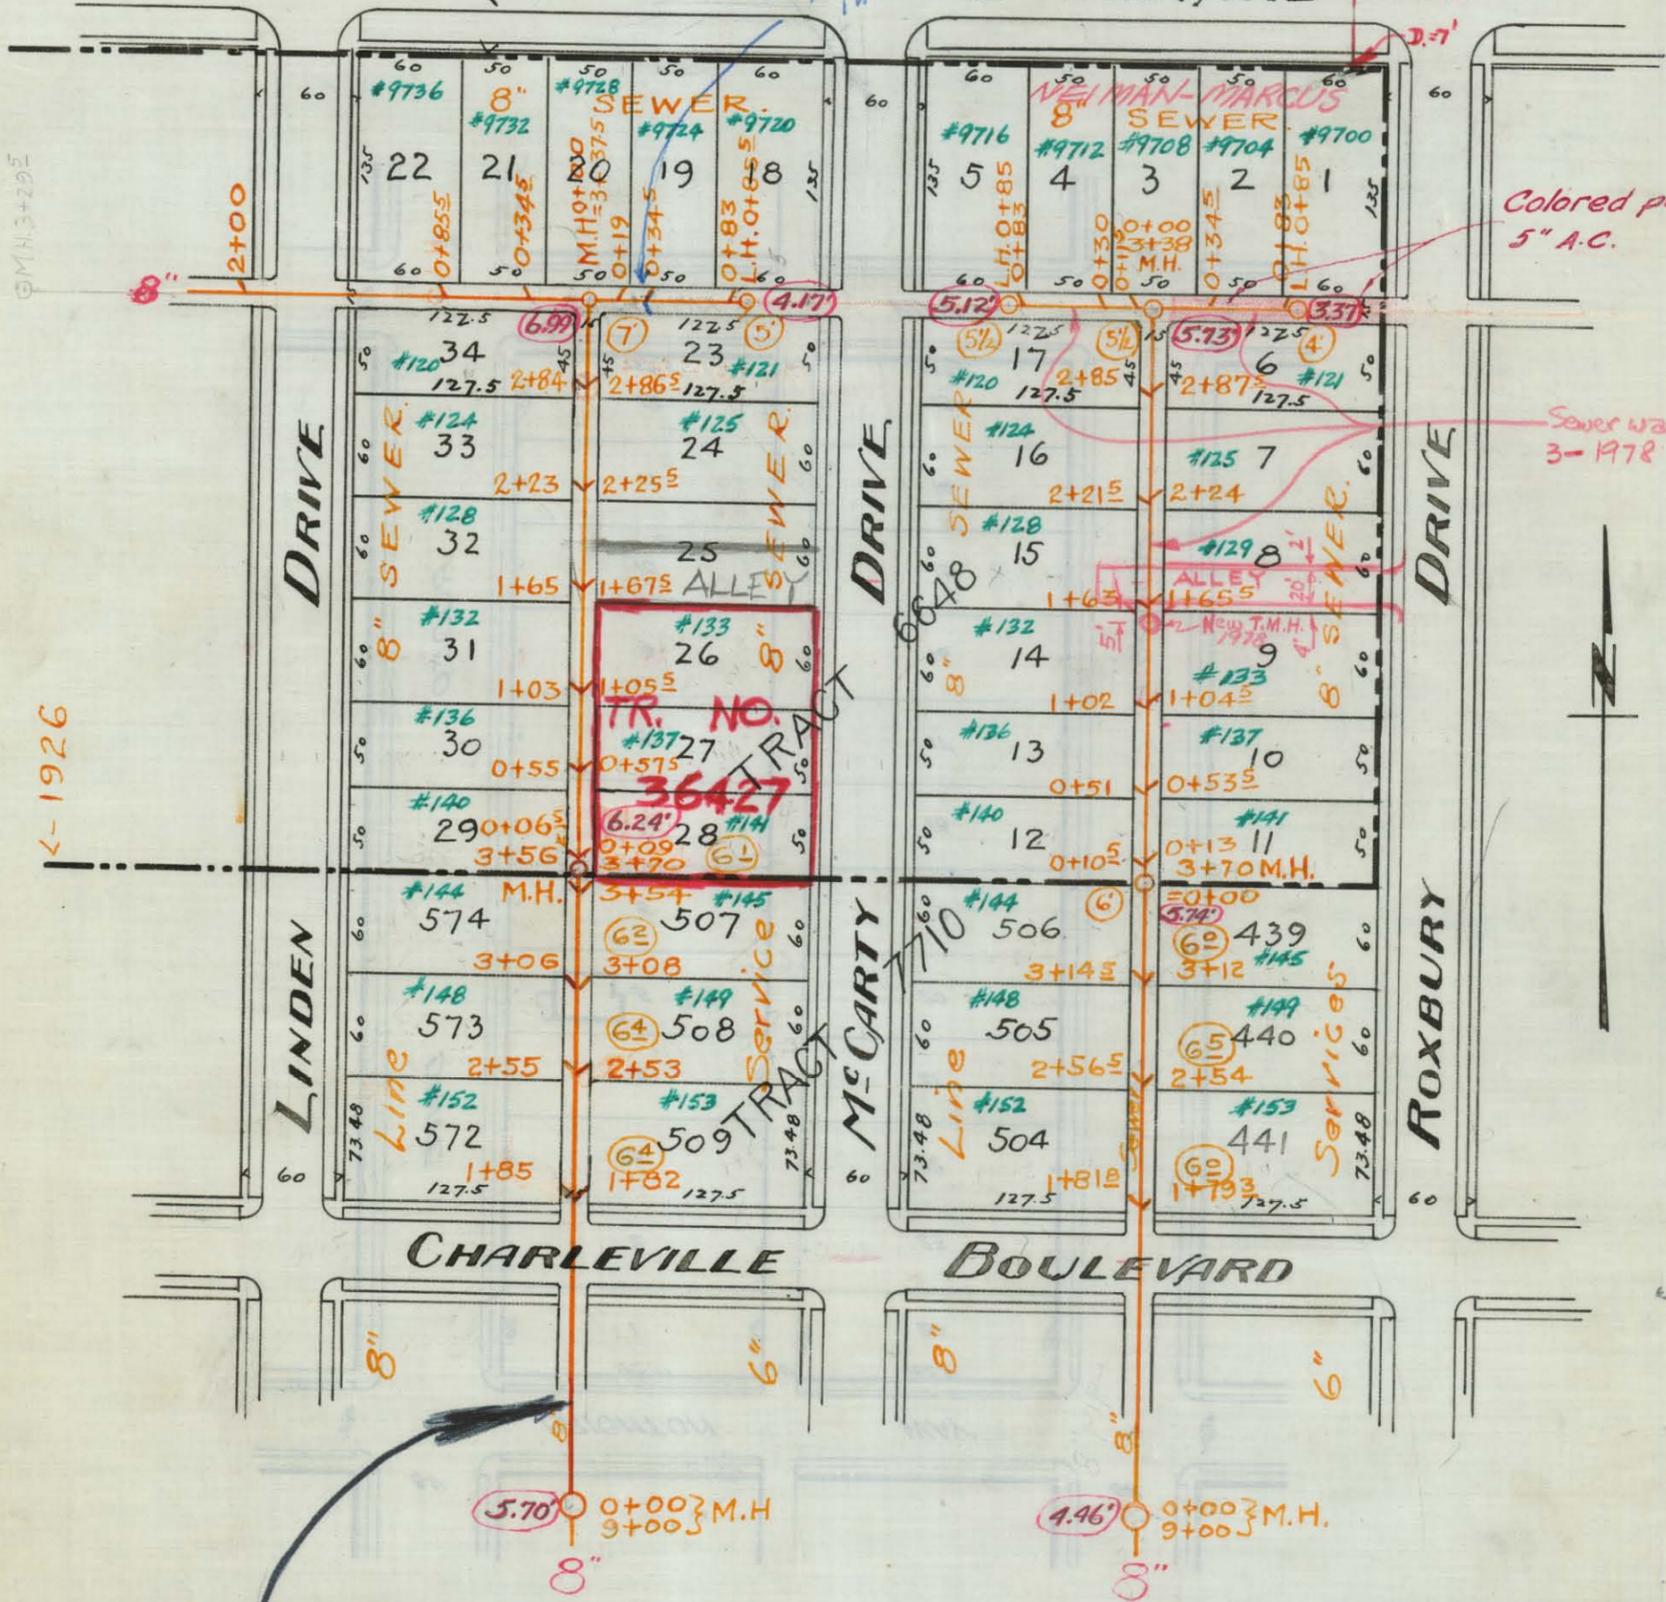

Colored portions 5" A.C.

Sewer was removed 3-1978

← 1926

← 1926

SEE NEW SEWER PLAN & PROFILE NO. 7194-3

# TRACT 7710 & 6648


M.B. 93 P94-95, M.B. 71 P49

## CITY OF BEVERLY HILLS

Scale, 1 inch = 100 ft.

### LOTS


1 TO 34 TR. 6648  
 439 TO 441 }  
 504 TO 509 } TR. 7710  
 572 TO 574 }

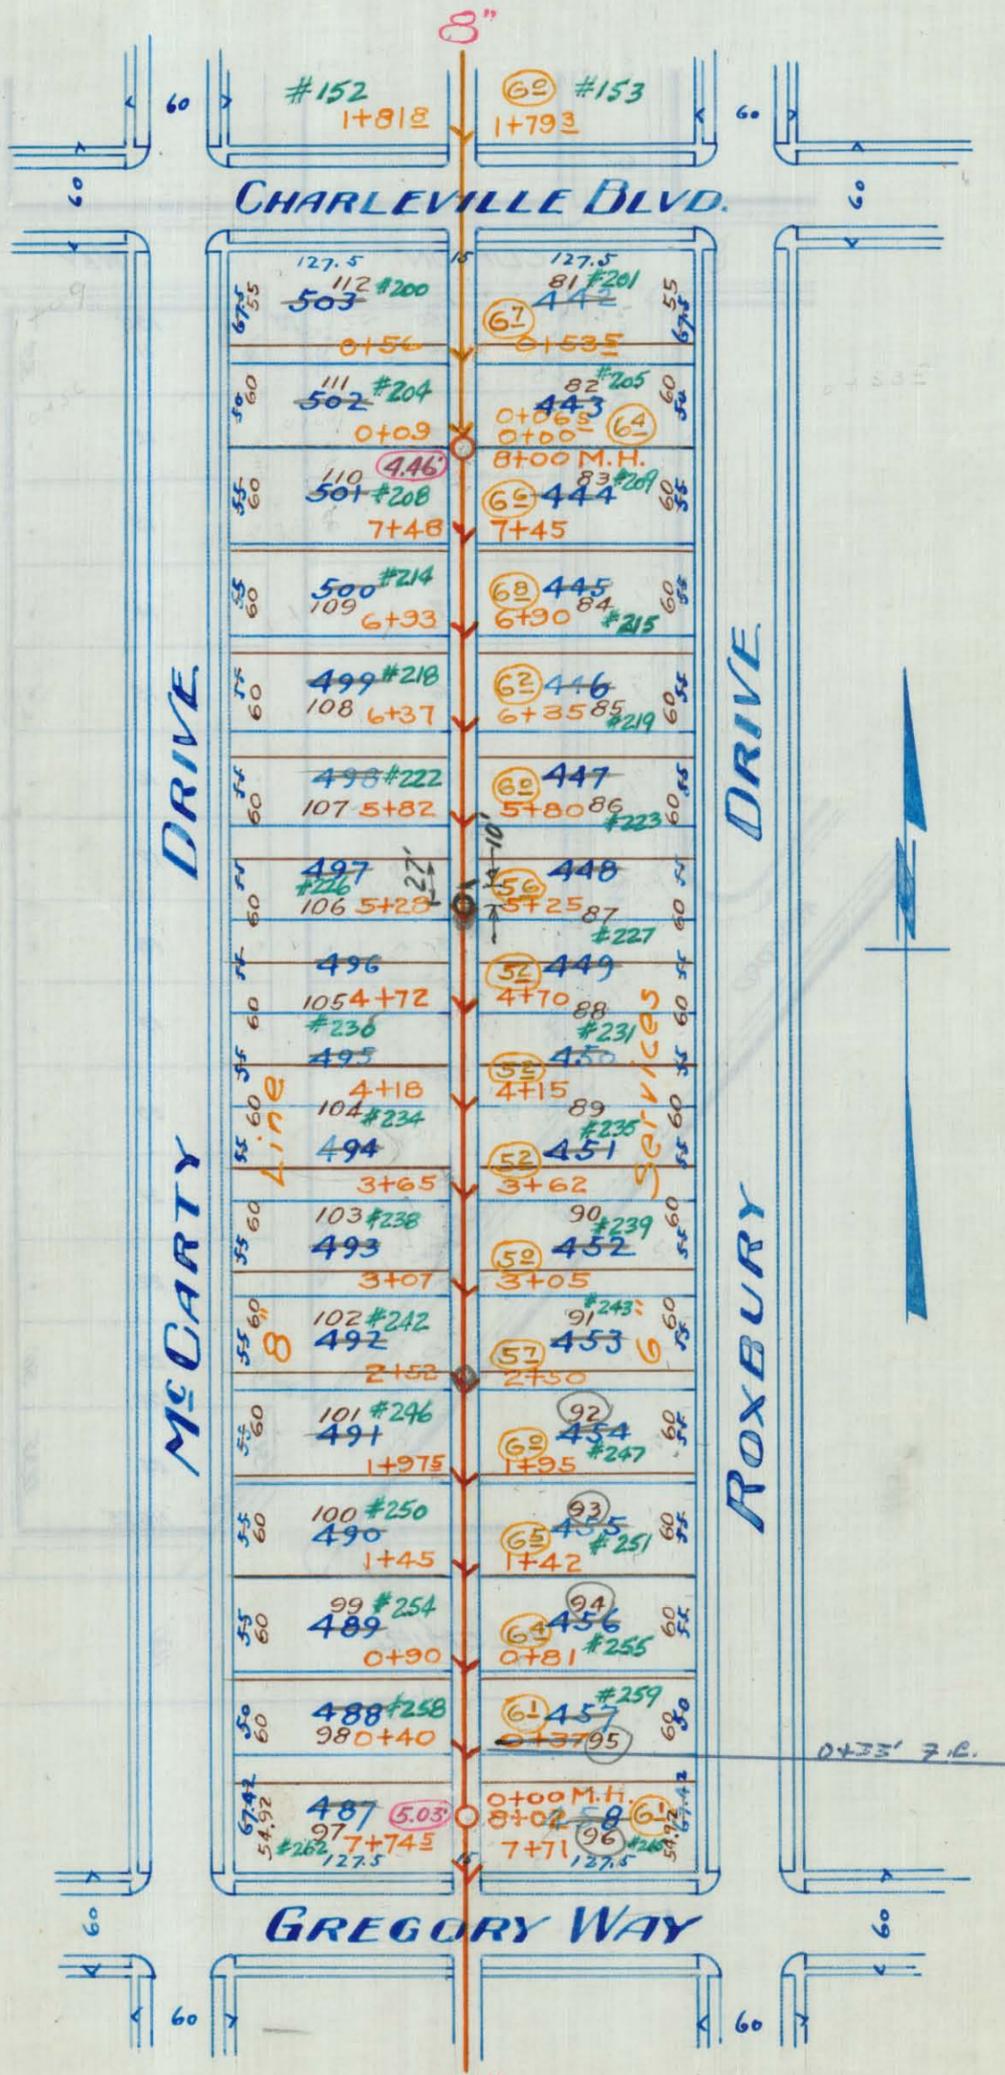

LOTS 442 To 458  
487 TO 503

8982

**TRACT 7710**  
M.B. 93 P 94-95  
**CITY OF BEVERLY HILLS.**  
Scale, 1 inch = 100 ft.

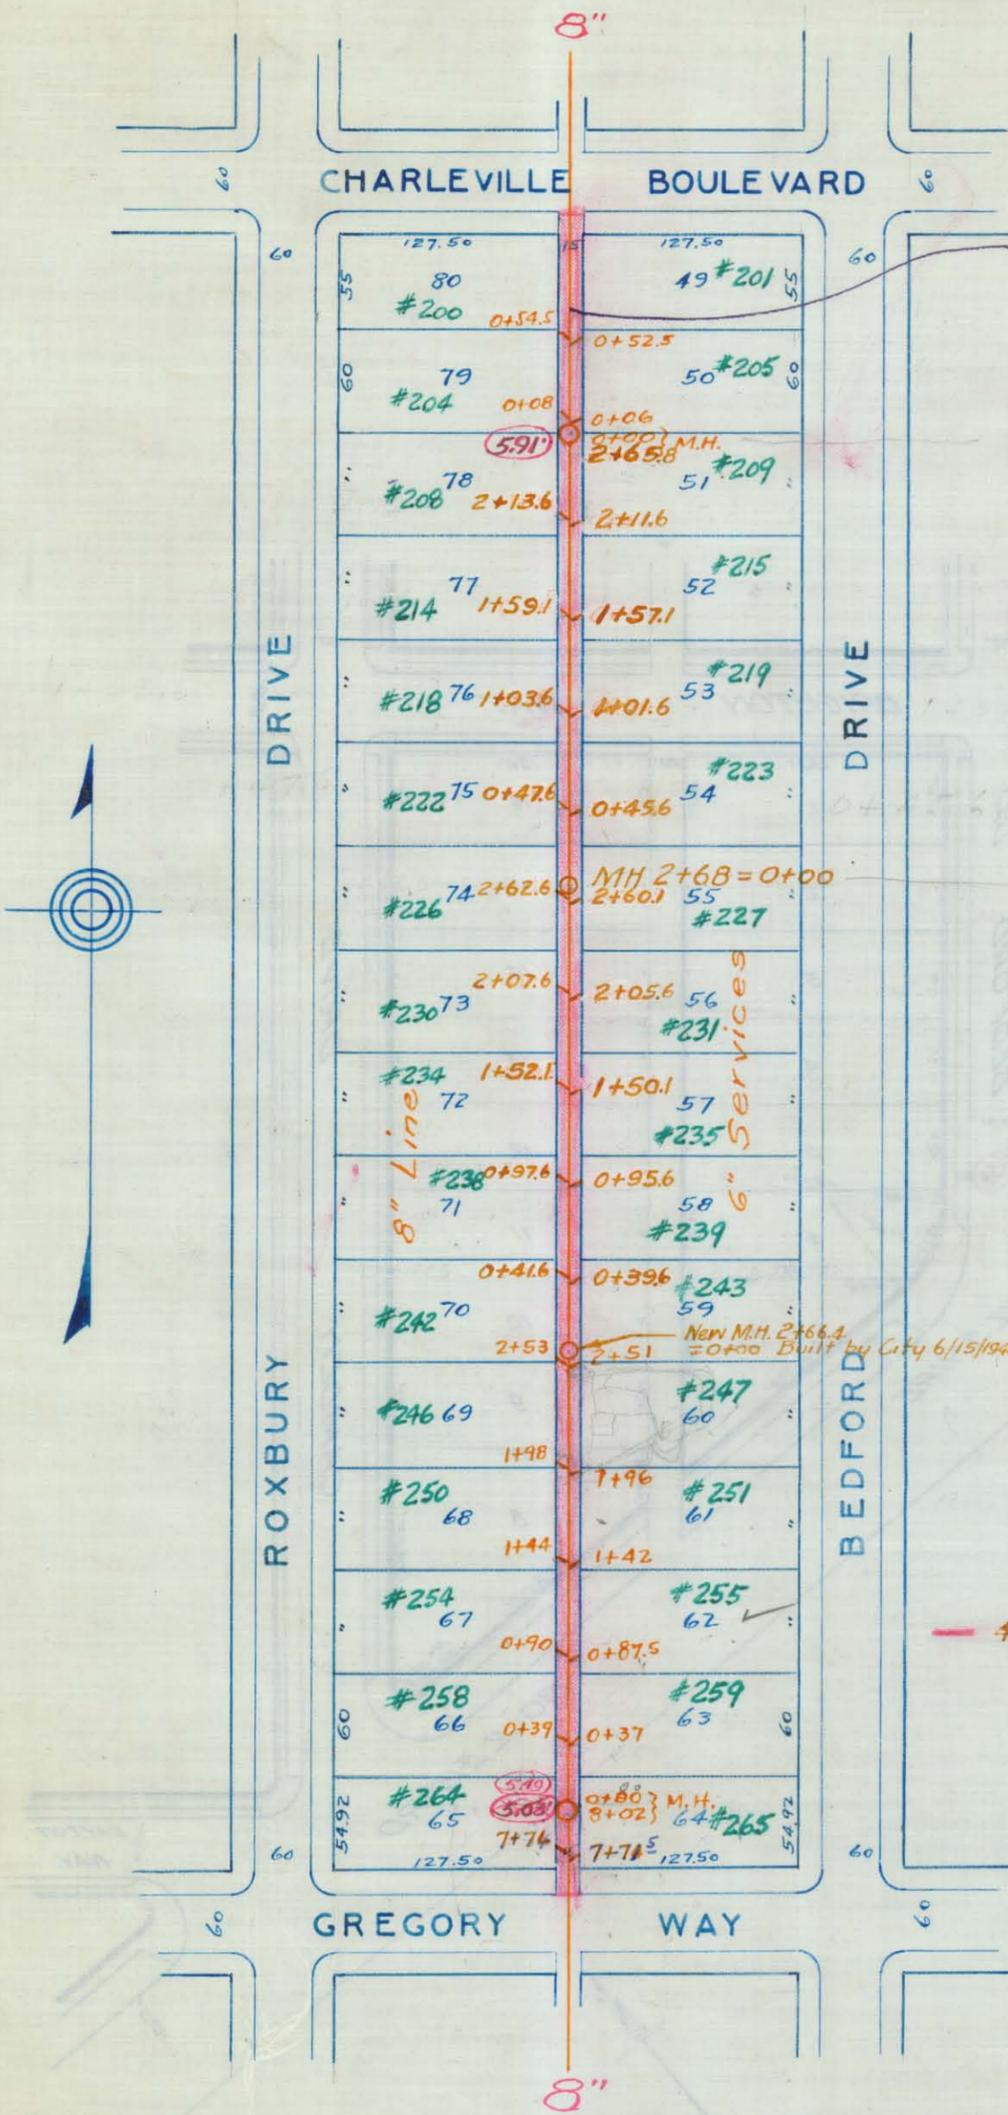

6" Saddle Installed 5-12-36  
 71' No. of M.H.  
 Permit #1454 B.M.


Correct  
 2+62

Correct  
 2+72

— 4" A.C. Pavement June 1941

CITY OF BEVERLY HILLS

TRACT 8982 (Formerly 7710)  
 M.B. 117-99  
 SCALE: 1" = 100'

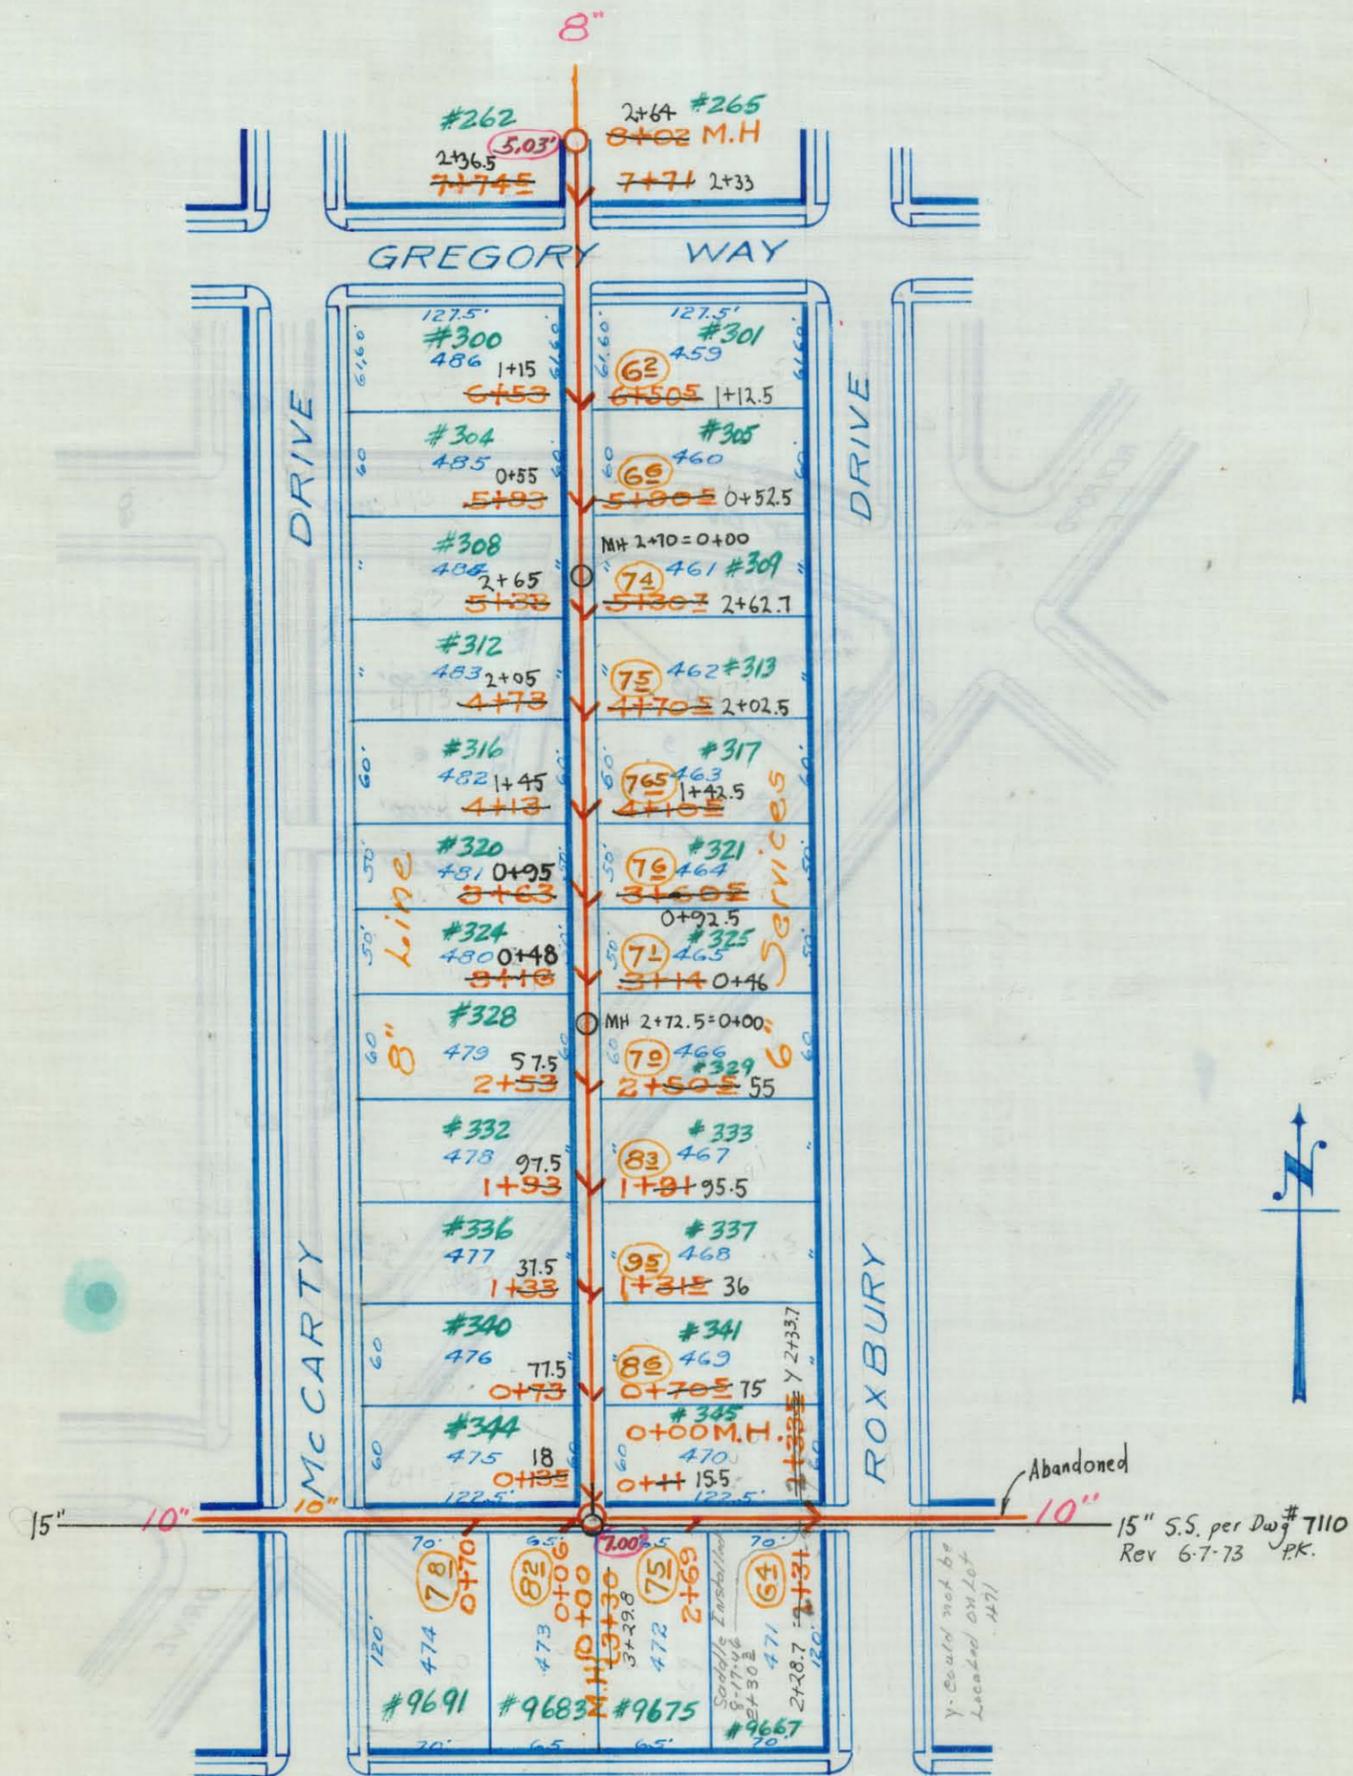


# TRACT 7710.

M. B. 93 P. 94-95.

CITY OF BEVERLY HILLS.

Scale, 1 inch = 100 ft.

85

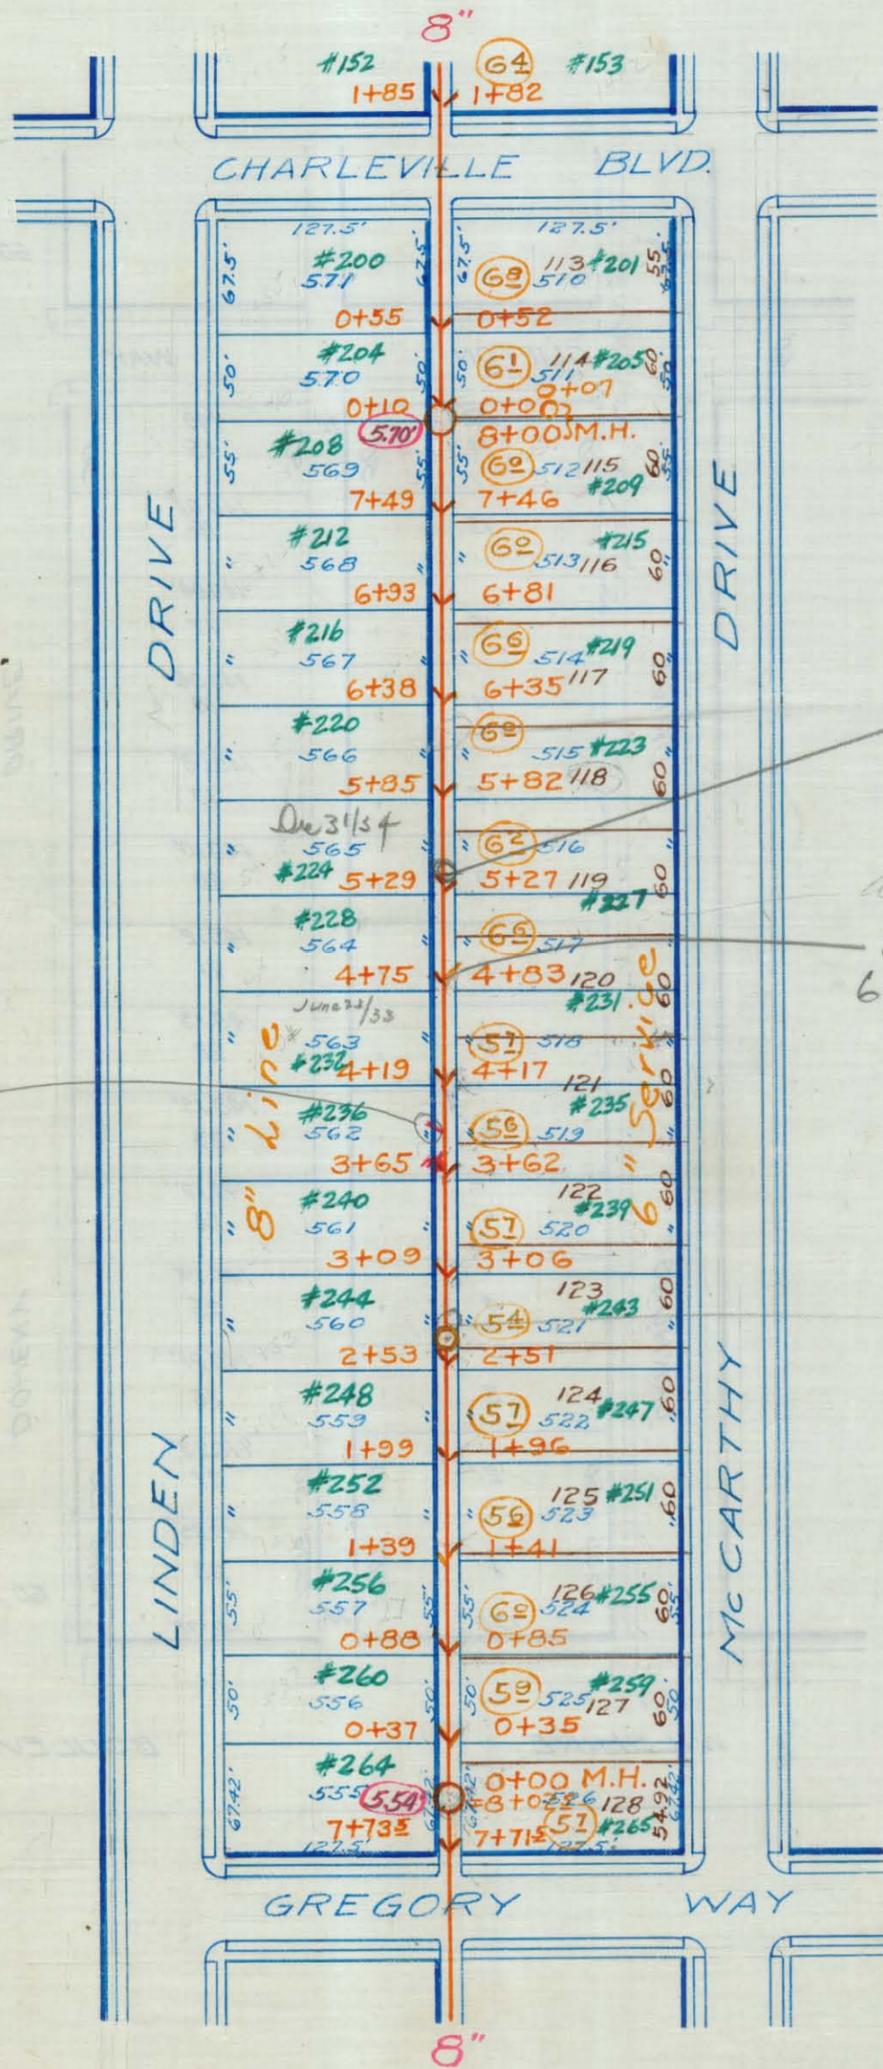

1+37 N/O  
SOUTHERLY M/H  
INSTALL NEW WYE  
6-11-2001

2+65<sup>2</sup> M.H.  
(5+33.7-MH)

allow Saddle  
L" Saddle Installed.  
6-13-35 483' N of M.H.  
Permit # 907  
B.M.

2+68<sup>5</sup> M/H




**TRACT 7710**  
M.B. 93 P. 94-95  
CITY OF BEVERLY HILLS.  
Scale 1 inch = 100 ft.

8902

Lot Nos  
570  
510

86

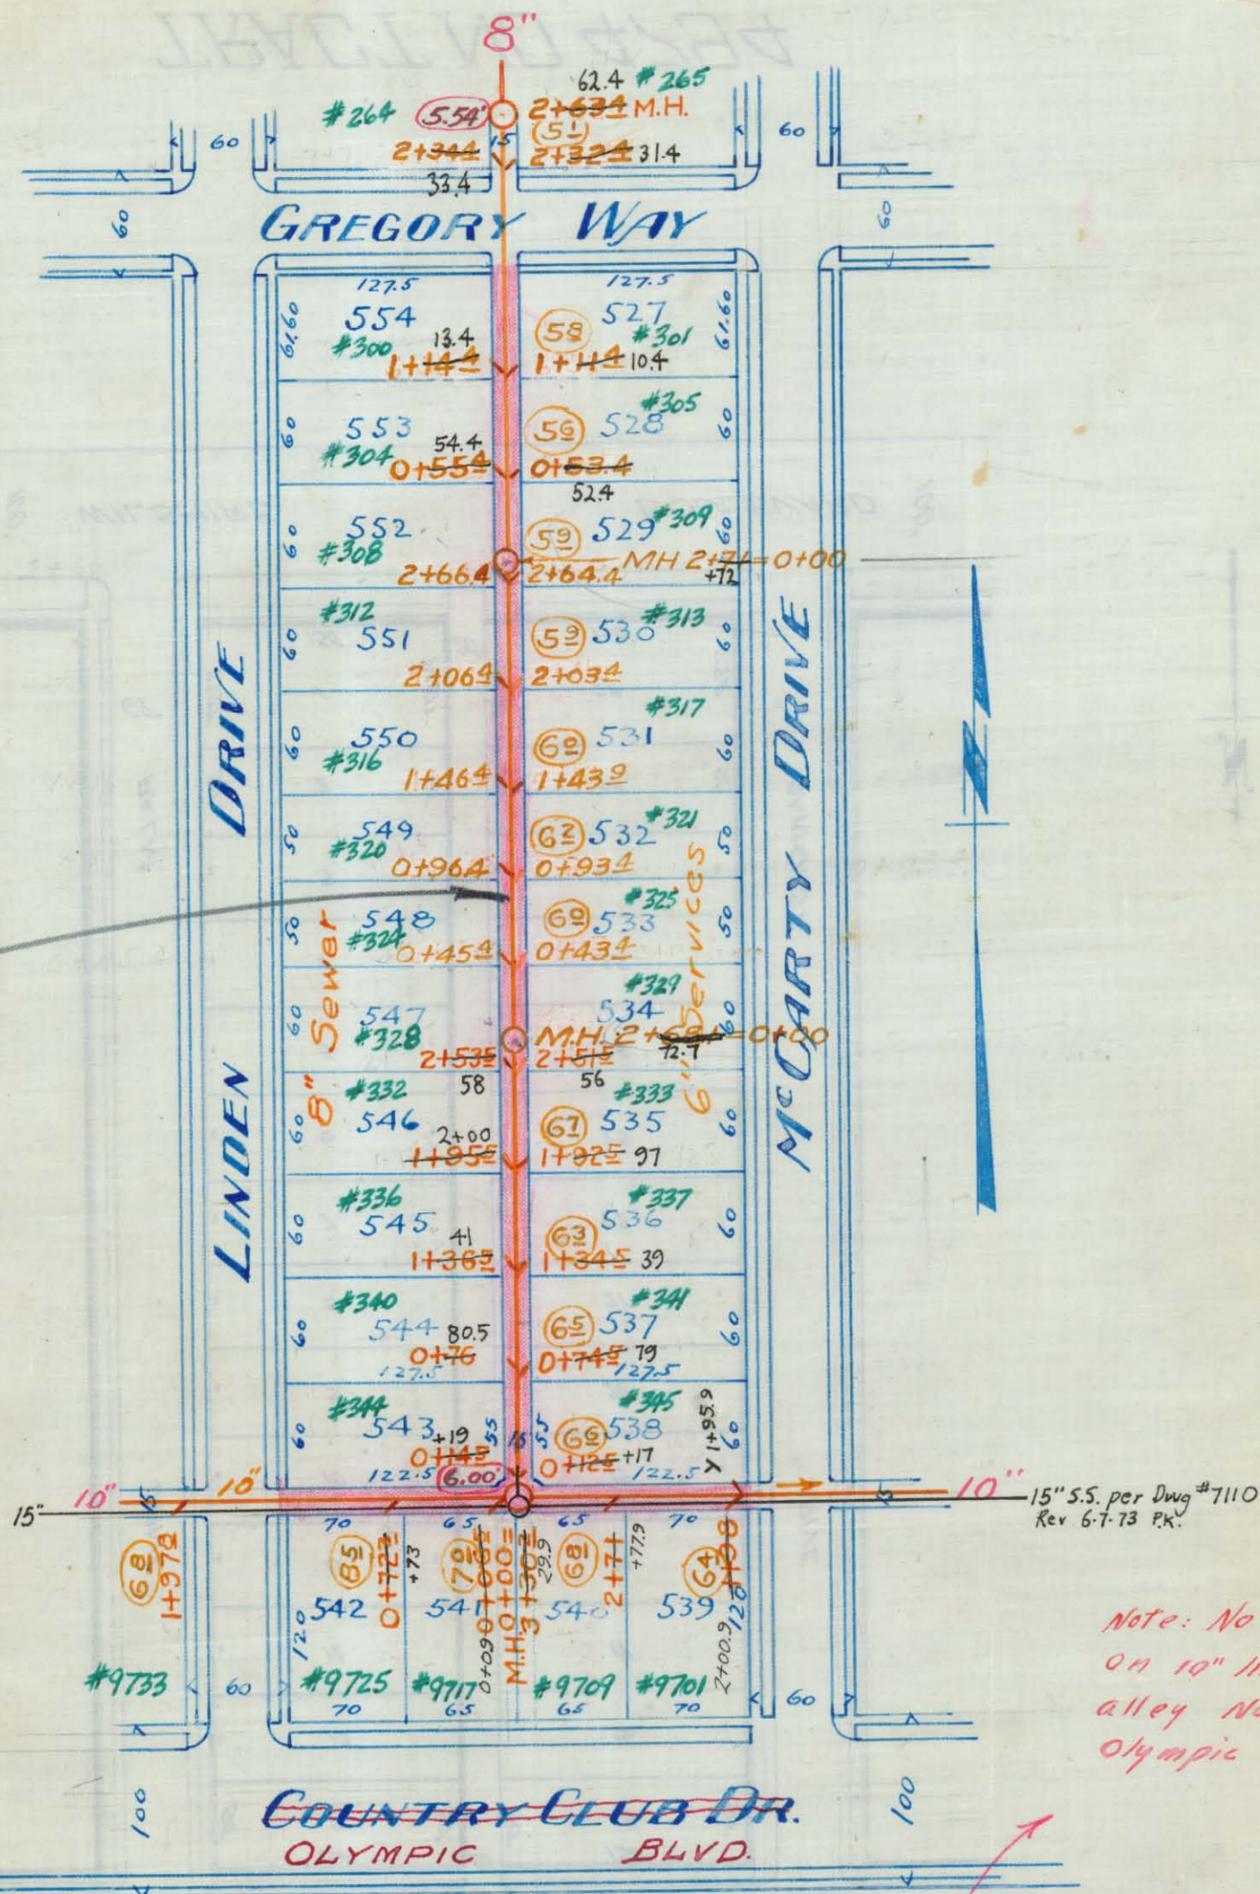

See Dwg.  
No. 7194.1

Note: No Saddles  
on 10" line in  
alley north of  
Olympic


4" A.C. Pavement June 1941 - Stationing Corrected 7/12/41 L.V.M.

FOR LATERAL TO ROXBURY PARK  
SEE DRWG. 2055  
(Per Bill Moorman 4/9/85)

LOTS 527 to 554

**TRACT 7710.**  
M.B. 93 P. 94-95.  
CITY OF BEVERLY HILLS.  
Scale, 1 inch = 100 ft.

87

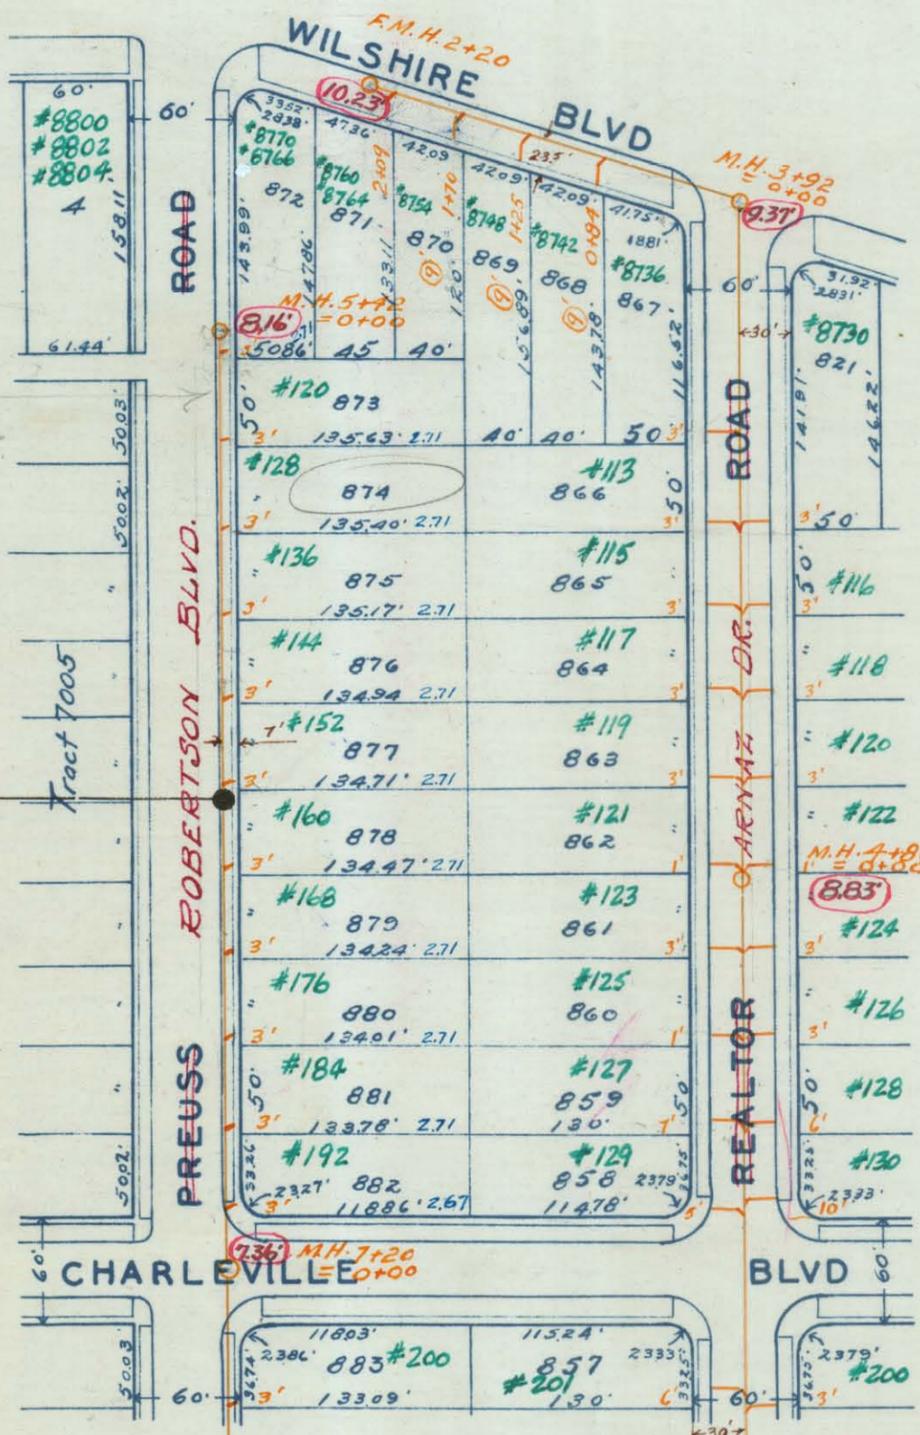

Sewer 4' W of  
Curb Line on  
Robertson Blvd E.  
side

2+71.00 M.H.  
CONSTD. 1968


Unless otherwise specified all services  
brought to the back of curb are 5' +/- Deep  
Distances in blue are to be used  
when others fail.

Pave: Robertson - 7 1/2" Concrete.  
Arroyo - 3" A.C. + 2" Warrantite

**CITY OF BEVERLY HILLS**  
TRACT 4988 *Lots 857 to 883*  
M.B. 54-98-99  
SCALE 1"=100'

88

Date 10/25

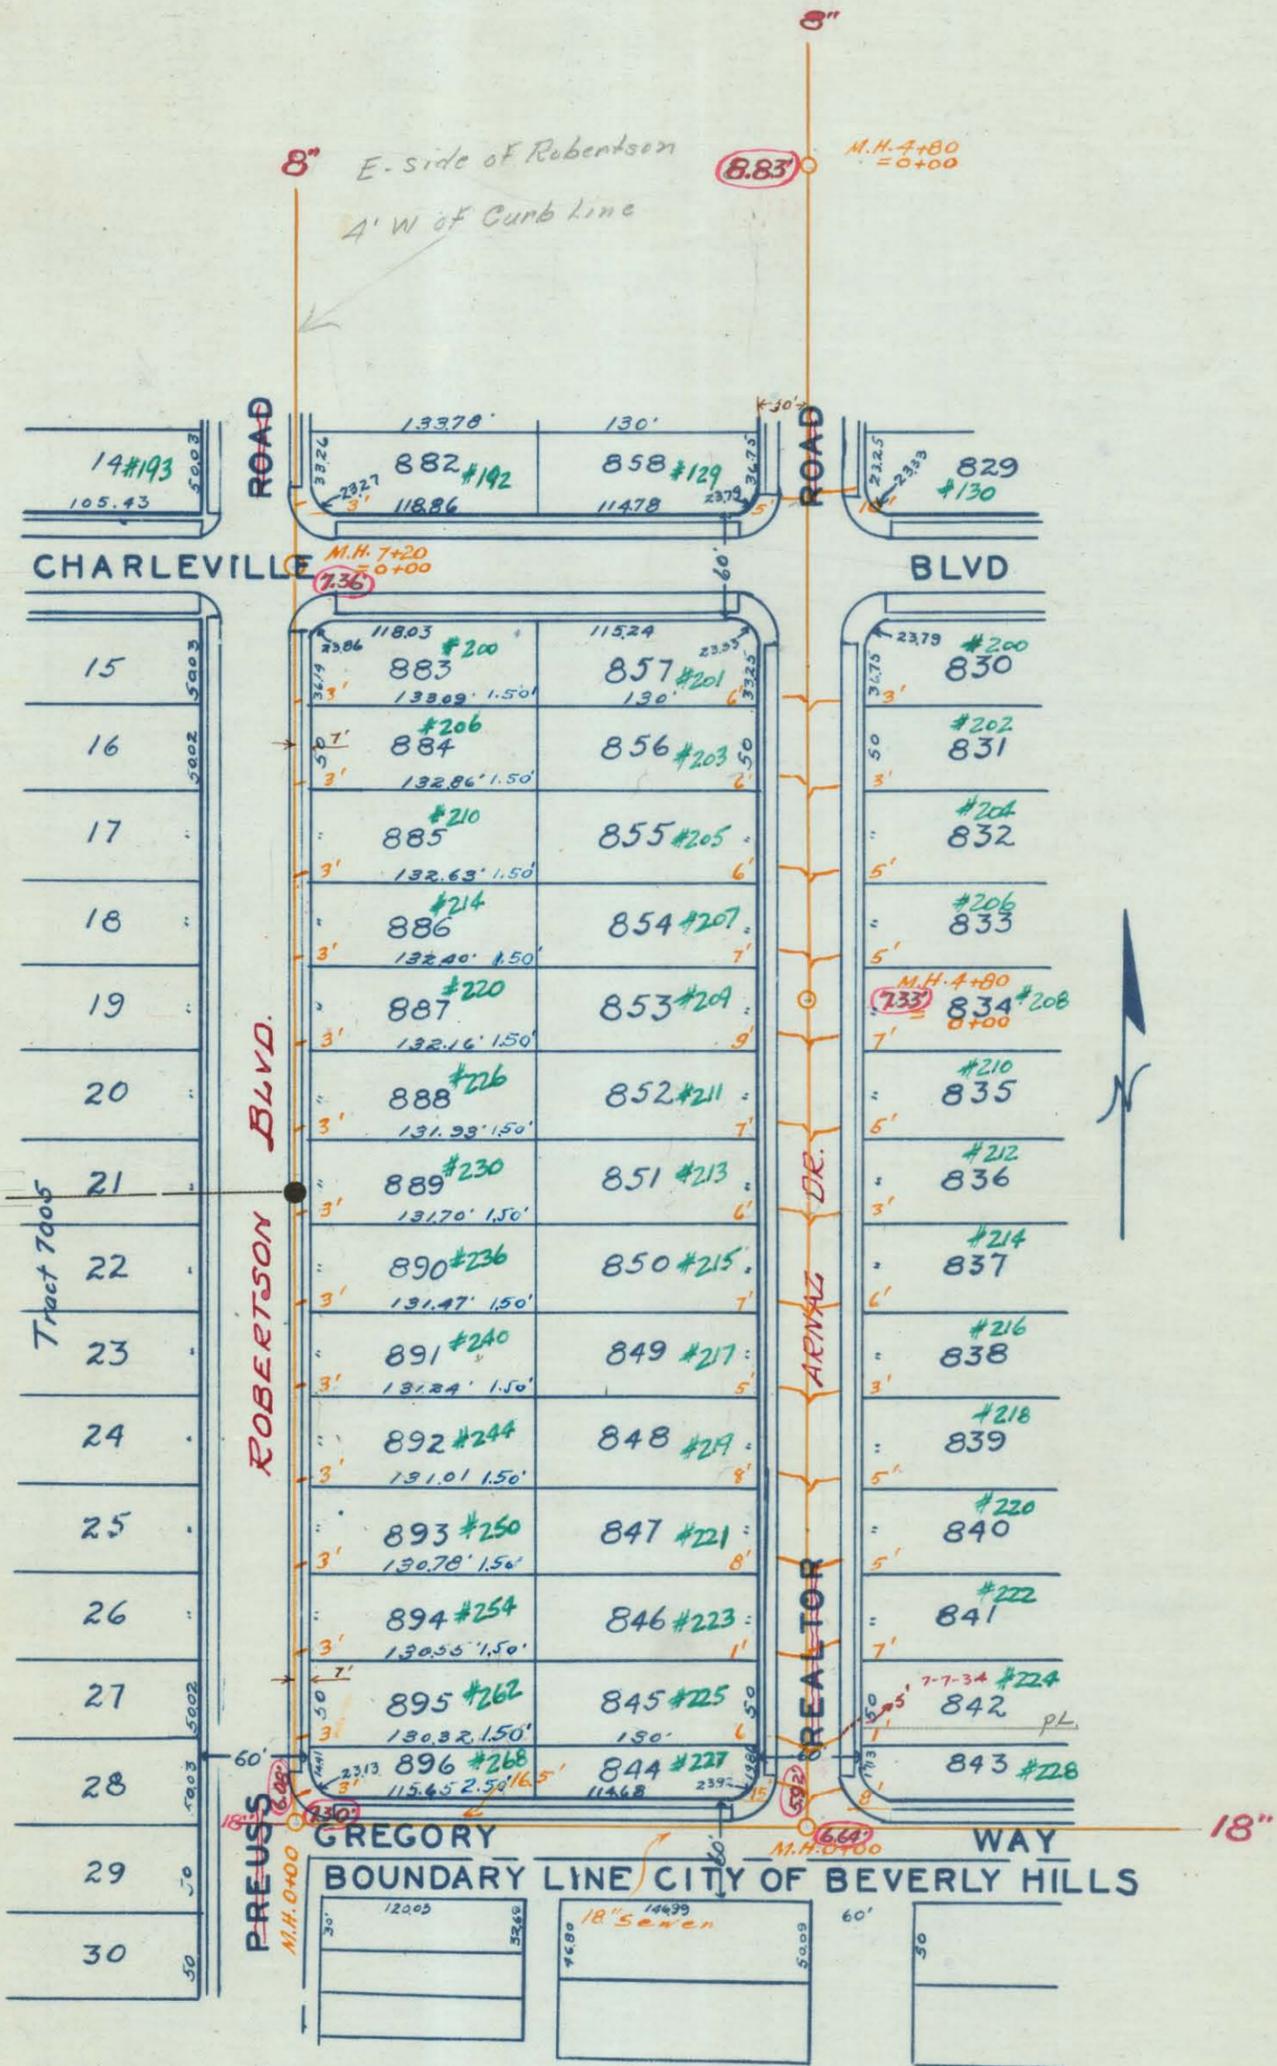

3+63.00 M.H.  
CONSTD. 1968

Unless otherwise specified all services that are brought to the back of curb are 5' below top of curb. Distances in blue to be used when others fail. Submitted by Taylor in Oct. 1931.

Pave: Robertson - 1 1/2" Concrete  
Arnoz 3" A.C. + 2" Warrenite

8" Sewer

# CITY OF BEVERLY HILLS

TRAC T 4988 Lots 844 to 858


M.B. 54-98-99 " 882 " 896

SCALE 1" = 100'

89

Date 1925



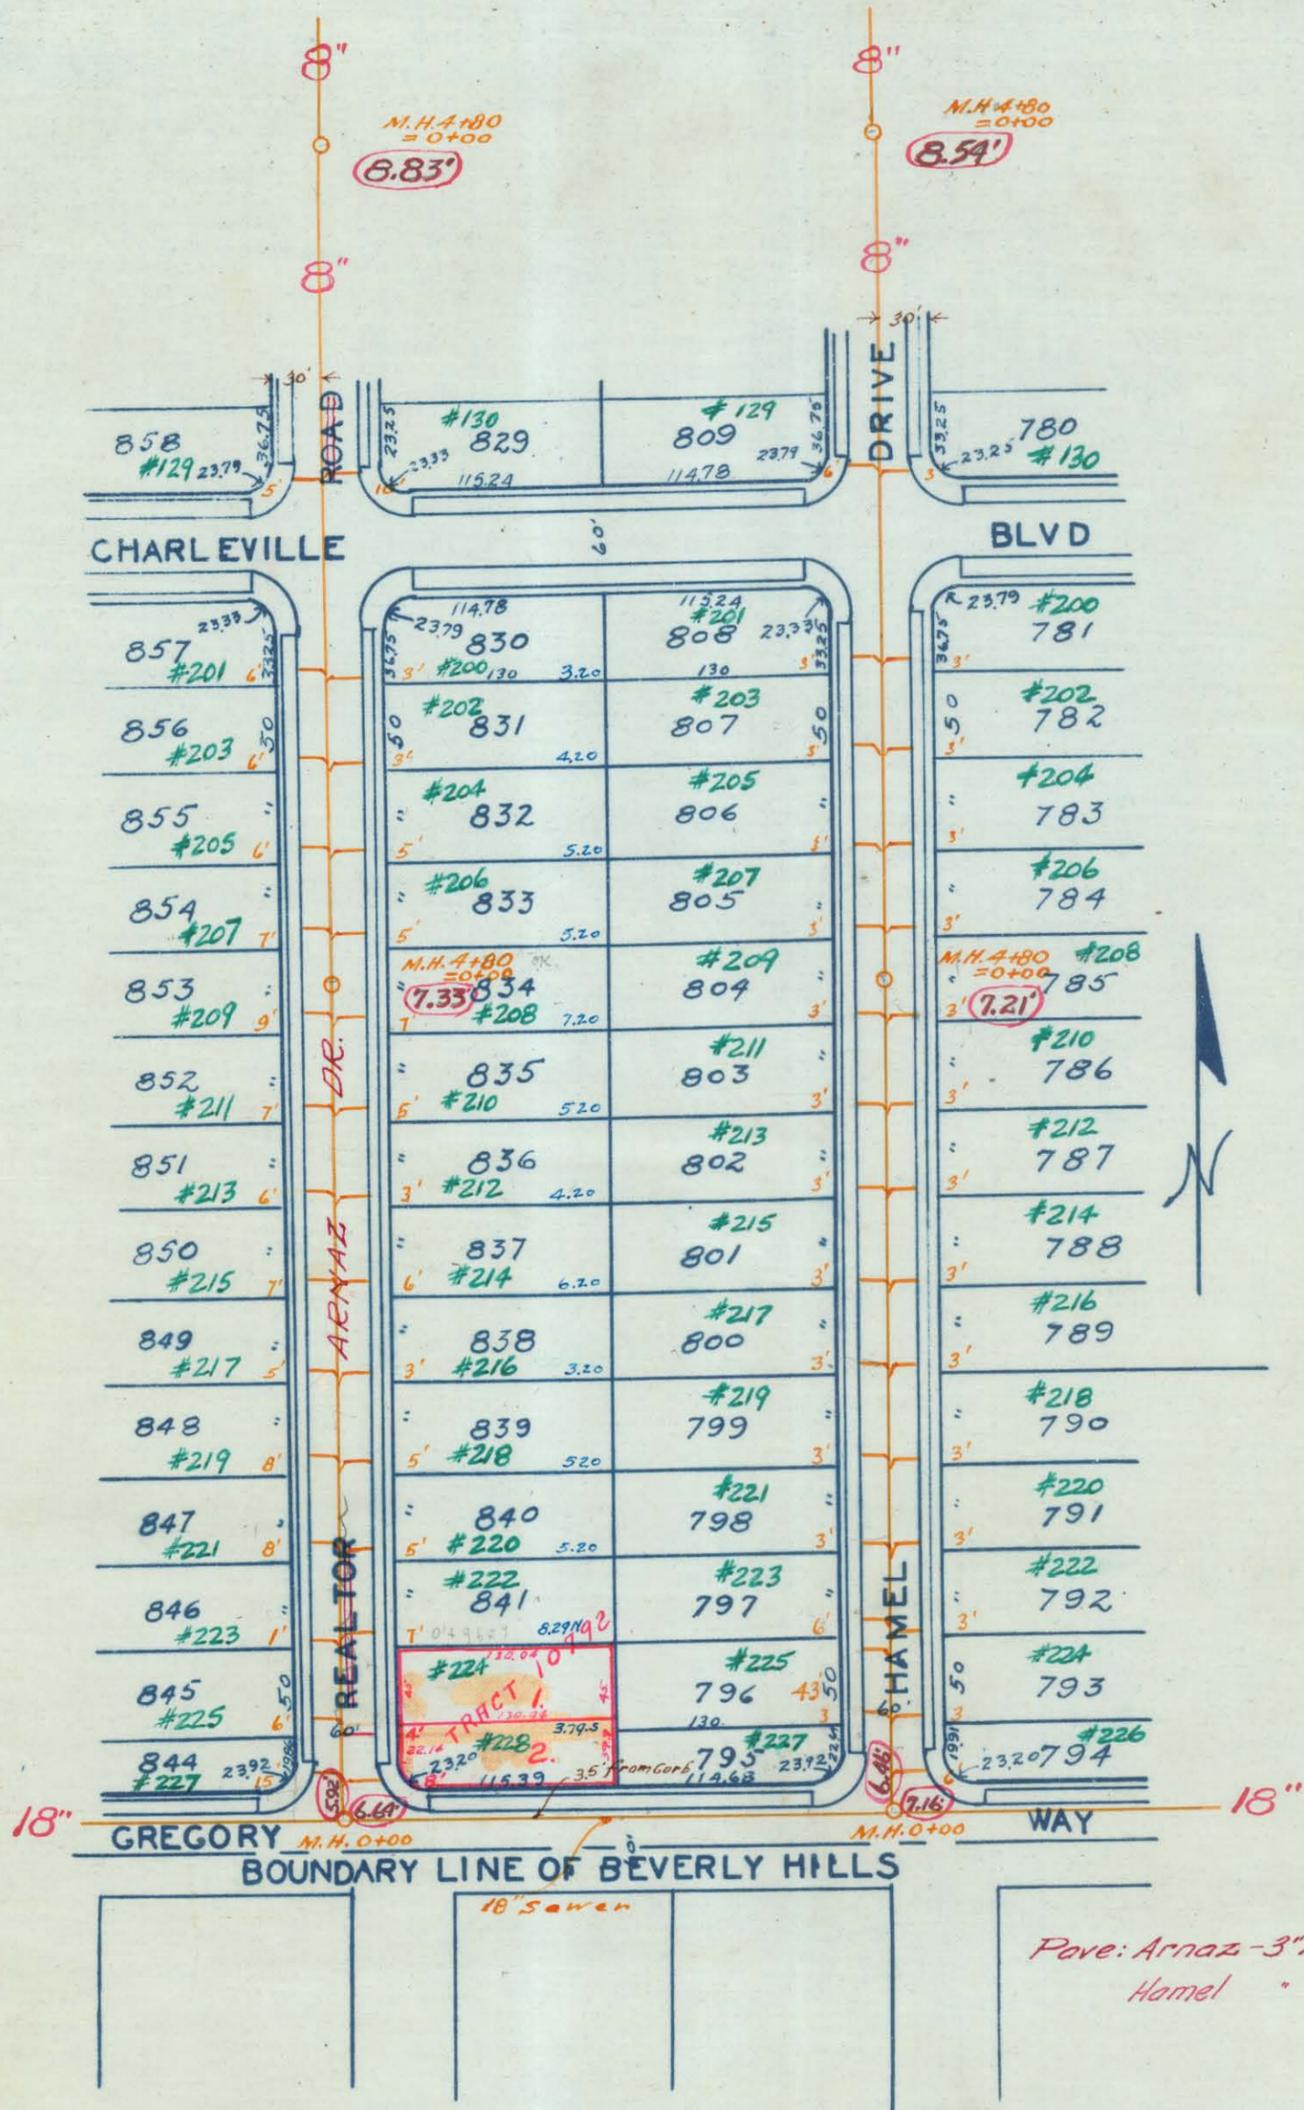


# CITY OF BEVERLY HILLS

TRACT 4988 Lots 795 to 809  
 M.B. 54-98-99 " 829 " 843  
 SCALE 1/2" = 100'

Unless otherwise specified all services that are brought to the back of curb are 5' below the top of curb.  
 Figures in blue were submitted by Taylor in Oct 1931 and are to be used when other distances fail

91

date 1925

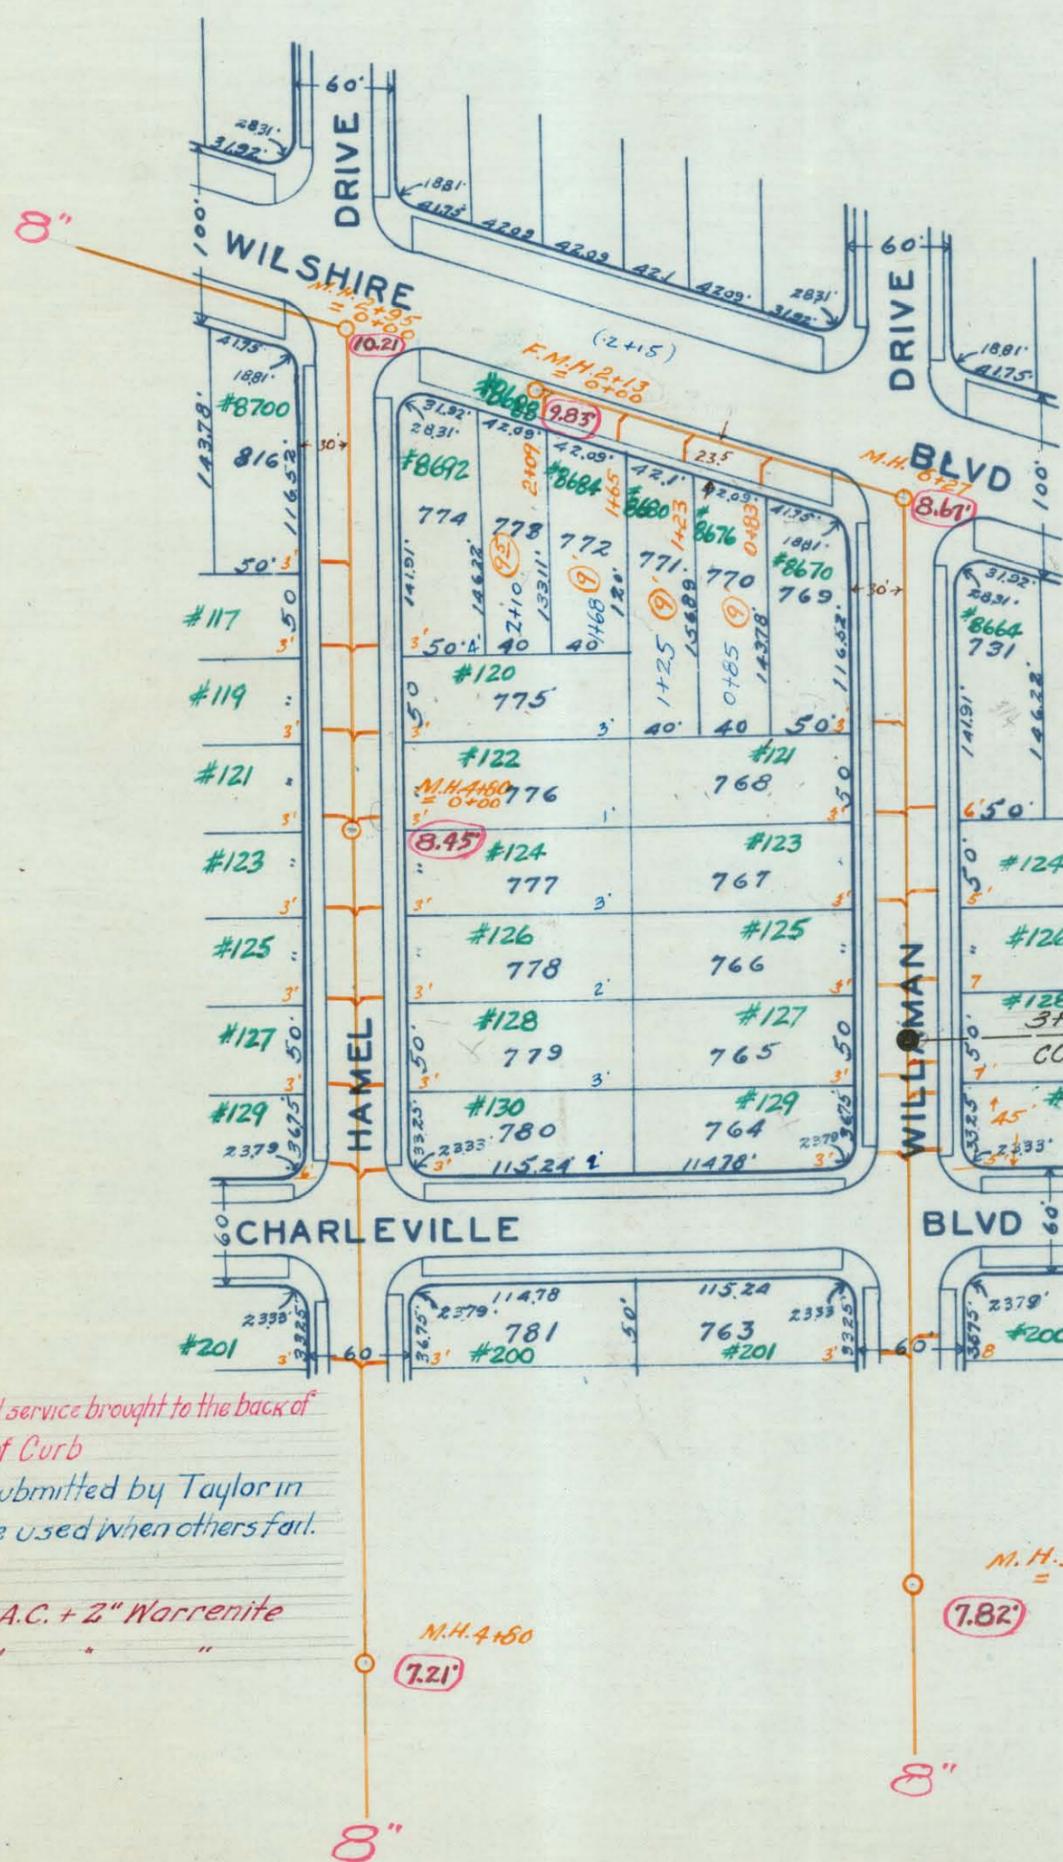

See Dwg. No. 7184

*Unless otherwise specified all service brought to the back of curb are 5' below the top of Curb*  
*Figures in blue were submitted by Taylor in Oct 1931 and are to be used when others fail.*


*Pave: Hamel - 3" A.C. + 2" Warrenite*  
*Willaman " " "*

**CITY OF BEVERLY HILLS**  
 TRACT 4988 *Lots 763 to 781*  
 M.B. 54-98-99  
 SCALE 1"=100'

8" sewer

92

date 1925

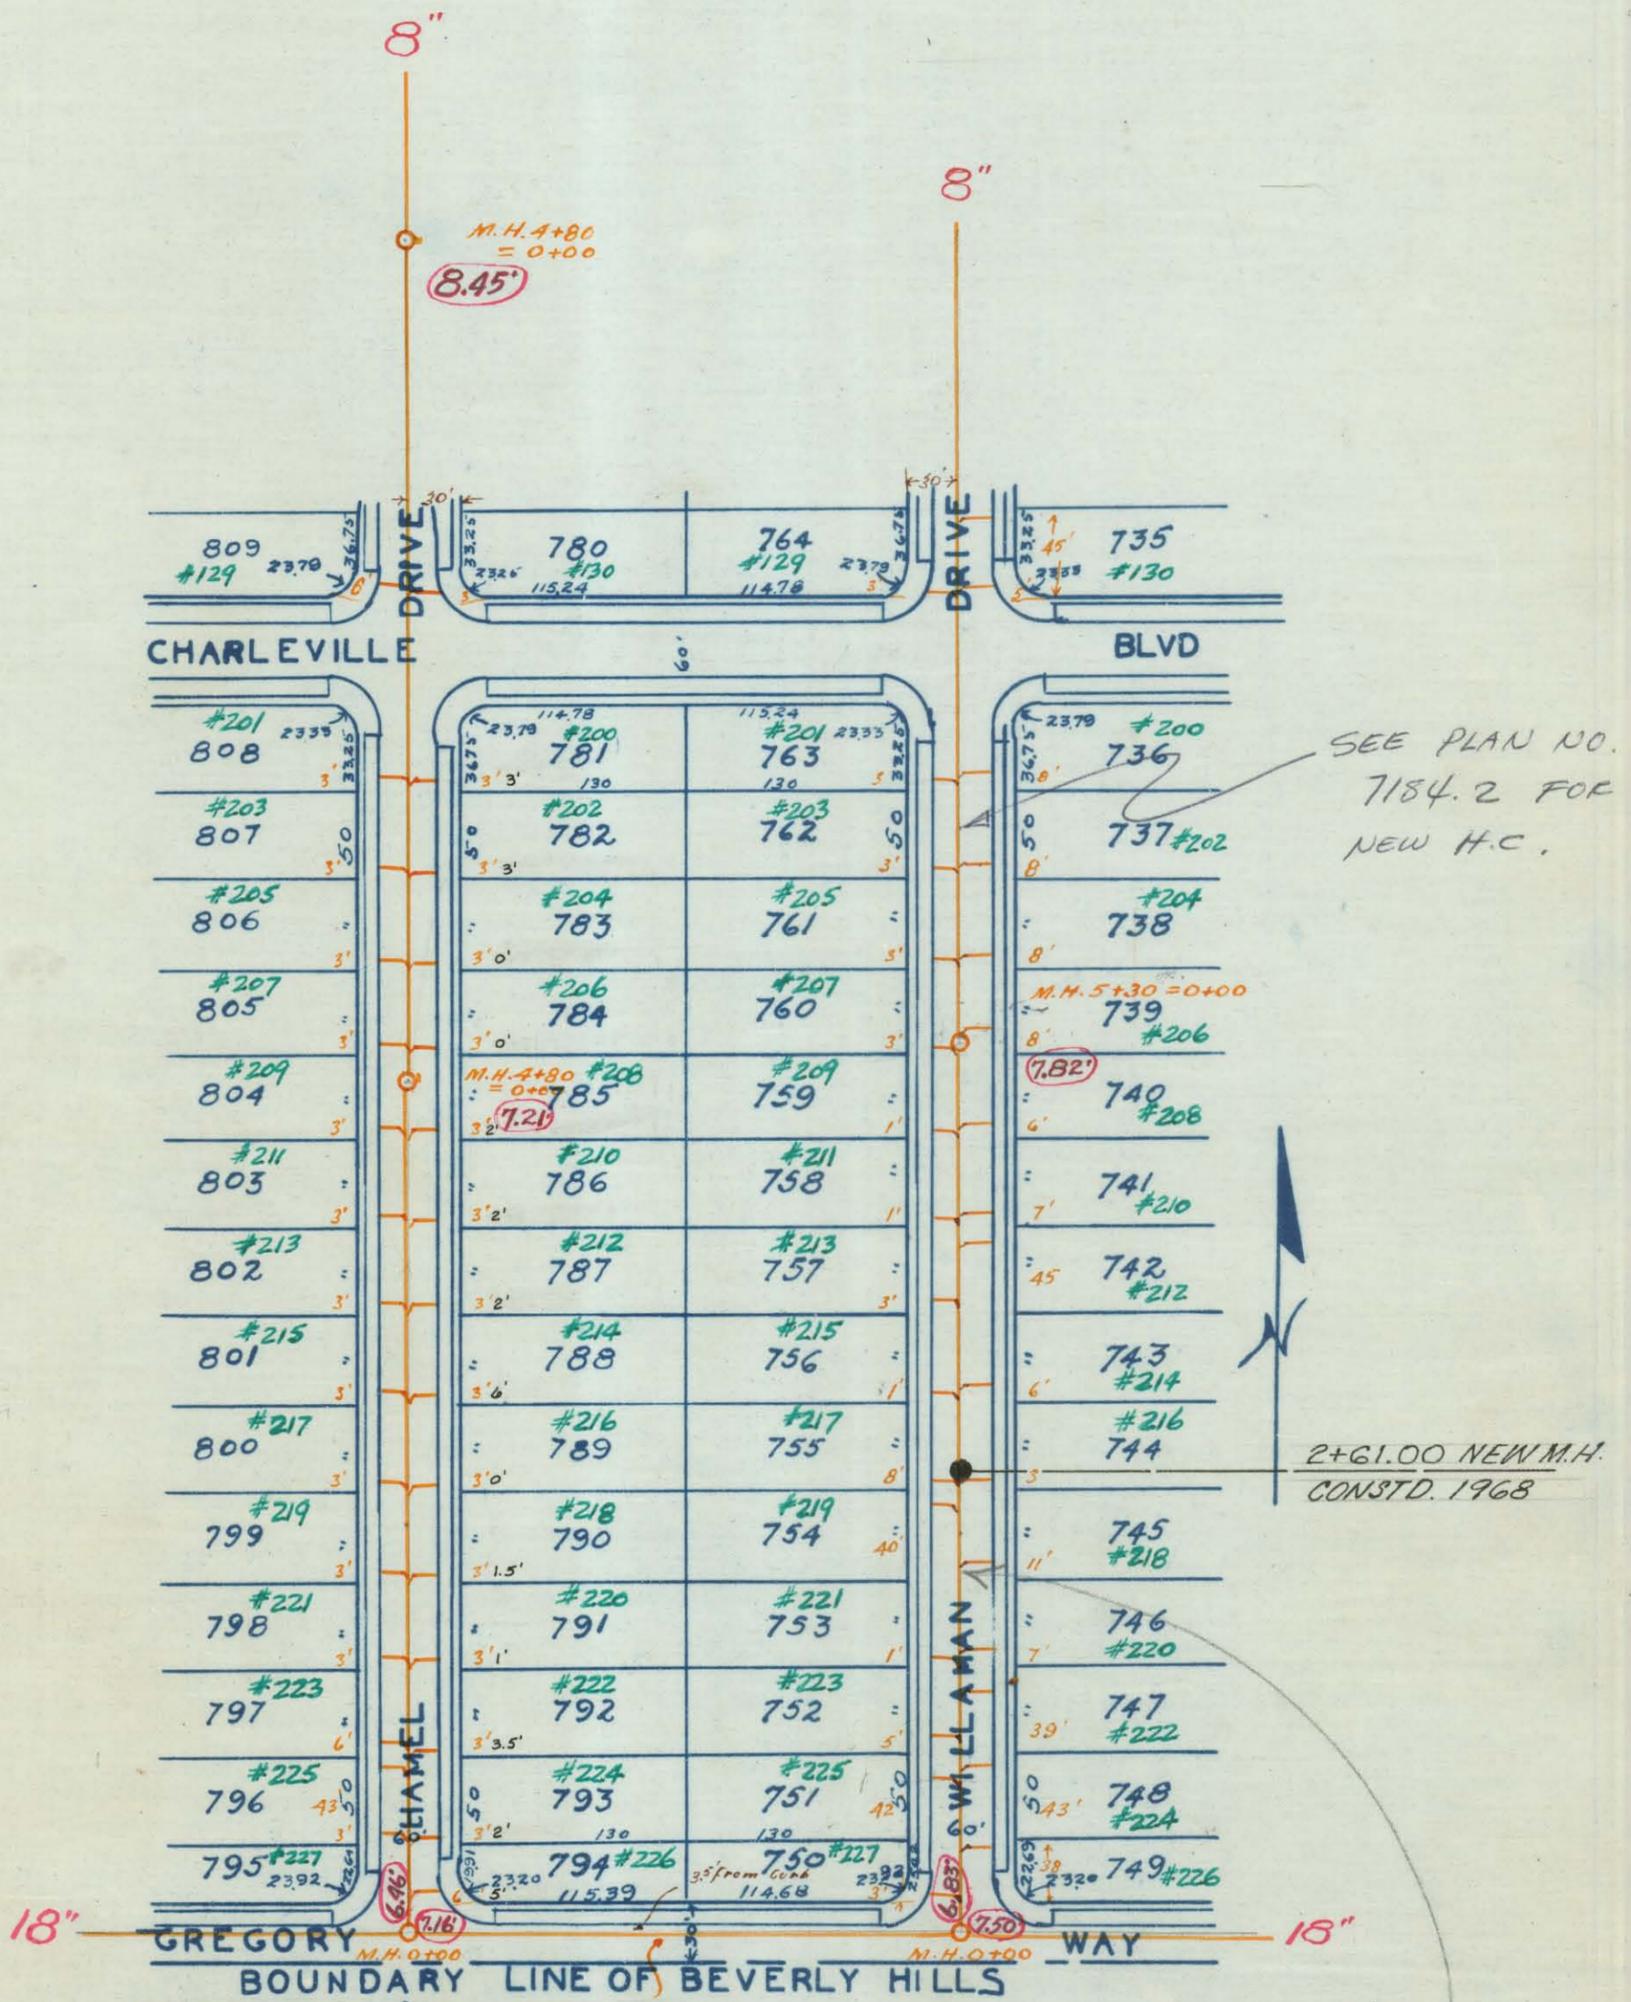

SEE PLAN NO. 7184.2 FOR NEW H.C.

2+61.00 NEW M.H. CONSTD. 1968


Unless otherwise specified all services <sup>that</sup> are brought to back of curb are 5' below the top of curb.  
 Pave: Hamel - 3" A.C. + 2" Warrenite  
 Willaman " " " "

Distances shown in black ink (E. side Hamel Dr.) were measured during excavation for County Sanitation District 4 Outfall trunk sewer in May, 1966.

**CITY OF BEVERLY HILLS**  
 TRACT 4988 Lots 750 to 764  
 M.B. 54-98-99 " 780 " 794  
 SCALE 1"=100'

93

Date 1925

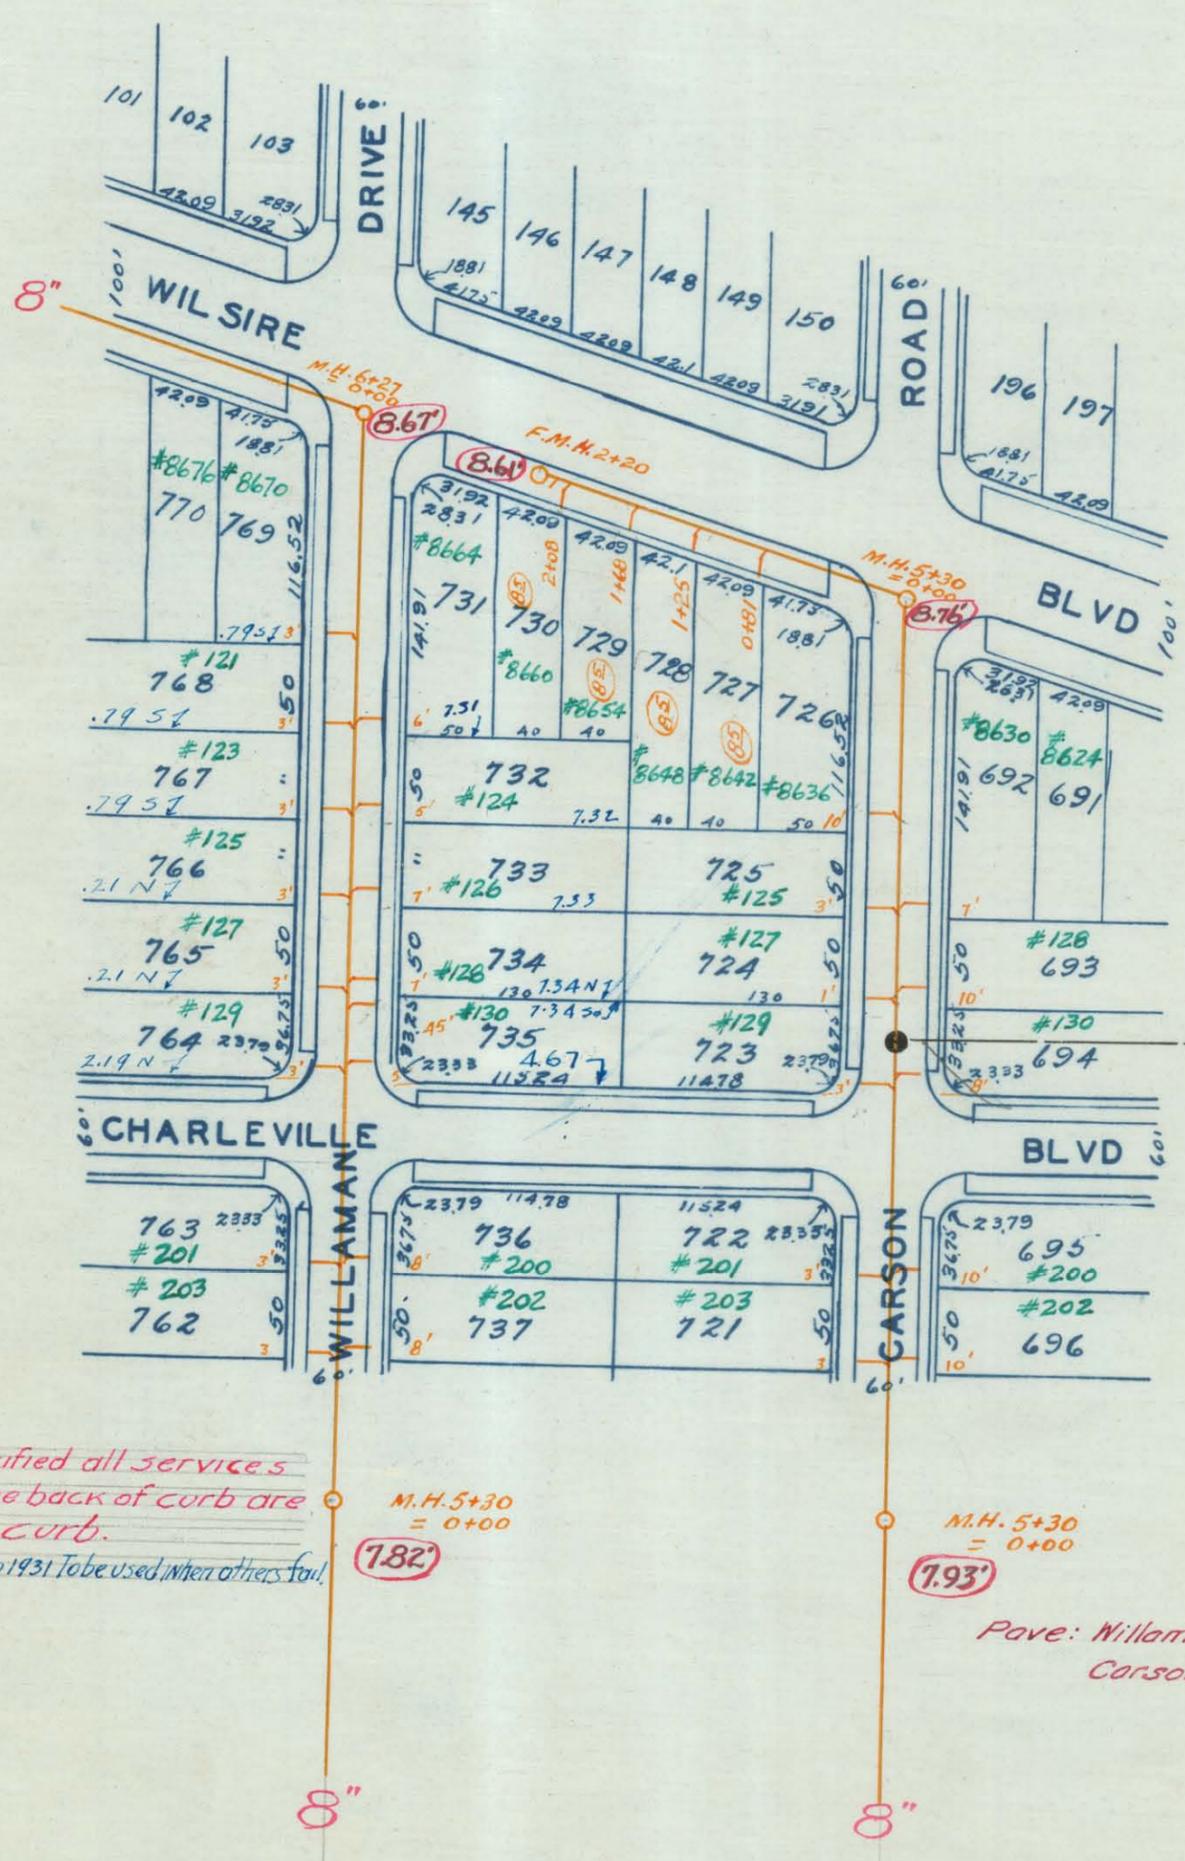

2+61.00 NEW M.H.  
CONSTD. 1968

Unless otherwise specified all services  
that are brought to the back of curb are  
5' below the top of curb.  
Blue figures submitted by Taylor in 1931 To be used when others fail.


M.H. 5+30 = 0+00  
**(782)**  
M.H. 5+30 = 0+00  
**(793)**  
Pave: Willaman - 3" AC. + 2" Warrenite  
Carson " " "

**CITY OF BEVERLY HILLS**  
TRACT 4988 *Lots 723 to 737*  
M.B. 54-98-99  
SCALE 1"=100'

8" Sewer

**94**

Date 1965

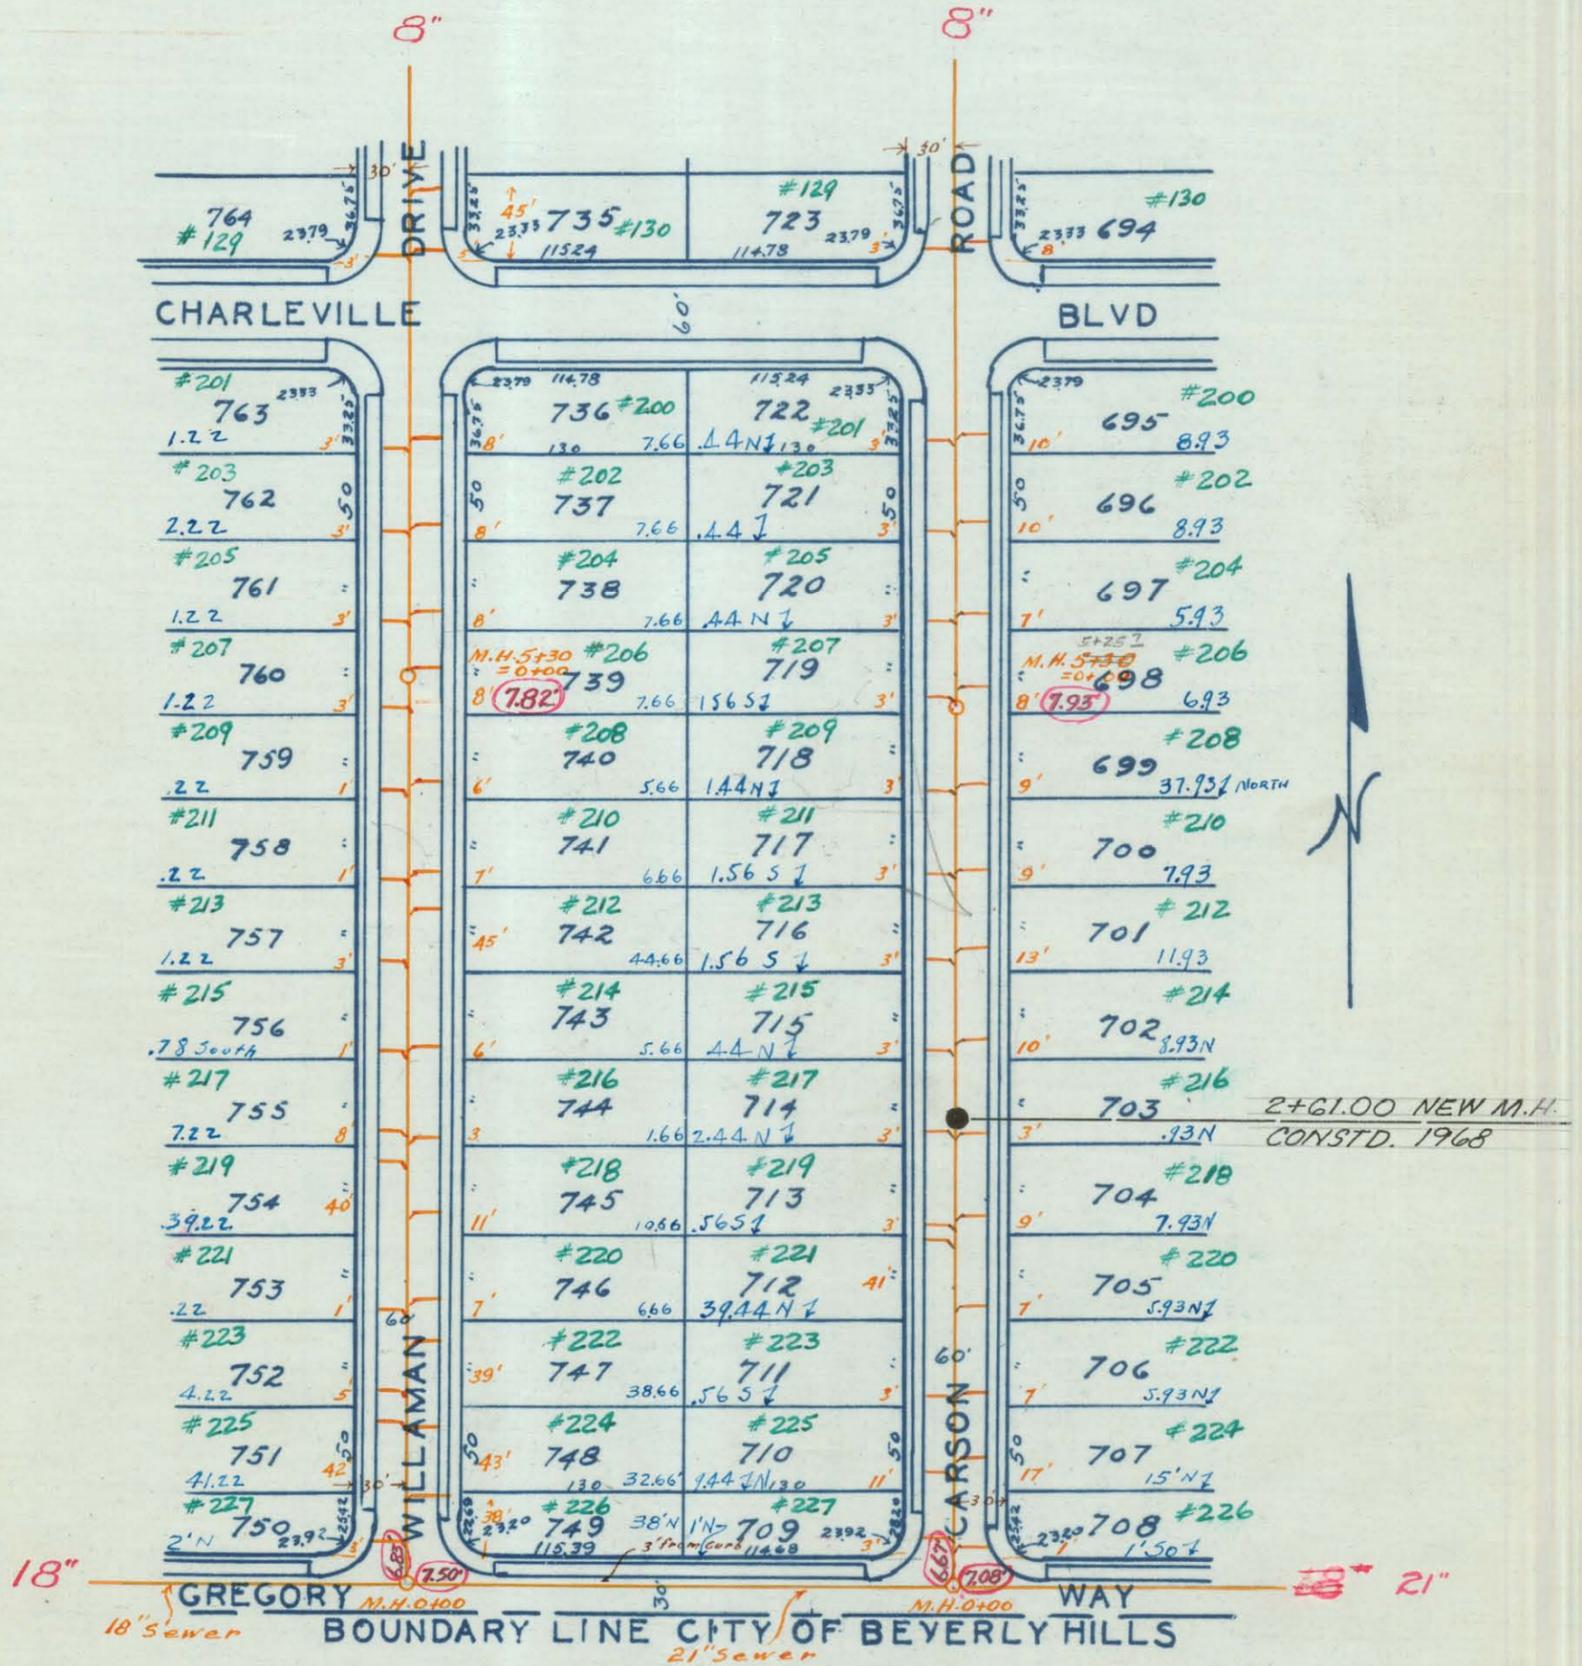

Unless otherwise specified all services that are brought to the back of curb are 5' below top of curb.  
 Blue figures were submitted by Taylor in Oct 1931 and are to be used when others fail.

Pave: Willaman - 3" A.C. + 2" Warrenite.  
 Carson - " " " "

8" Sewer

**CITY OF BEVERLY HILLS**

TRACT 4988 Lots 709 to 723


M.B. 54-98-99 " 735 " 749

SCALE 1"=100'

95

Date 1925



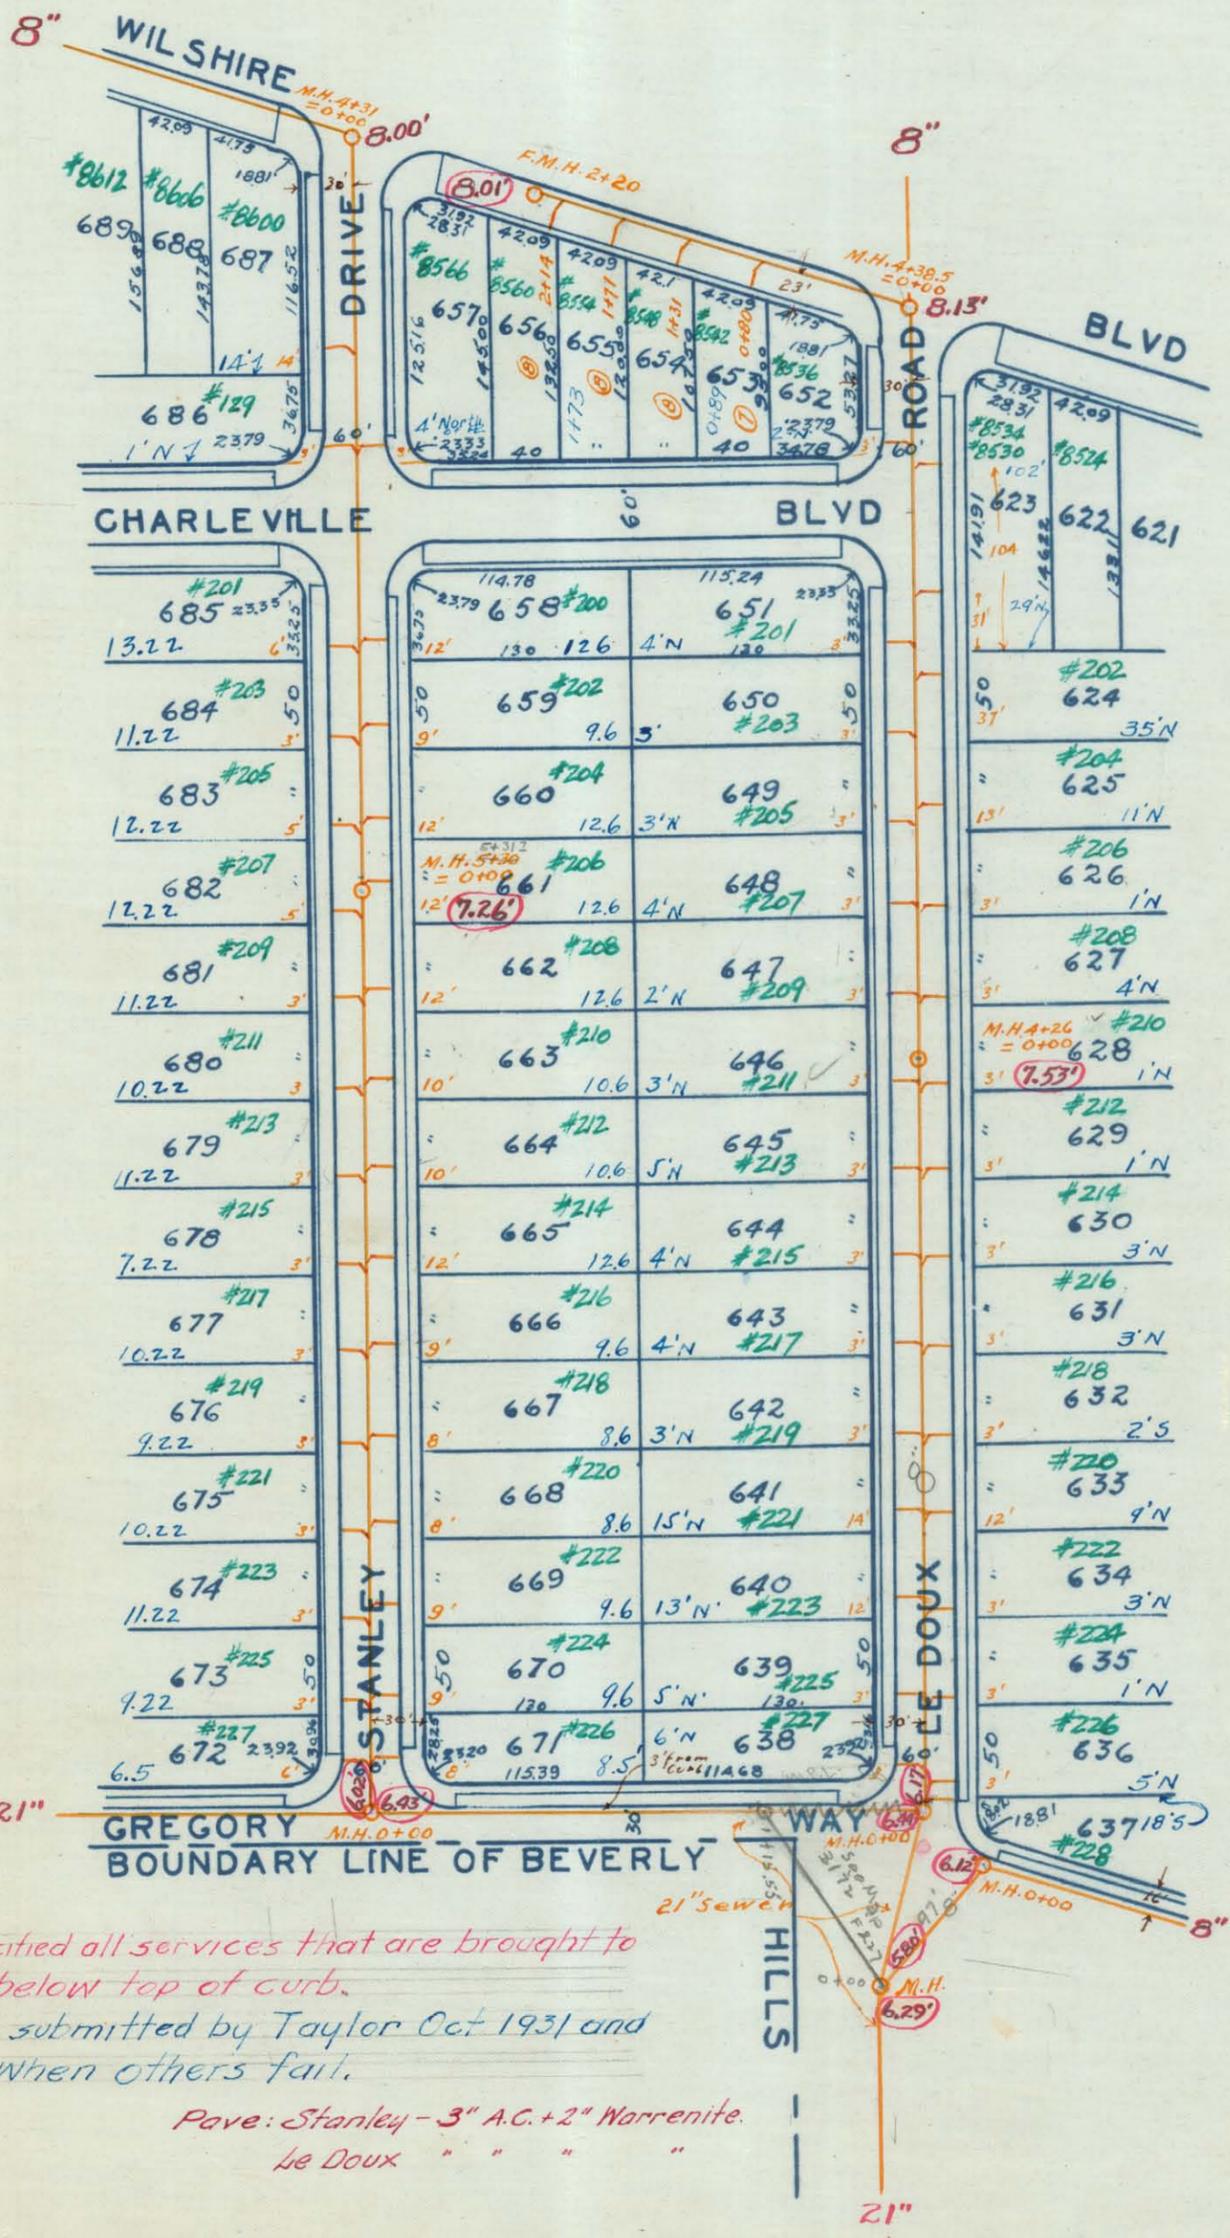


Unless otherwise specified all services that are brought to the curb are 5' below top of curb.  
 Figures in blue were submitted by Taylor Oct 1931 and are to be used when others fail.

Pave: Stanley - 3" A.C. + 2" Warrenite.  
 Le Doux " " " "

**CITY OF BEVERLY HILLS**  
 TRACT 4988 Lots 638 to 671  
 M.B.54-98-99  
 SCALE 1"=100'

97

Date 1925

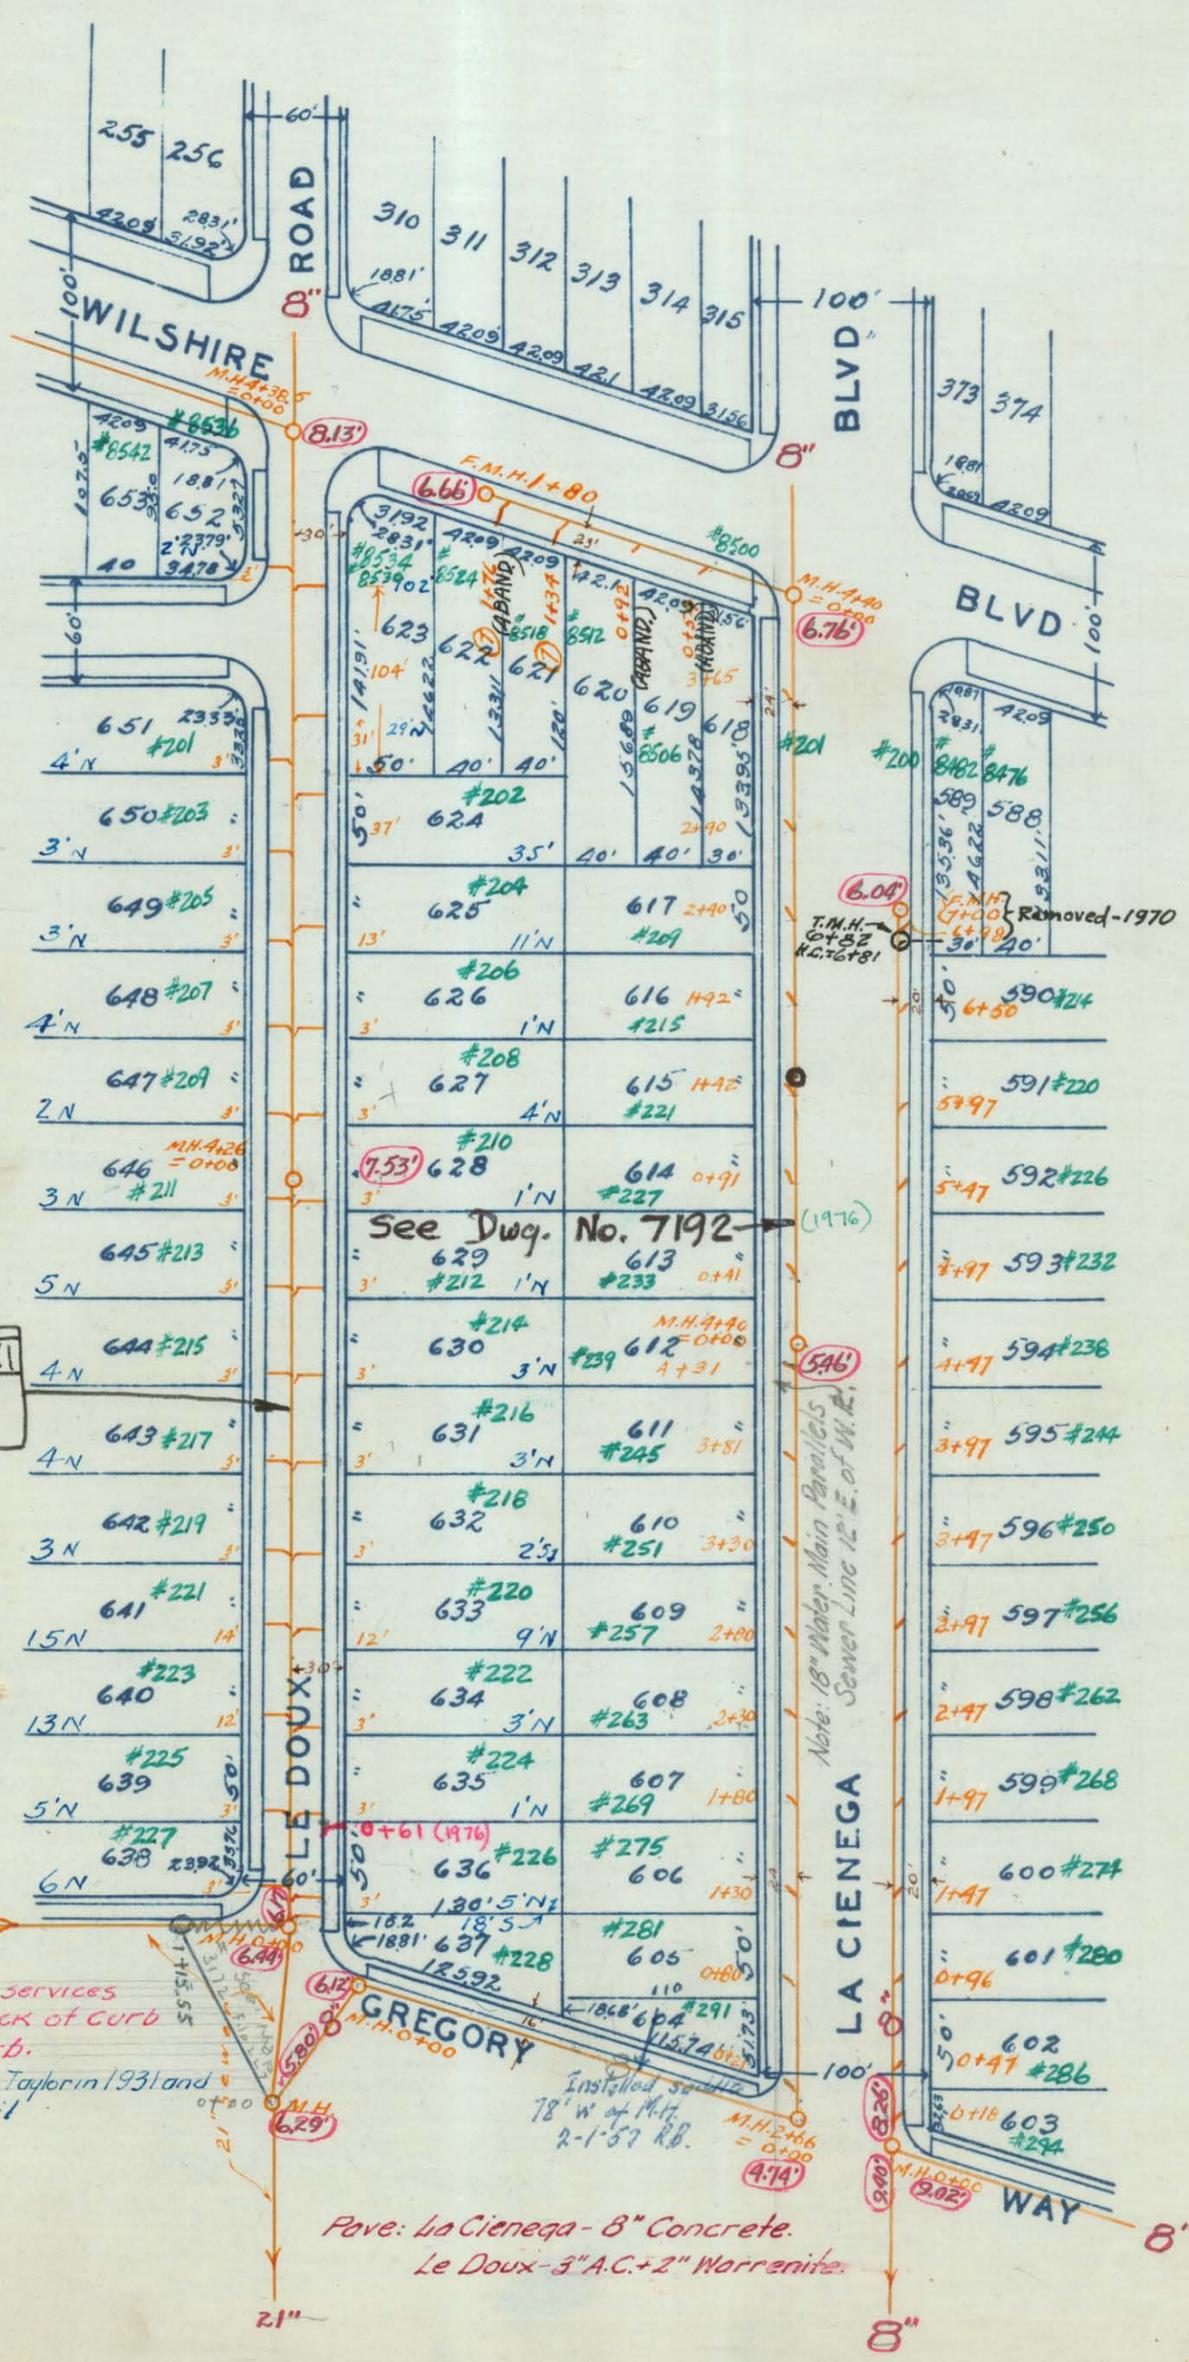

See B.H. Sewer Proj. XI  
 Dwg No. 7115, Sht. 2.


Unless otherwise specified, all services that are brought to the back of curb are 5' below top of curb.  
 Figures in blue were submitted by Taylor in 1931 and are to be used when others fail.

Pave: La Cienega - 8" Concrete.  
 Le Doux - 3" A.C. + 2" Warrenite.

**CITY OF BEVERLY HILLS**  
 TRACT 4988 Lots 604 to 637  
 M.B. 54-98-99  
 SCALE 1" = 100'

98

Date 1925

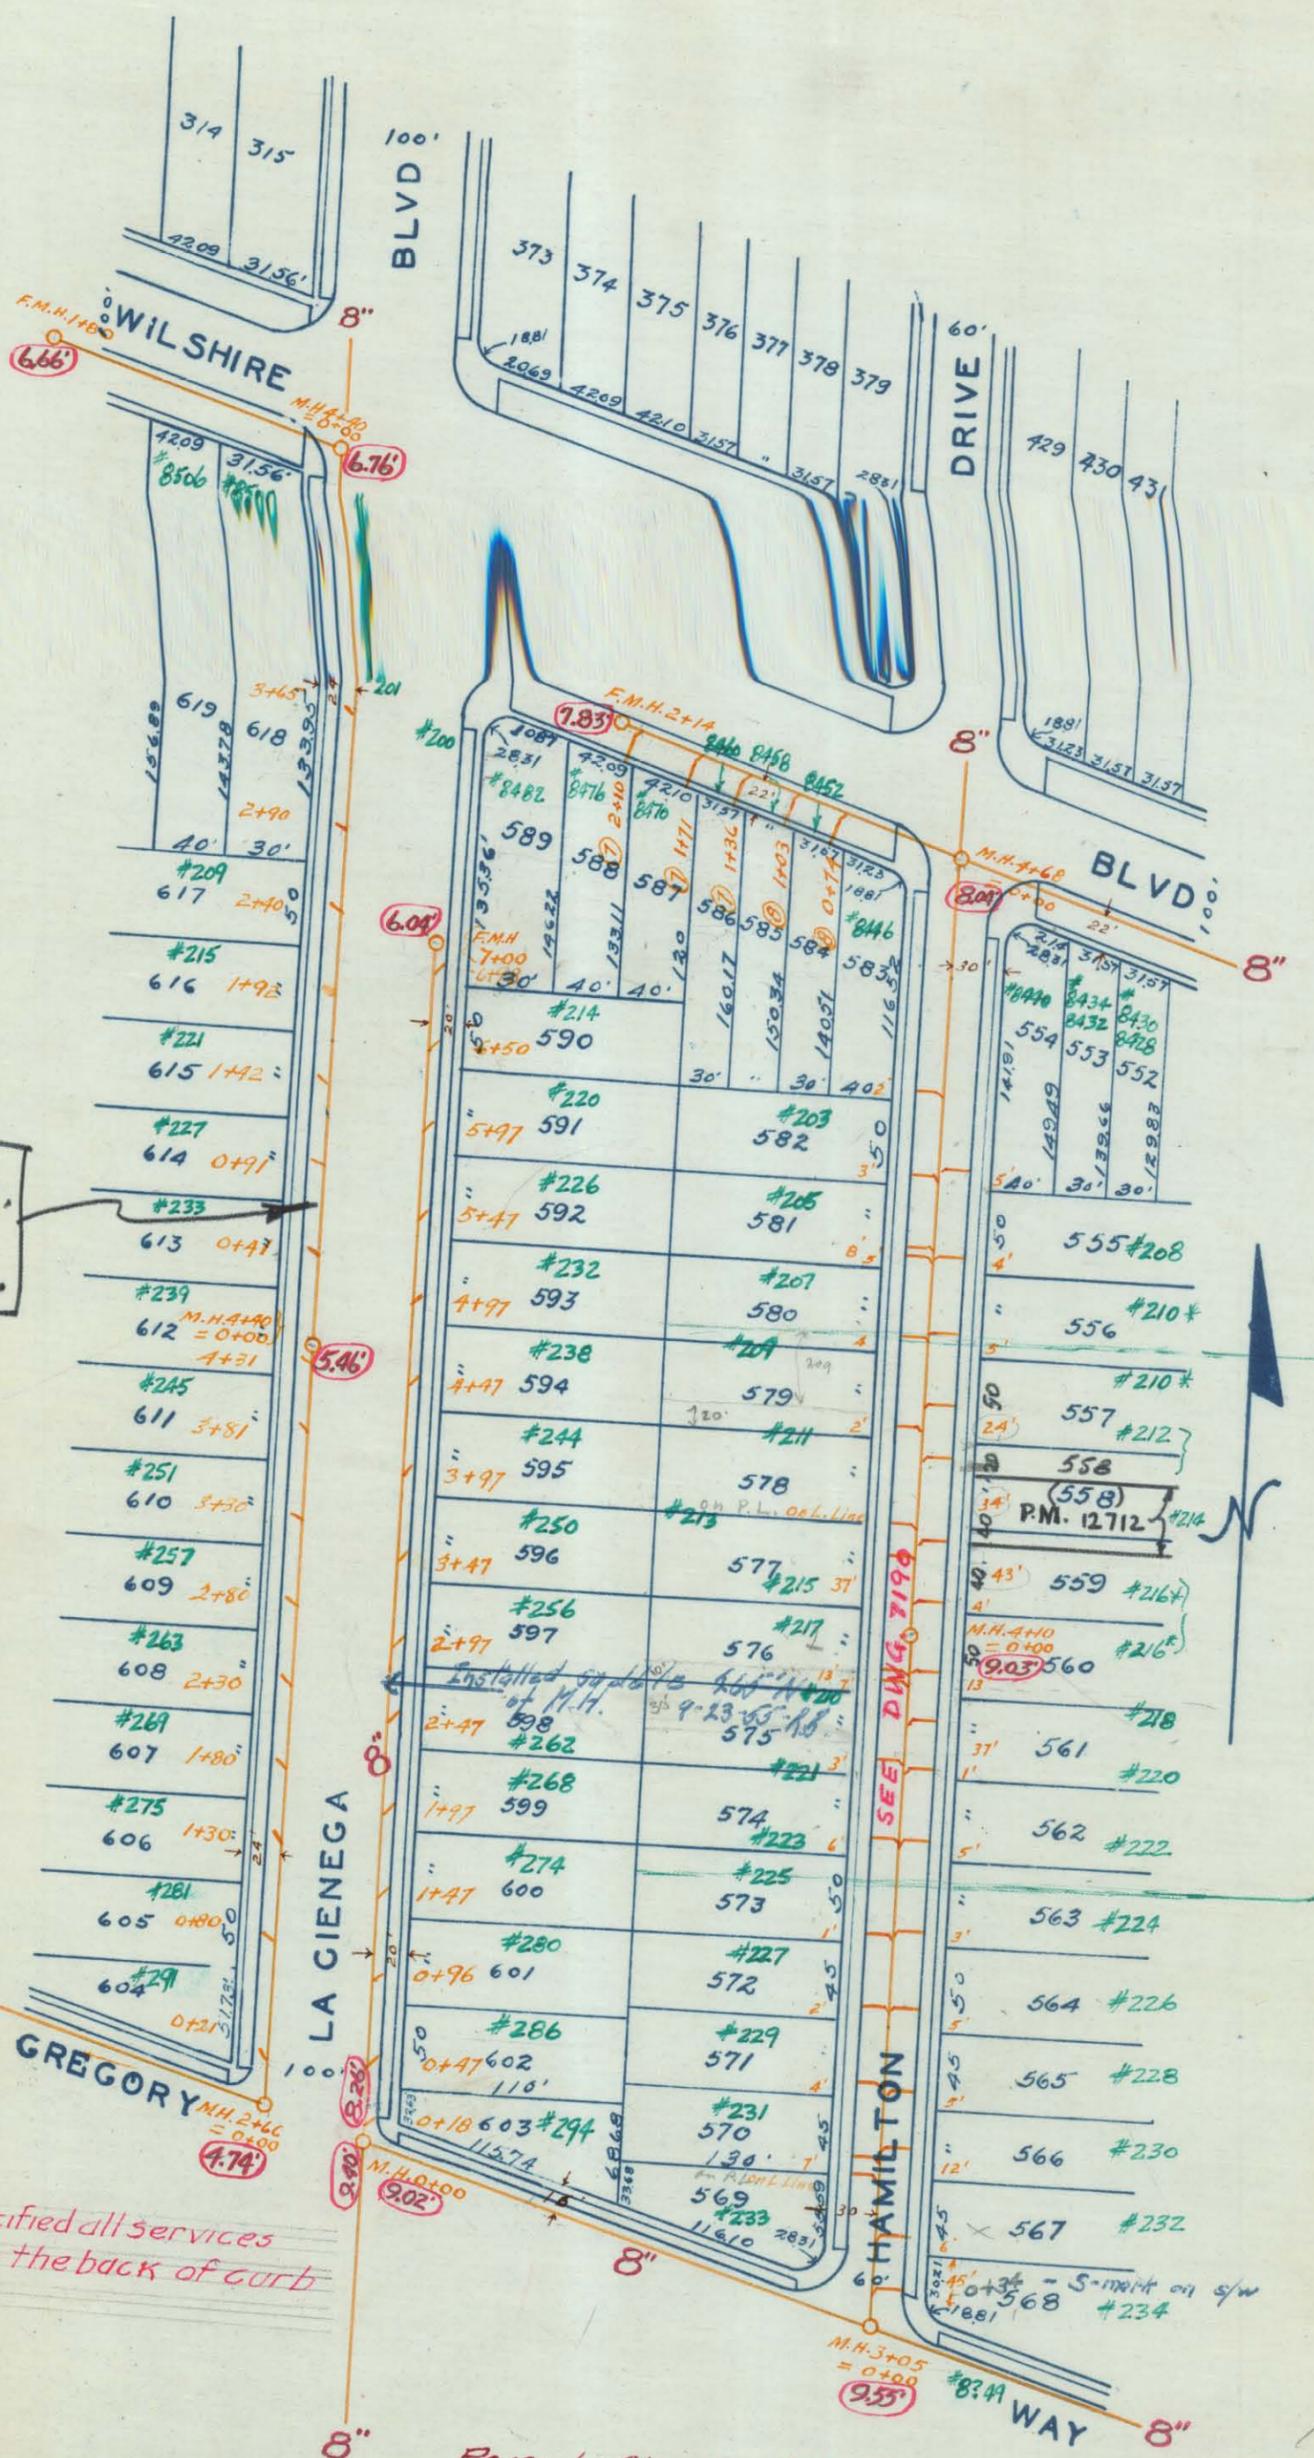

See Dwg. No. 7192

SEE MAP PANEL #0045

otherwise specified all services are brought to the back of curb 5' Deep.


Pave: La Cienega - 8" Concrete  
Hamilton - 3" A.C. + 2" Warrenite

CITY OF BEVERLY HILLS  
TRACT 4988 Lots 569 to 603  
M.B. 54-98-99  
SCALE 1"=100'

8" Sewer

99

Date 1925

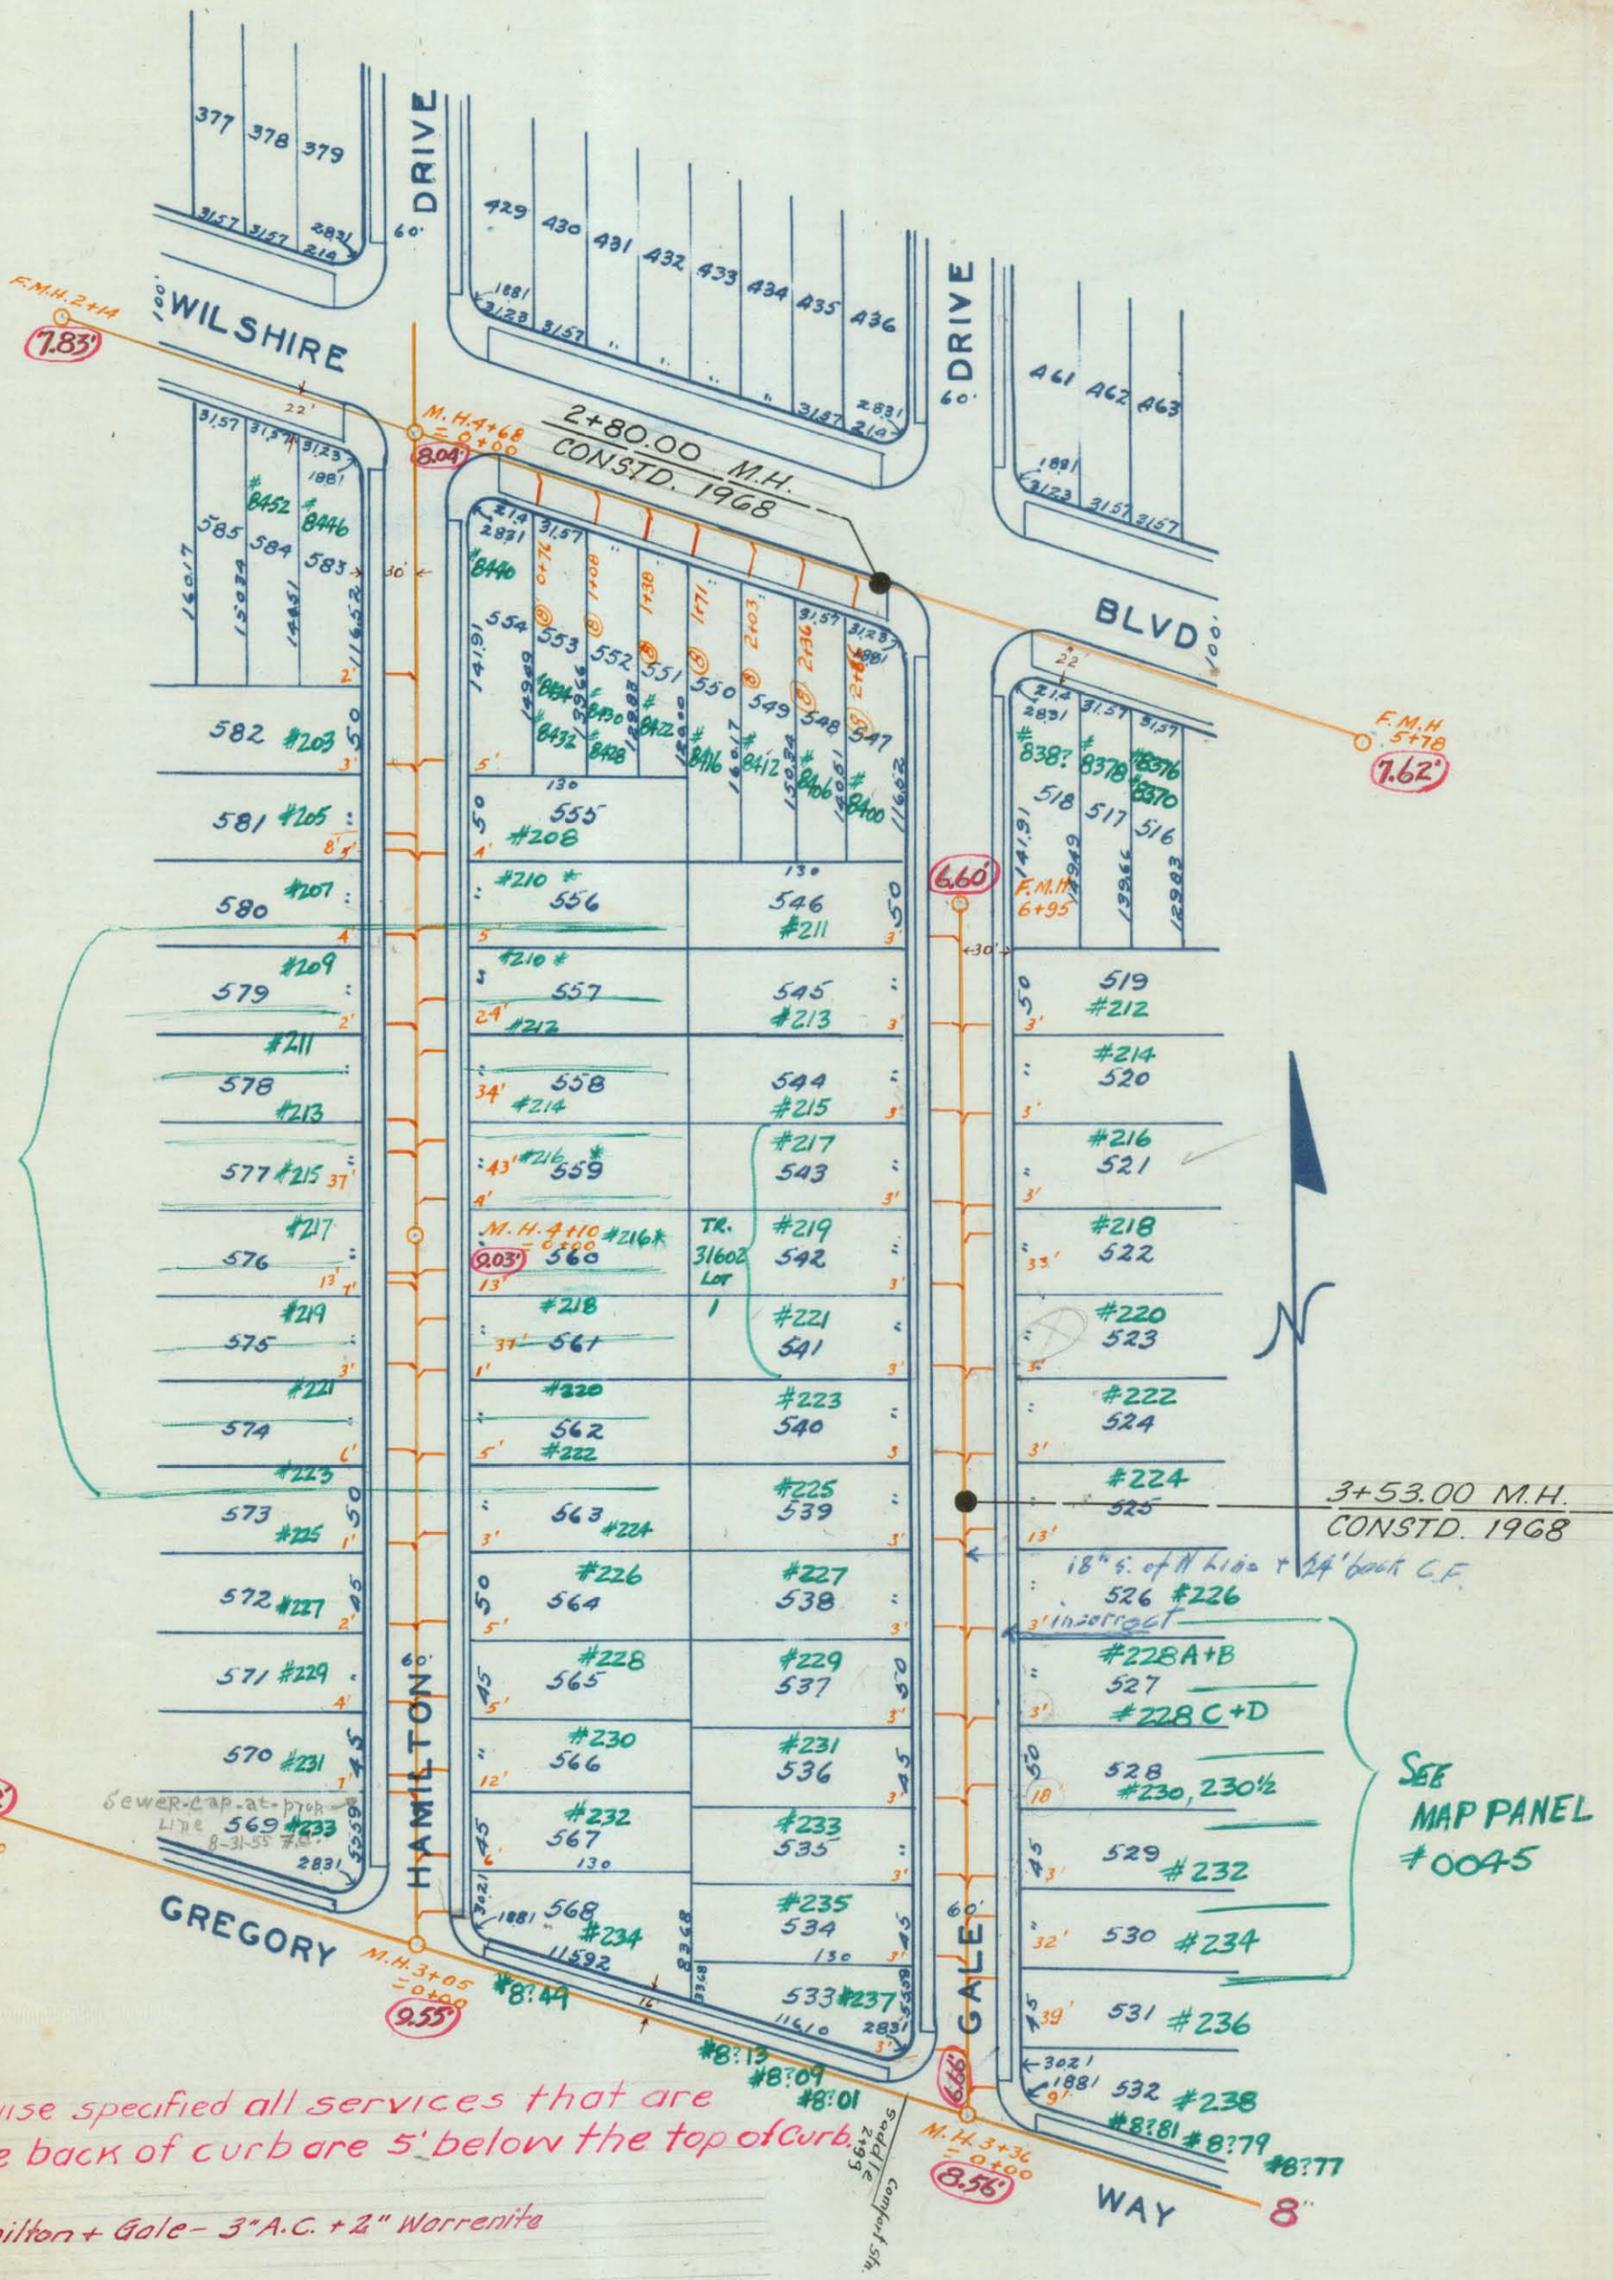

SEE  
MAP PANEL  
#0045

SEE  
MAP PANEL  
#0045

Unless otherwise specified all services that are brought to the back of curb are 5' below the top of curb.

Pave: Hamilton + Gale - 3" A.C. + 2" Warrenite


8" Sewer

**CITY OF BEVERLY HILLS**  
 TRACT 4988 Lots 533 to 568  
 M.B. 54-98-99  
 SCALE 1"=100'

100

Date 1975



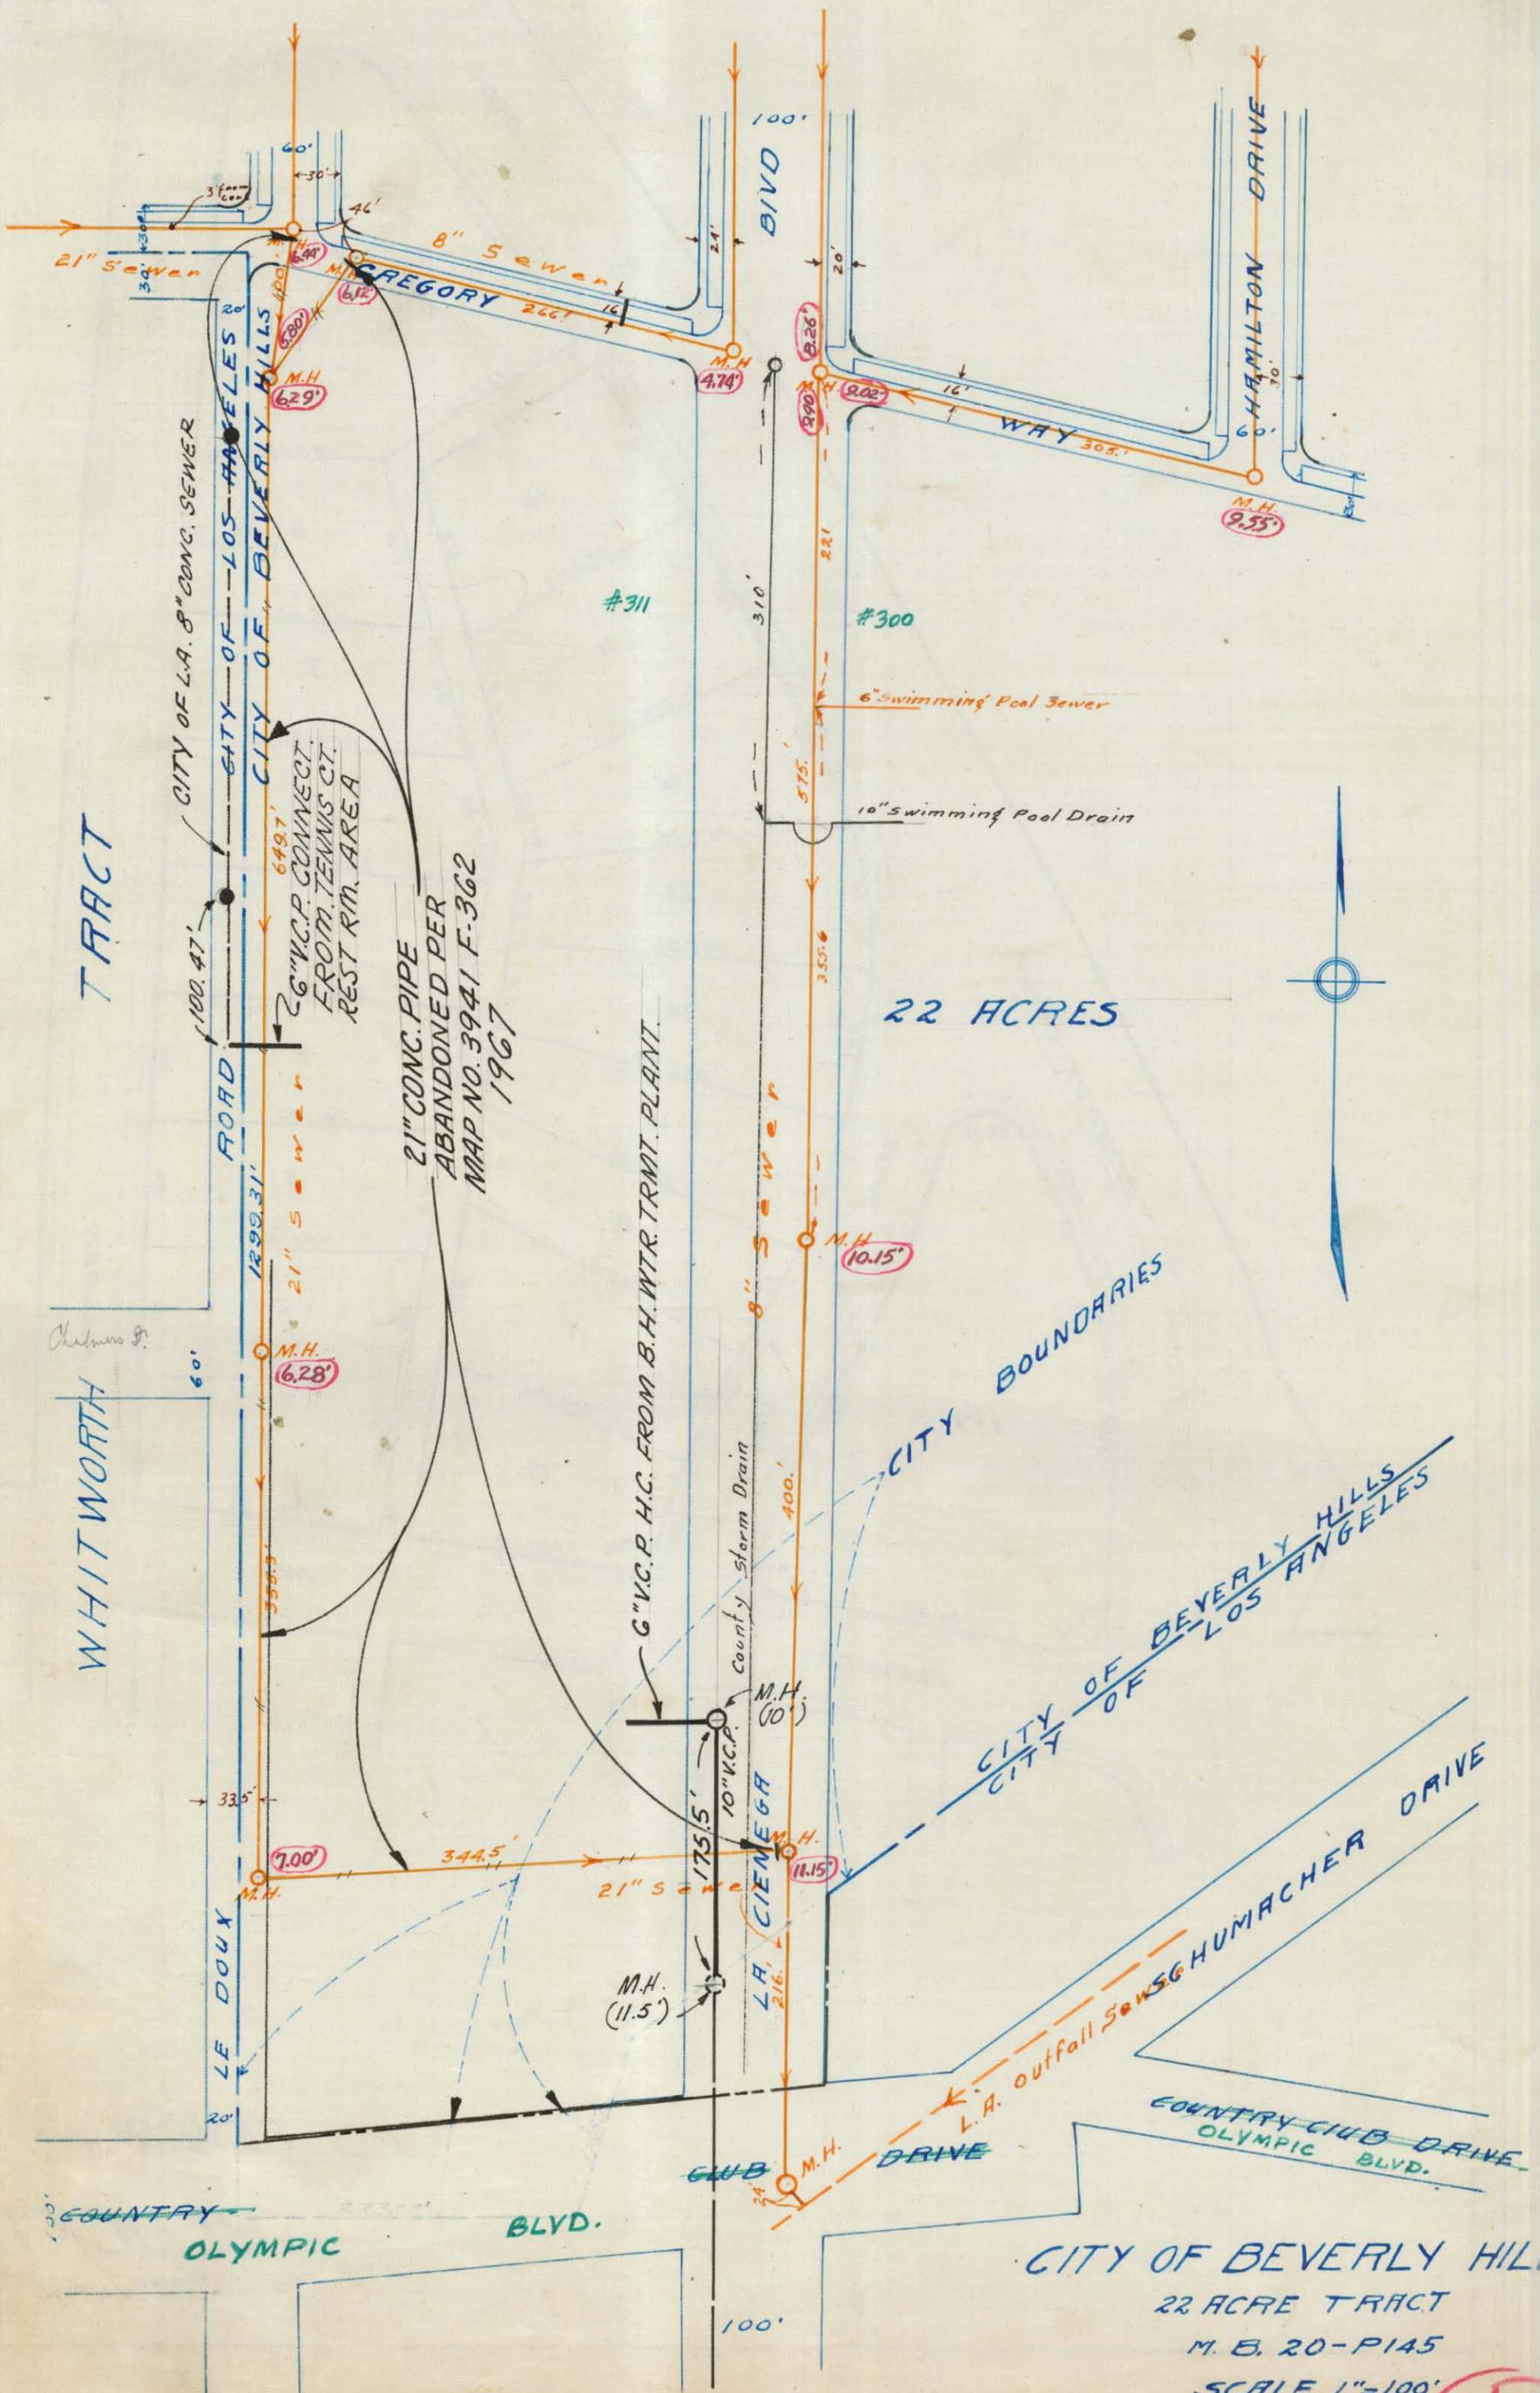

TRACT

WHITWORTH

CITY OF L.A. 8" CONC. SEWER  
 CITY OF LOS ANGELES  
 CITY OF BEVERLY HILLS  
 26" V.C.P. CONNECT FROM TENNIS CT. REST RM. AREA  
 21" CONC. PIPE ABANDONED PER MAP NO. 3941 F-362 1967

6" V.C.P. H.C. FROM B.H. WTR. TRMT. PLANT.

22 ACRES


CITY BOUNDARIES

CITY OF BEVERLY HILLS  
 CITY OF LOS ANGELES

CITY OF BEVERLY HILLS  
 22 ACRE TRACT  
 M. B. 20-PI45  
 SCALE 1"=100'

102

(PER BILL MOORHEAD  
4/9/85)  
FOR LATERAL TO  
ROXBURY PARK  
SEE  
DRAWG. 2055

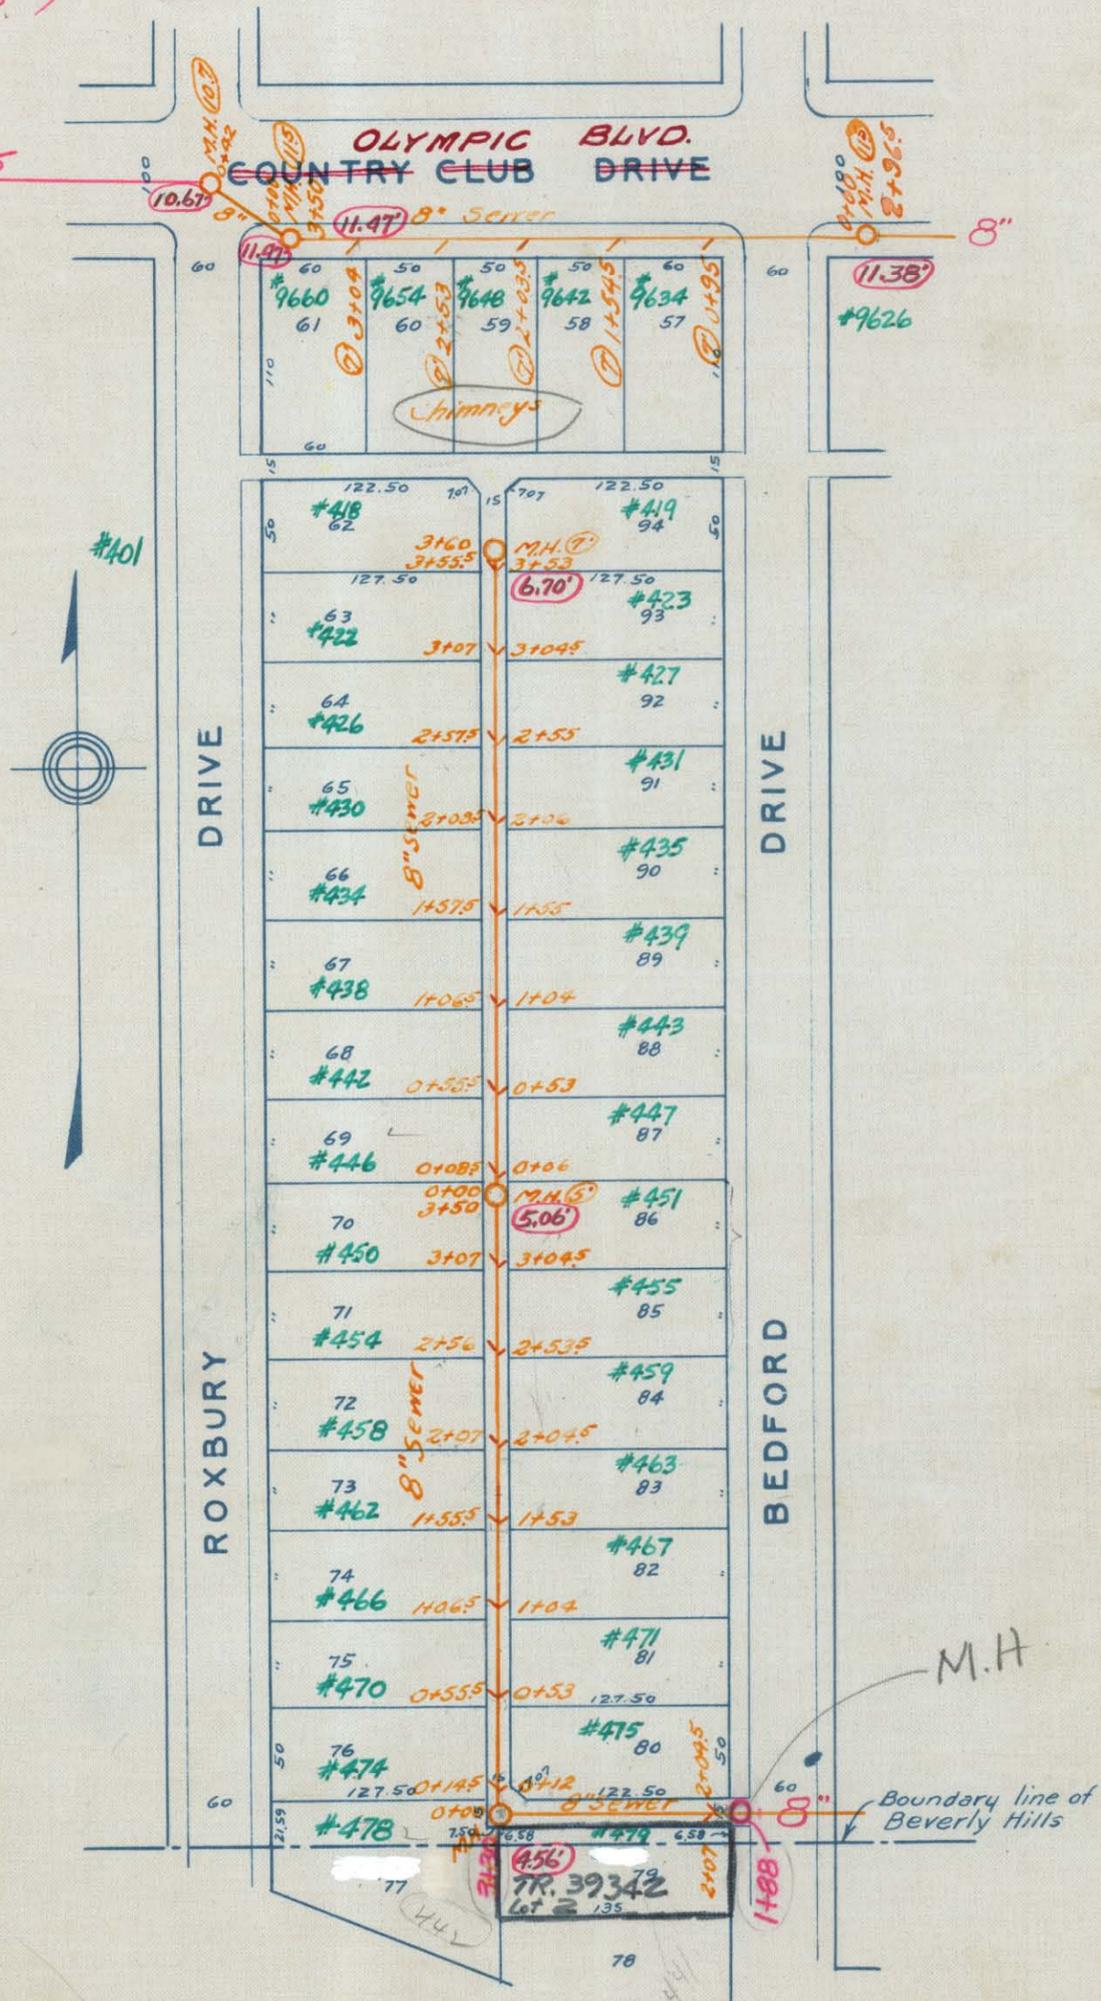


CITY OF BEVERLY HILLS

TRACT 3535

M.B. 107-2

SCALE: 1" = 100'

103

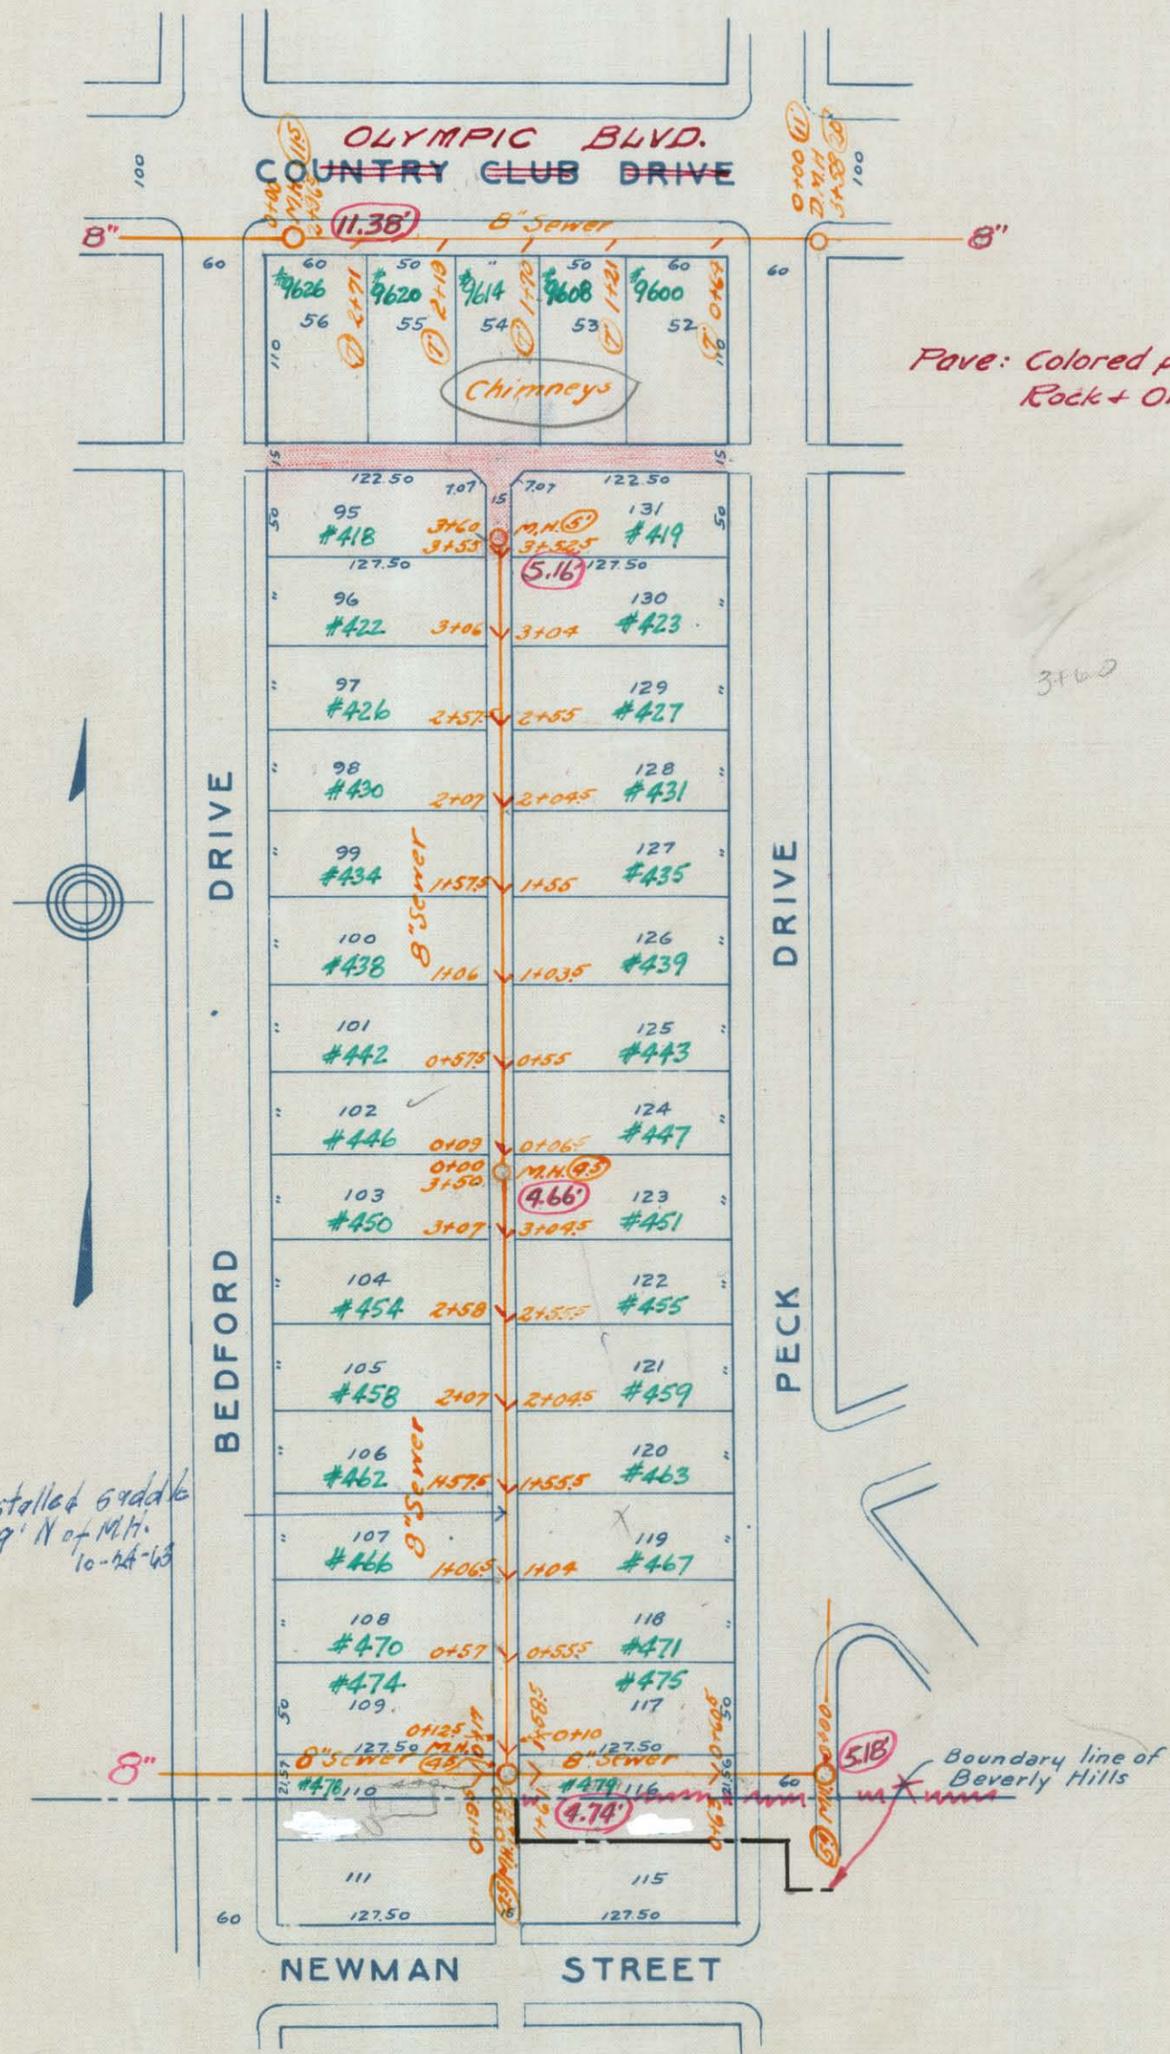


CITY OF BEVERLY HILLS

TRACT 3535

M.B. 107-2

SCALE: 1" = 100'

104

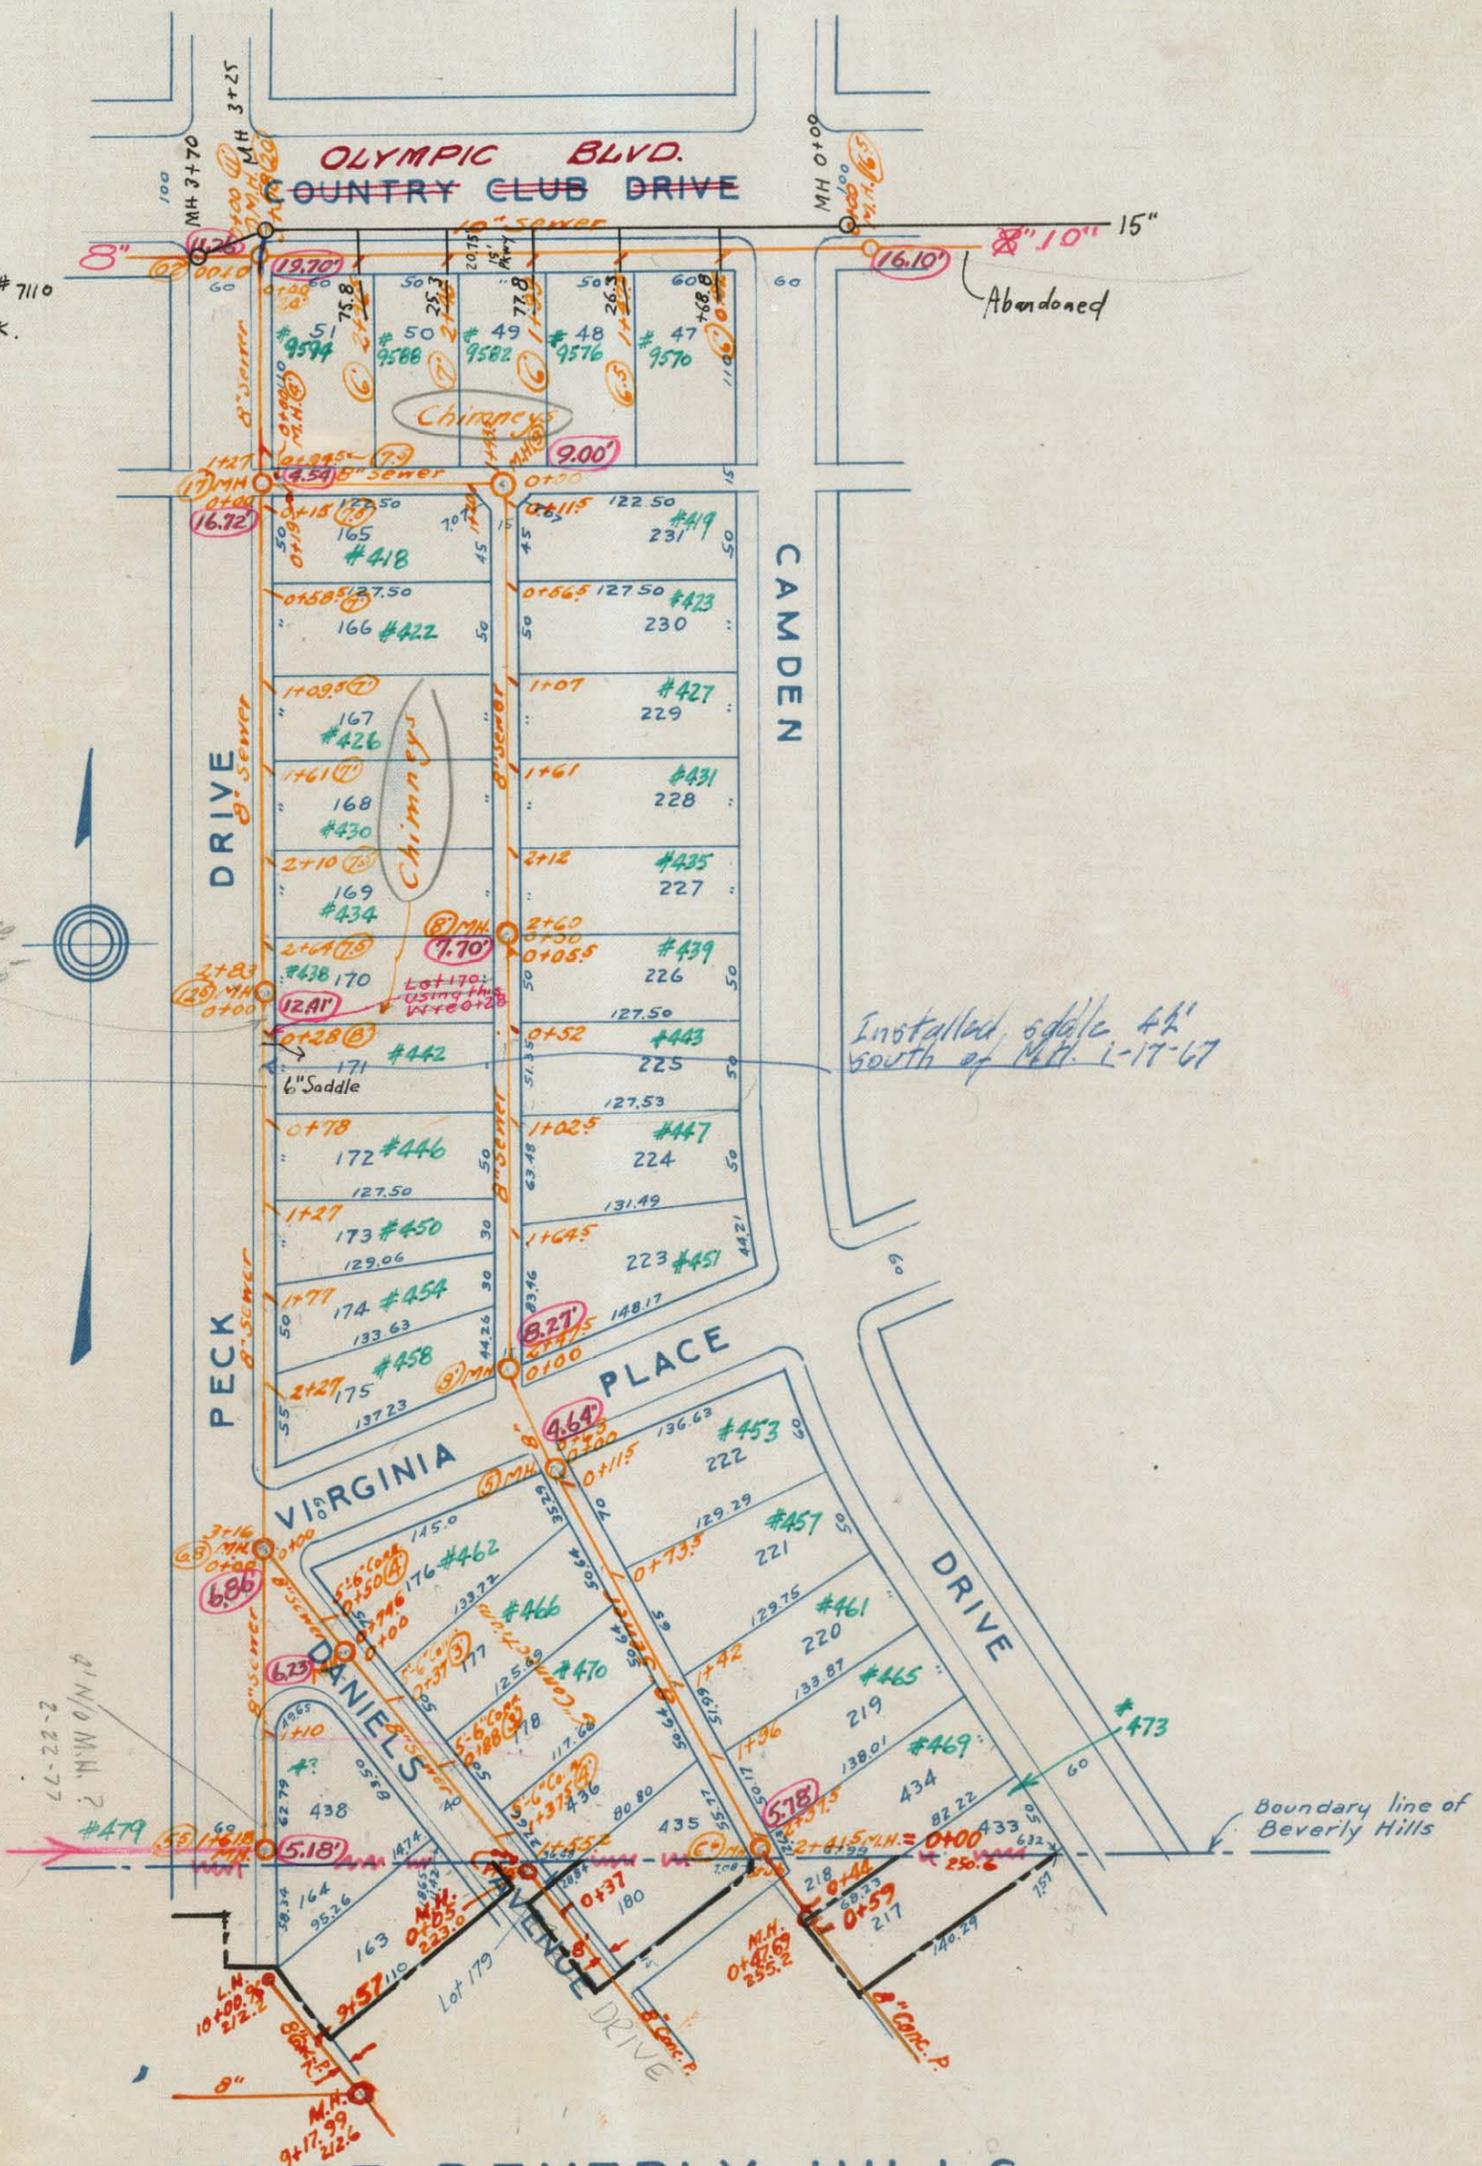

Rev. per Dwg # 7110  
6-8-73 P.K.

0123  
Saddle in use  
Lot 170 4-24-46

Permit 3385  
1-2-40 B.M.  
29.5' S. of M.H.


66-22-2  
2' M.H. 0/1/1/0

Boundary line of Beverly Hills

CITY OF BEVERLY HILLS

TRACT 3535  
M. B. 107 - 3  
SCALE: 1" = 100'

Rev. per Dwg #7110  
6-8-73 P.K.

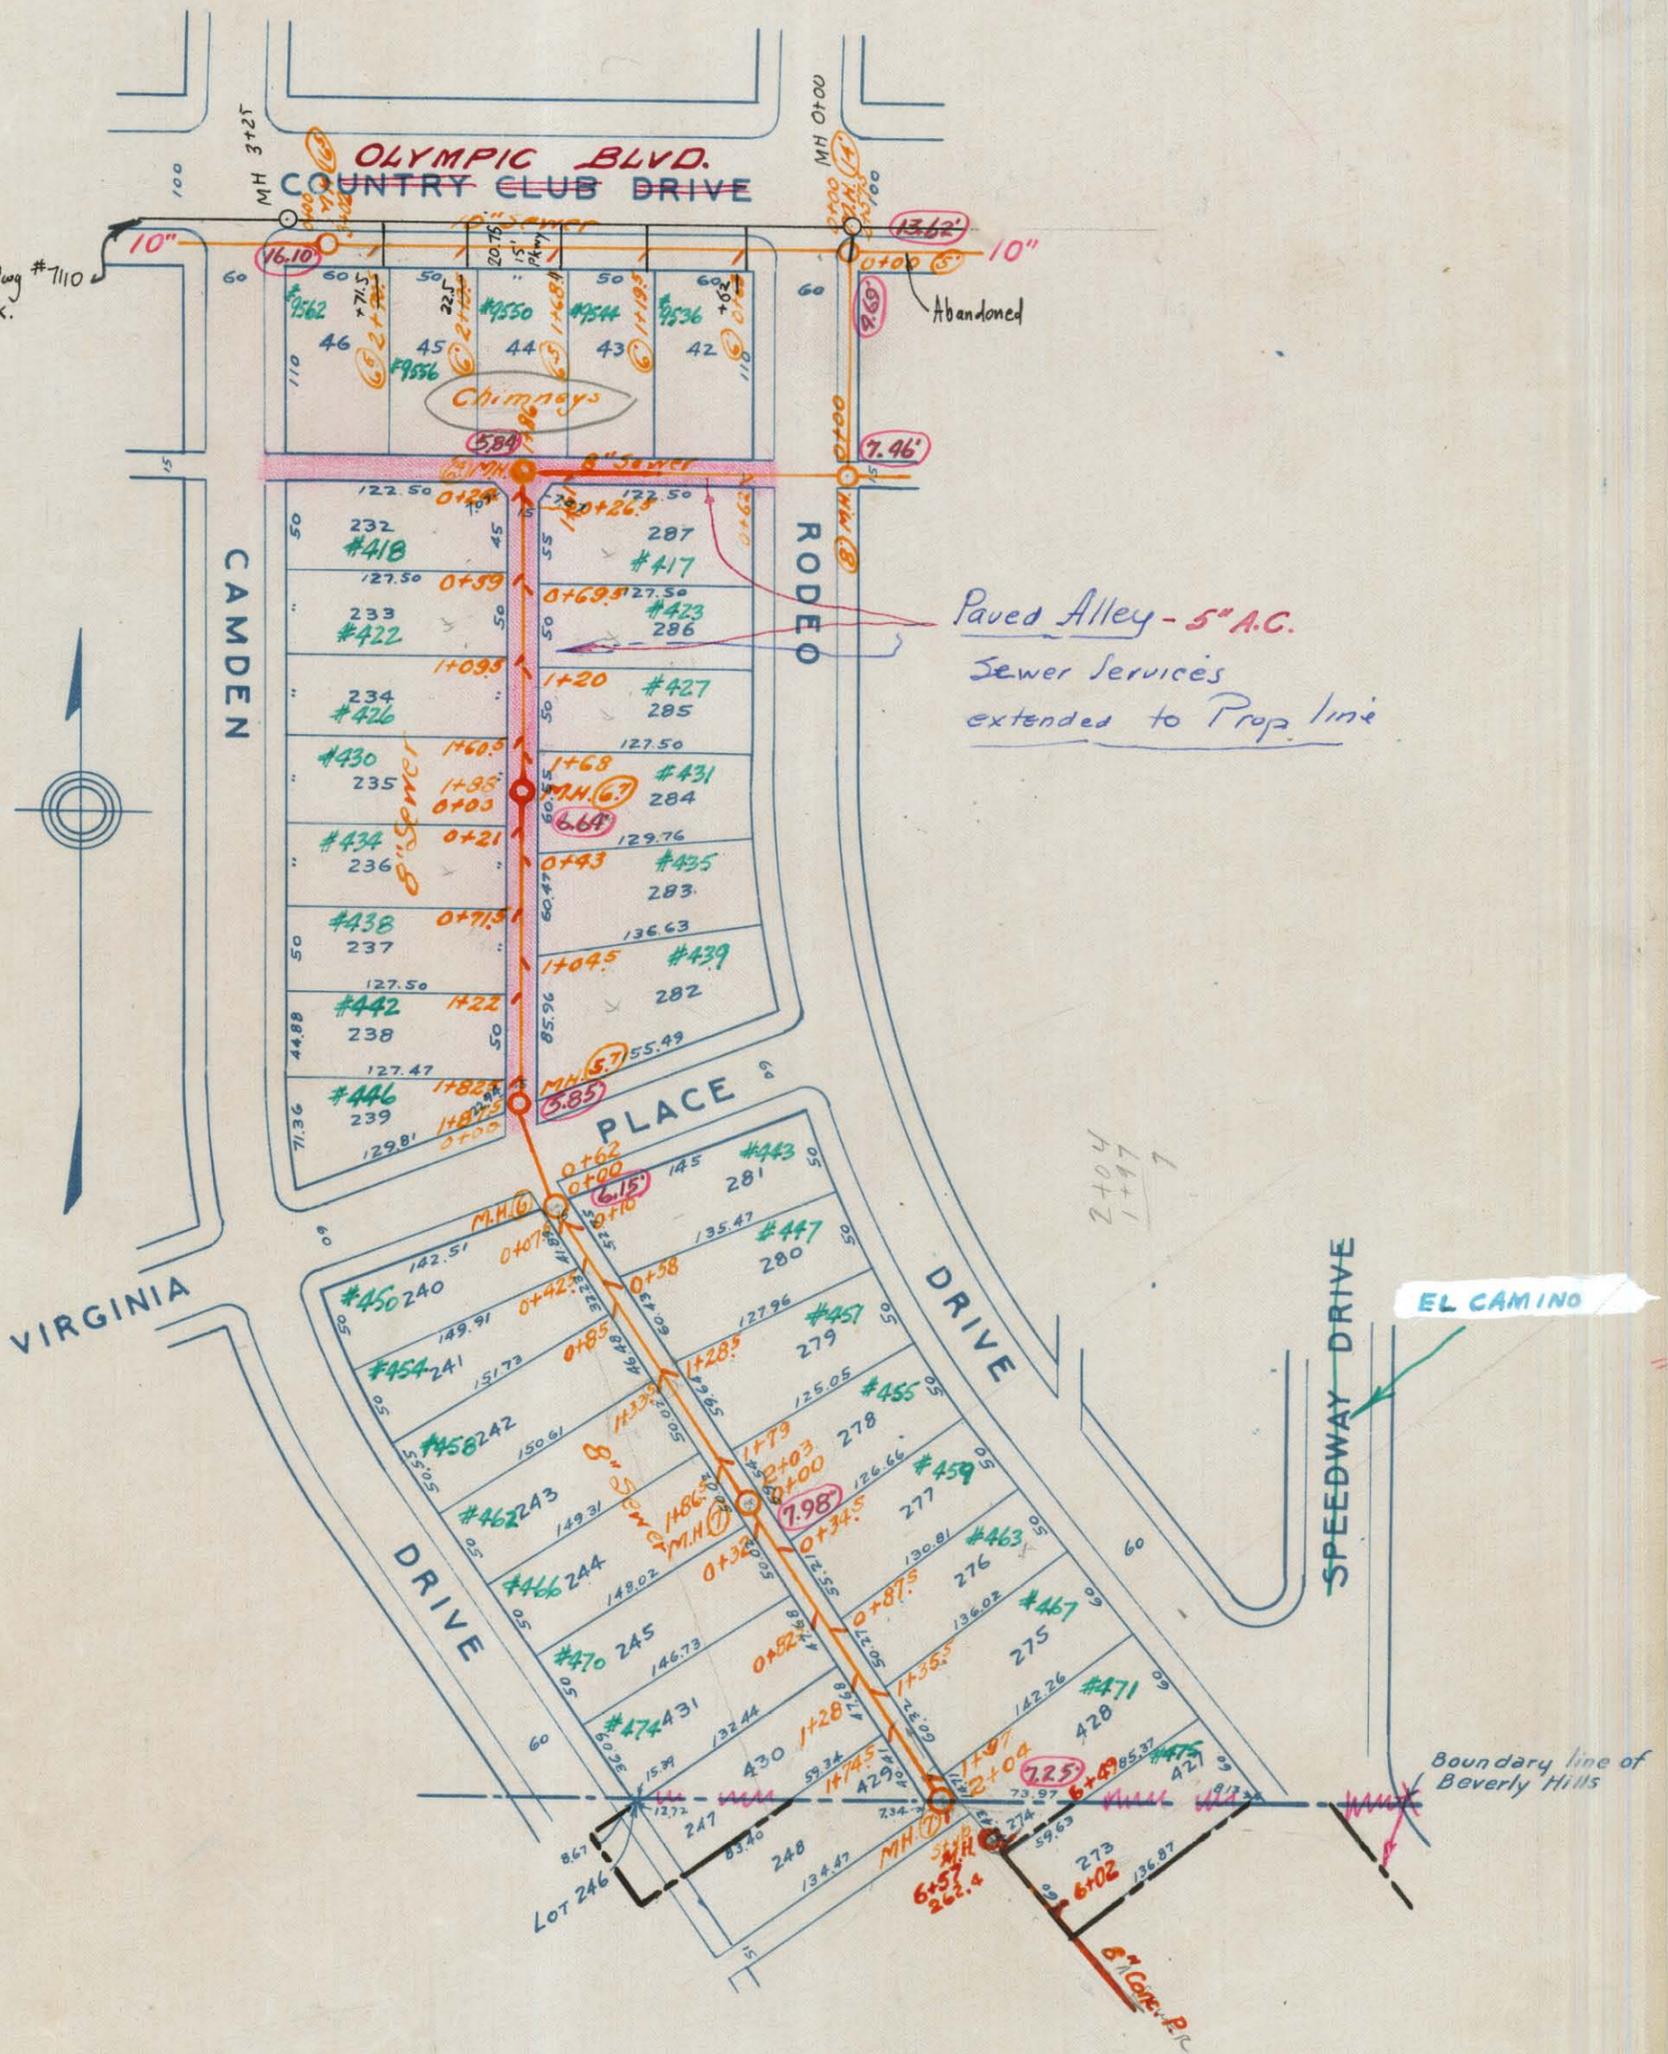

# CITY OF BEVERLY HILLS

TRACT 3535



M.B. 107-3-4

SCALE: 1" = 100'

106




Rev. per Dwg #7110  
6-8-73 PK.

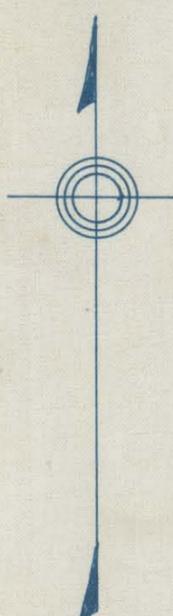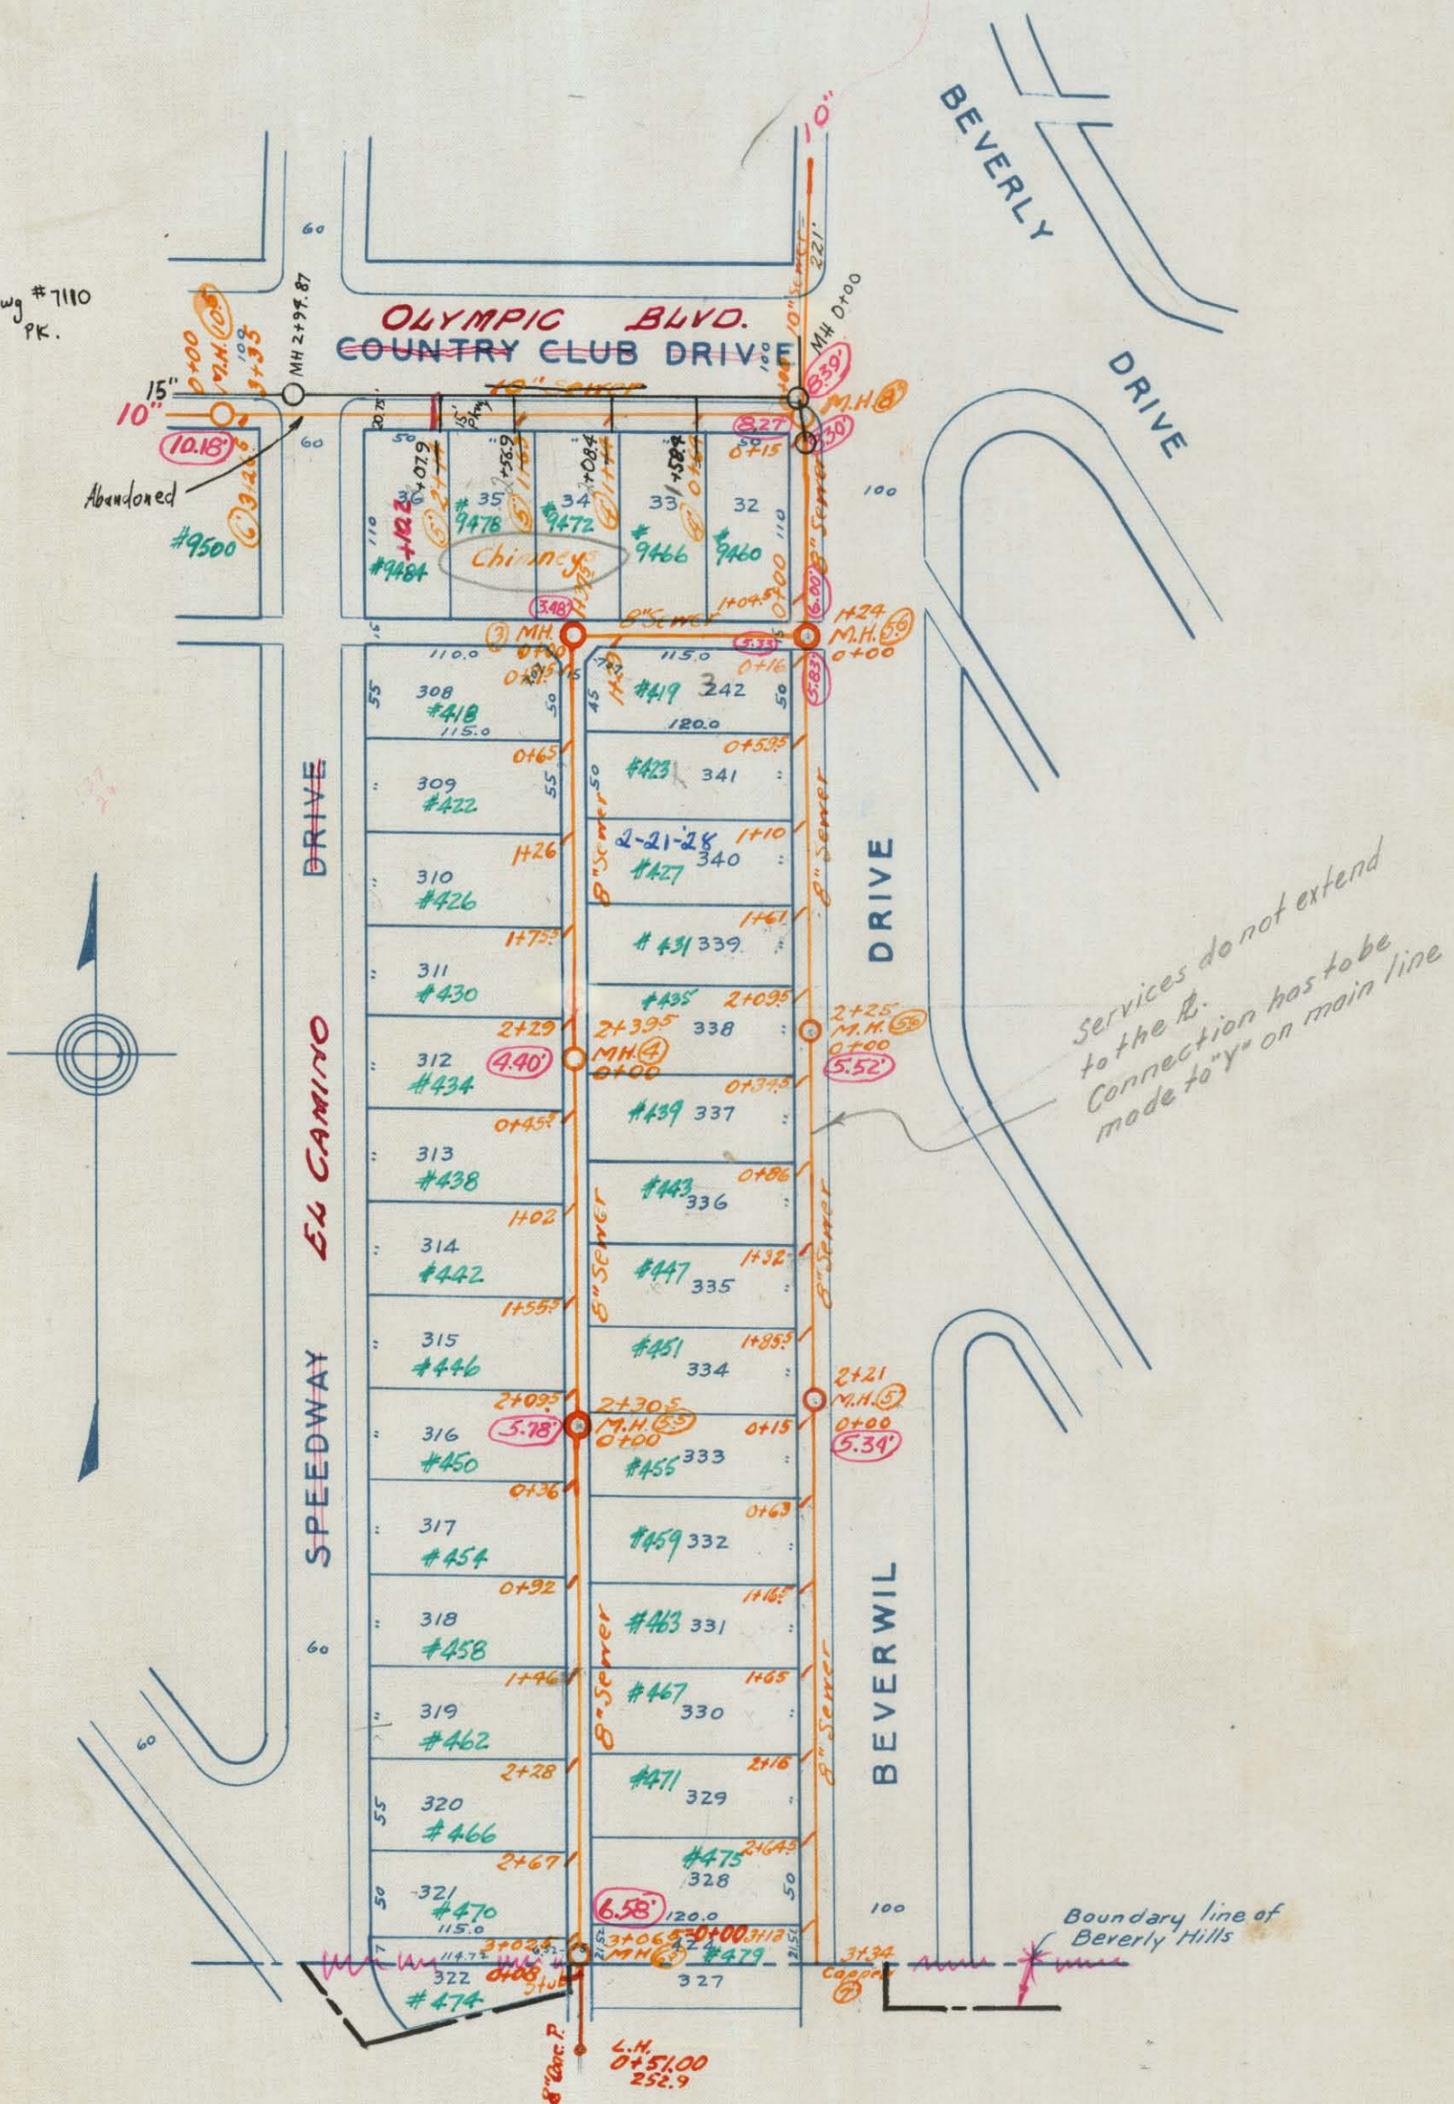

CITY OF BEVERLY HILLS  
TRACT 3535  
M. B. 107-4  
SCALE: 1" = 100'

108

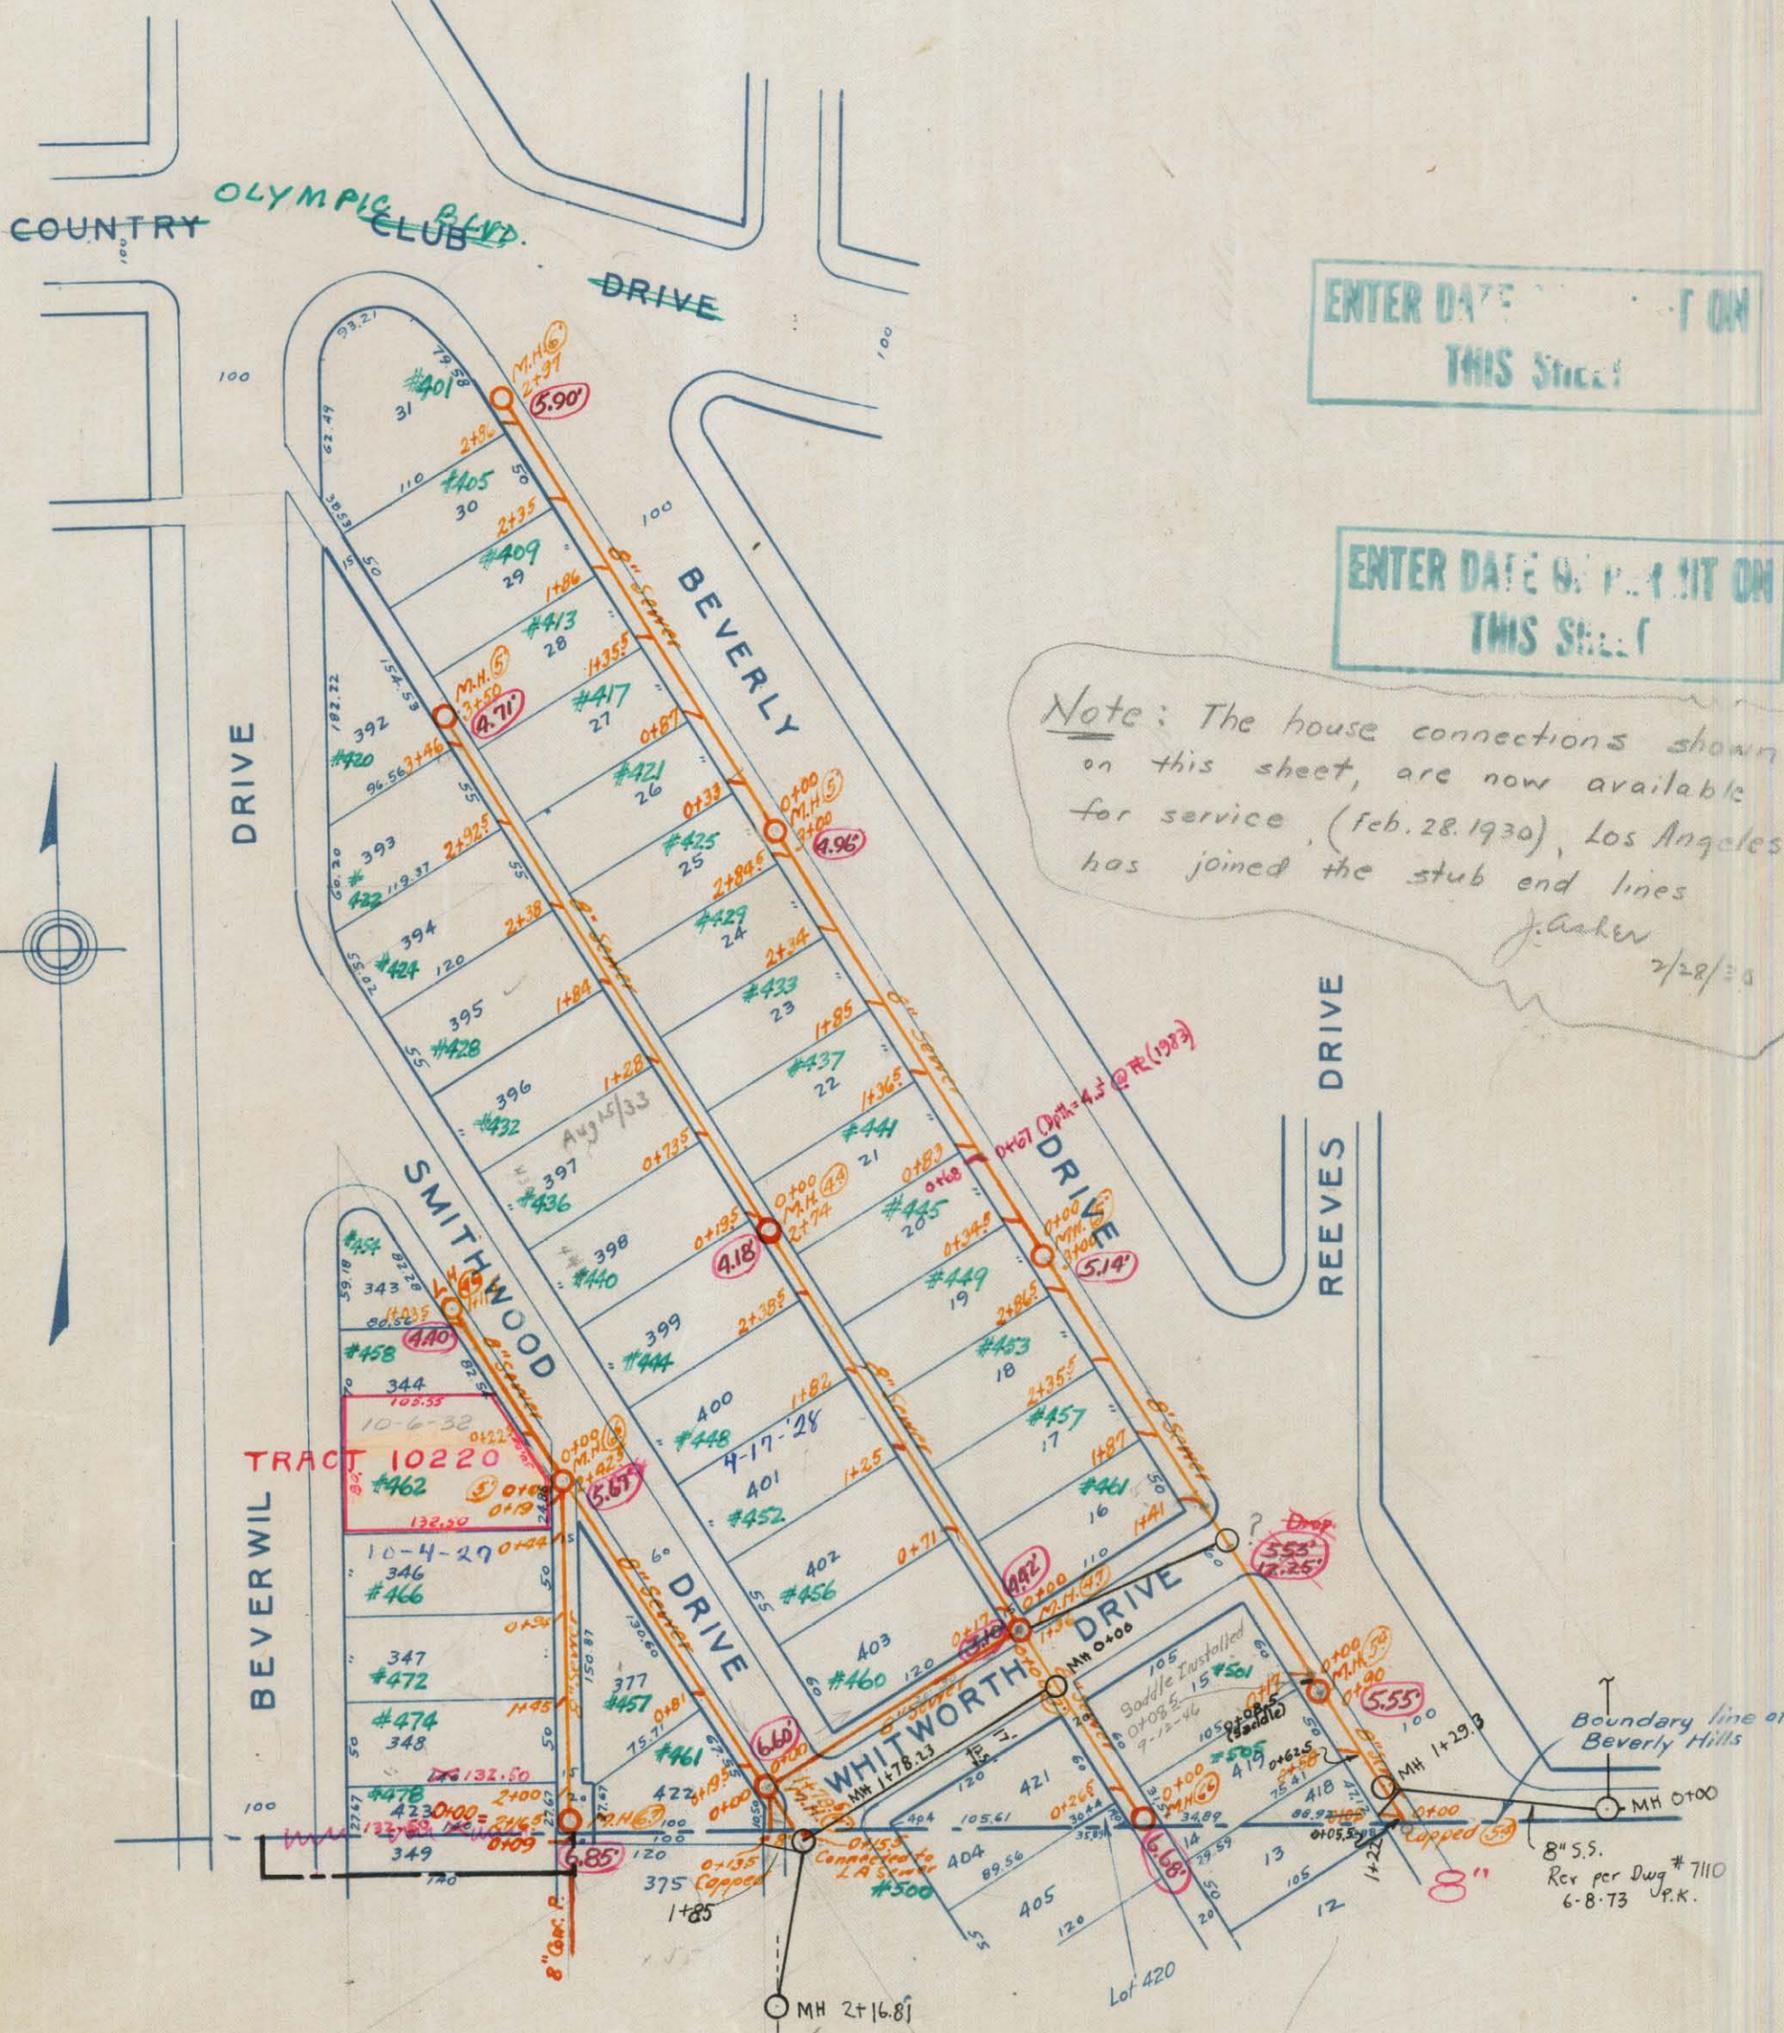

ENTER DATE OF PERMIT ON THIS SHEET

ENTER DATE OF PERMIT ON THIS SHEET

Note: The house connections shown on this sheet, are now available for service, (Feb. 28, 1930), Los Angeles has joined the stub end lines  
*J. Baker* 2/28/30

CITY OF BEVERLY HILLS

TRACT 3535  
 M.B. 107-5  
 SCALE: 1"=100'

ENTER DATE OF PERMIT ON THIS SHEET

109


8" S.S.  
 Rev per Dwg # 7110  
 6-8-73 J.P.K.

OLYMPIC

BOULEVARD

AVE

L.A.

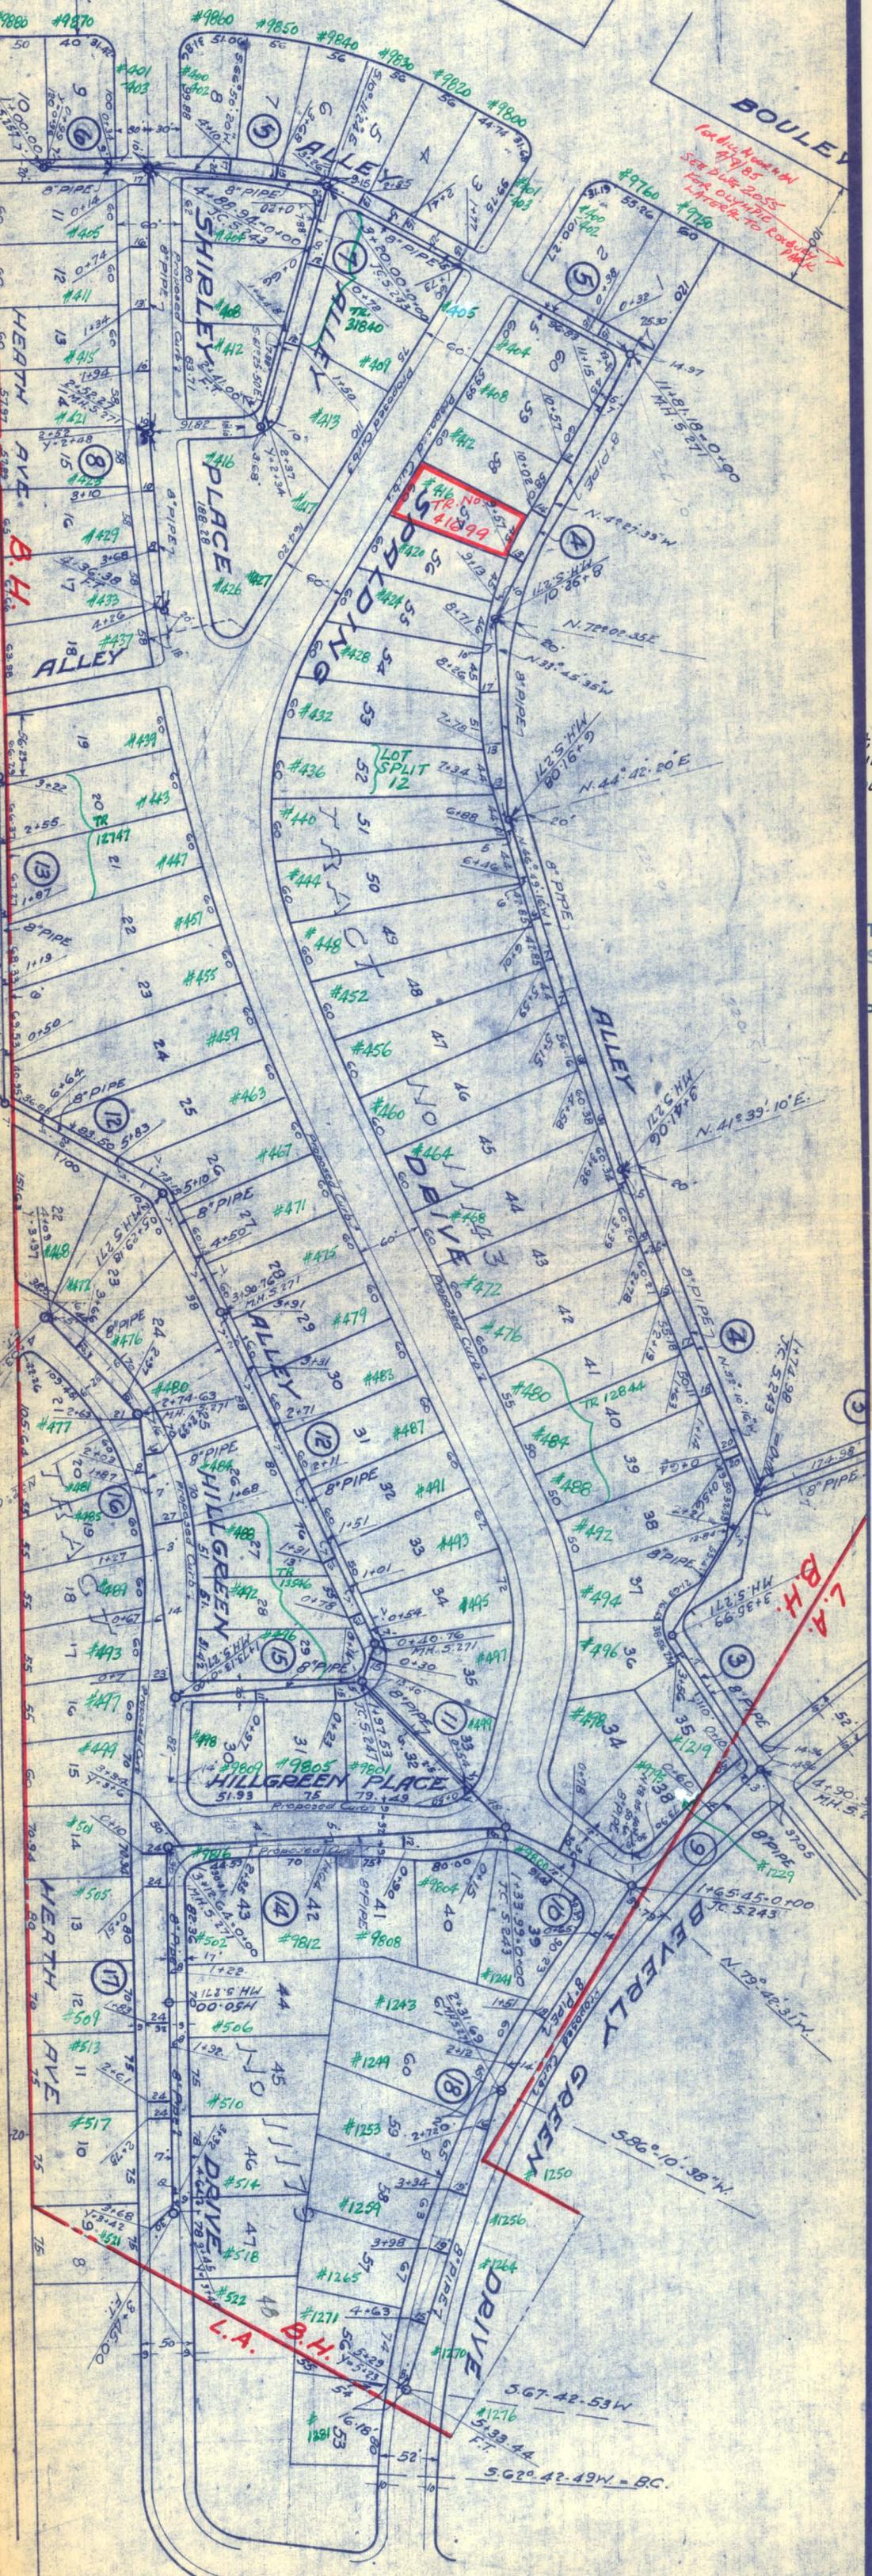


56 TRACT 11106 SECTION AVAILABLE. DLE-

SHOWN ON TO THE STREETS & LINES IN PTH OF +OR- 5'

109A  
110

TRACT 11179

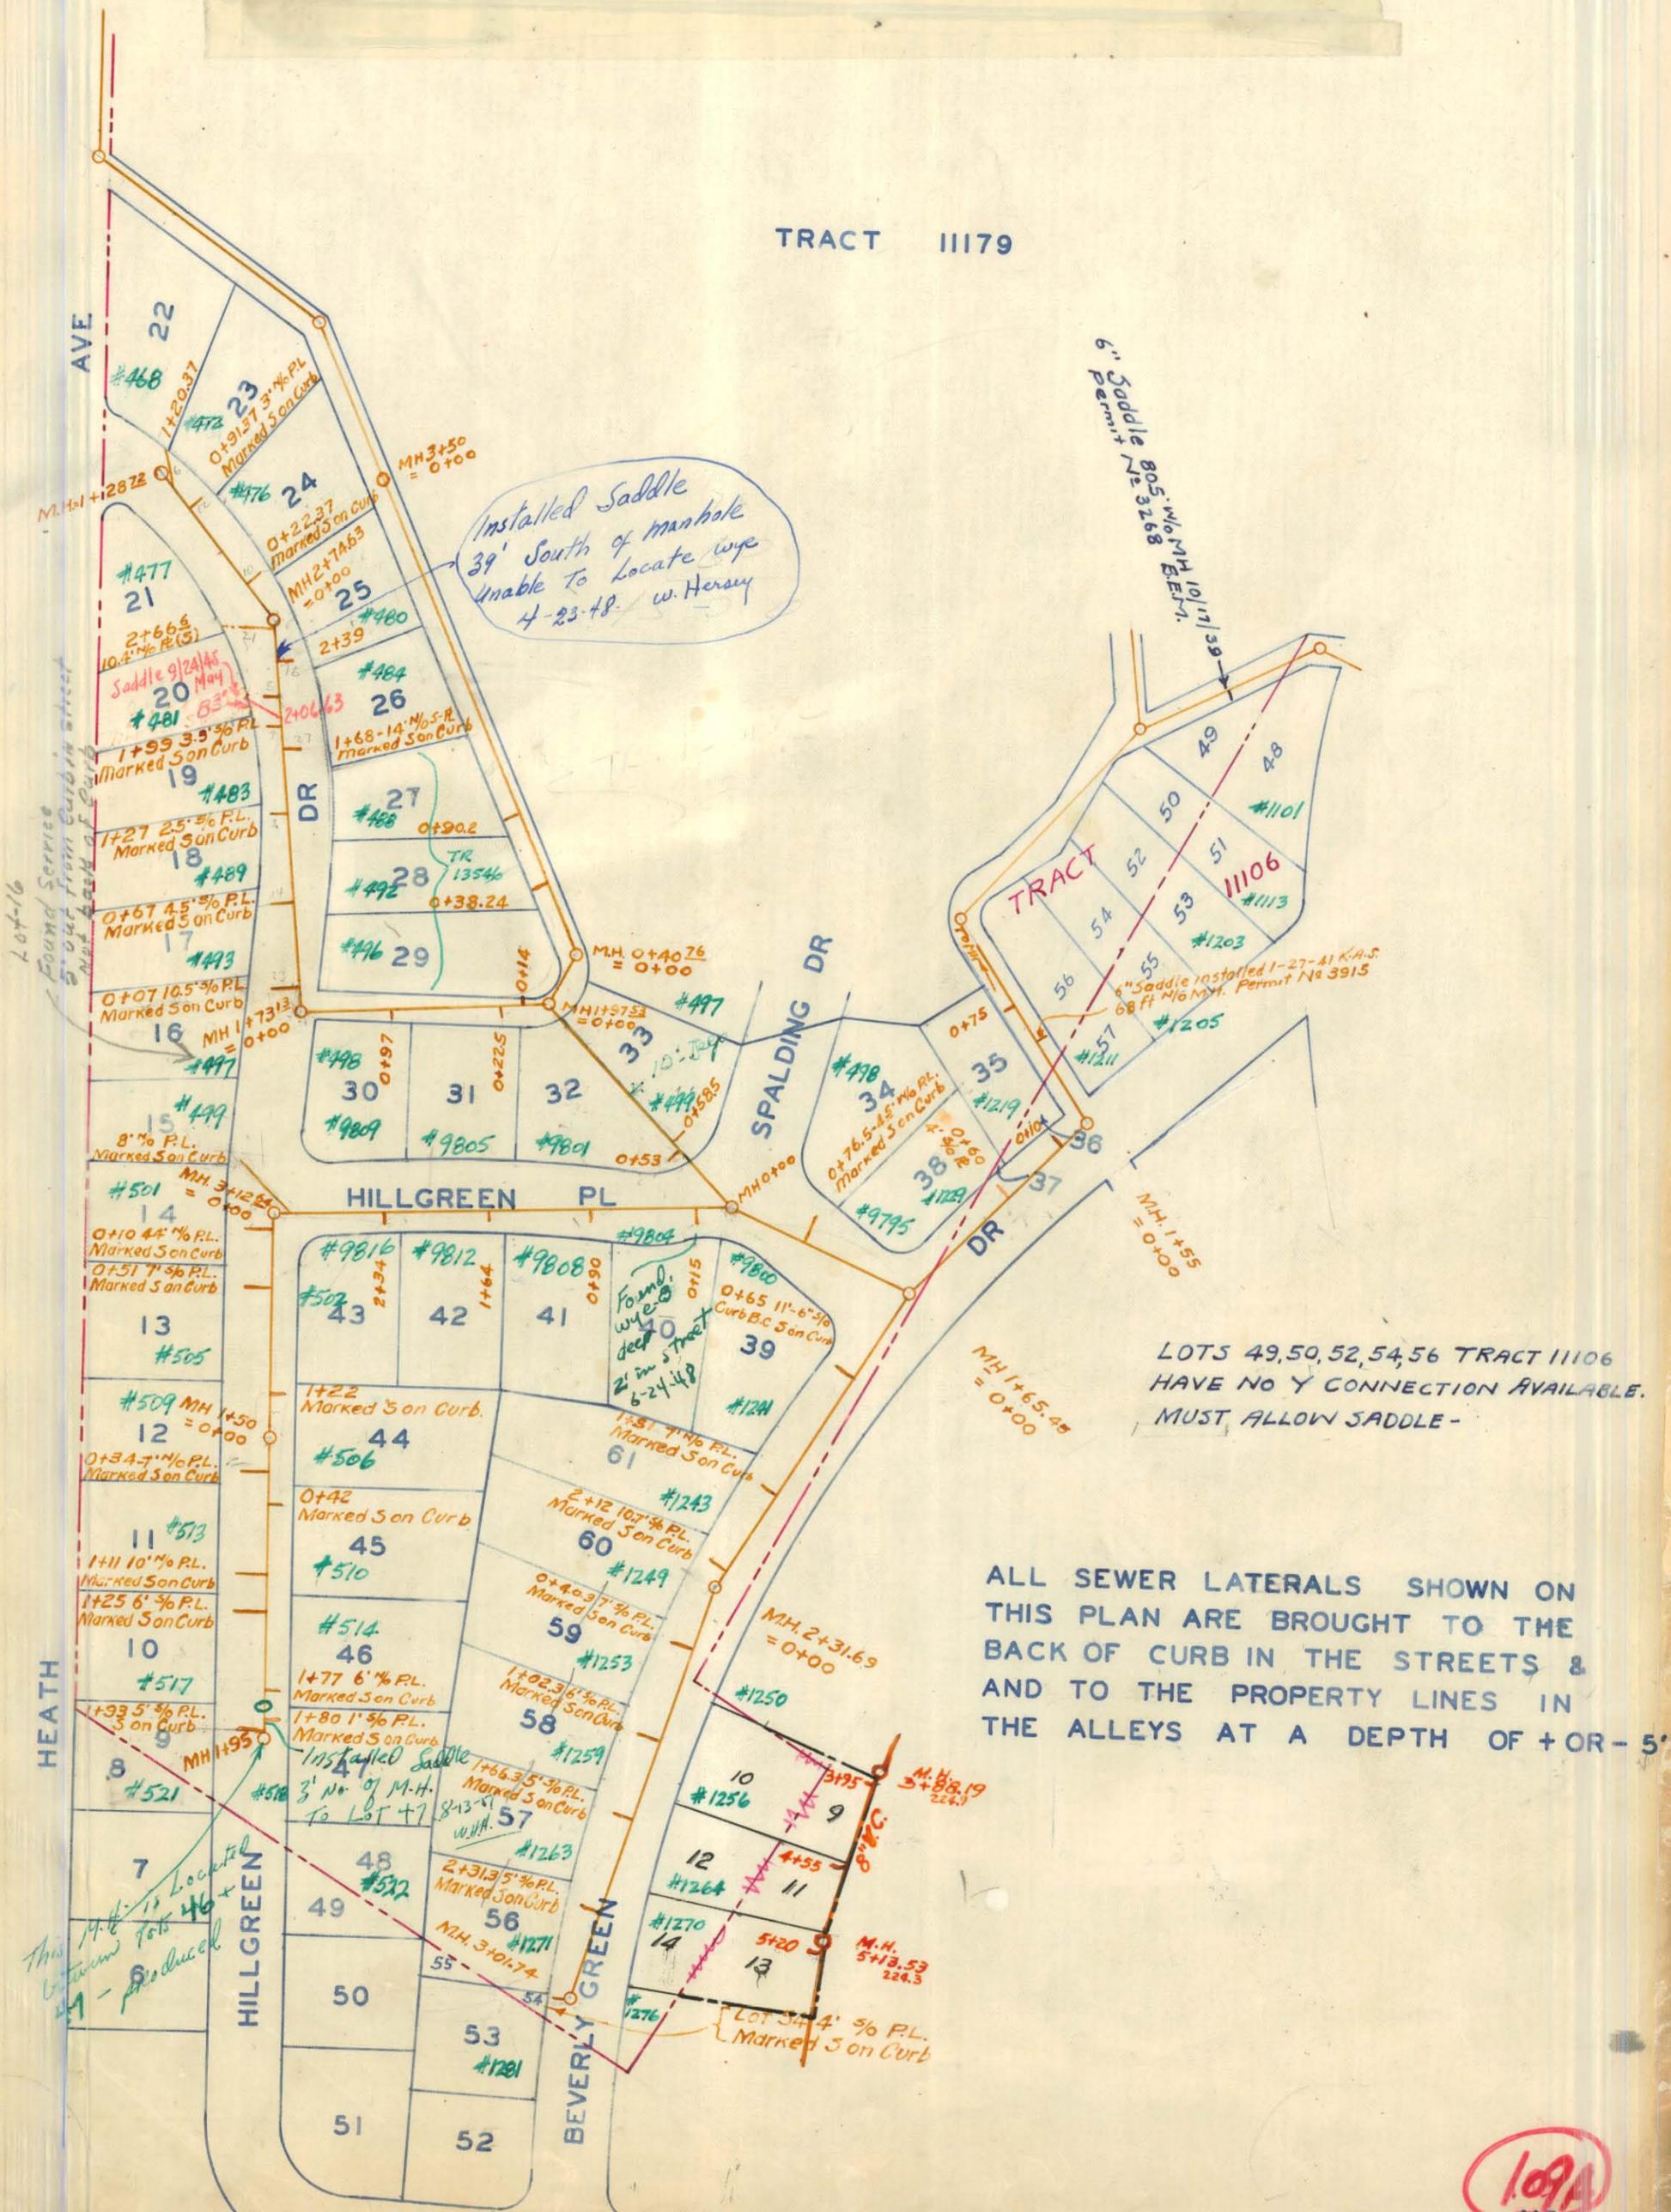

Installed Saddle  
39' South of manhole  
Unable to locate wye  
4-23-48 w. Hershey

6" Saddle 805' No. M.H. 10/17/39  
Permit No. 3268

6" Saddle installed 1-27-41 K.A.S.  
68 ft No. M.H. Permit No. 3915

LOTS 49, 50, 52, 54, 56 TRACT 11106  
HAVE NO Y CONNECTION AVAILABLE.  
MUST ALLOW SADDLE-

ALL SEWER LATERALS SHOWN ON  
THIS PLAN ARE BROUGHT TO THE  
BACK OF CURB IN THE STREETS &  
AND TO THE PROPERTY LINES IN  
THE ALLEYS AT A DEPTH OF +OR- 5'

Lot-16

Found Service  
Pipe out from curb in street  
out back of curb

HEATH

This M.H. is located  
between lots 46 &  
47 - produced

